


PARENT PARCEL: 07-00-016-104-180



CHILD PARCEL: 07-00-016-104-184, -185

STARTING POINT: INTERSECTION OF C/L OF CENTER RIDGE RD. AND C/L OF JAYCOX RD.

14-00592

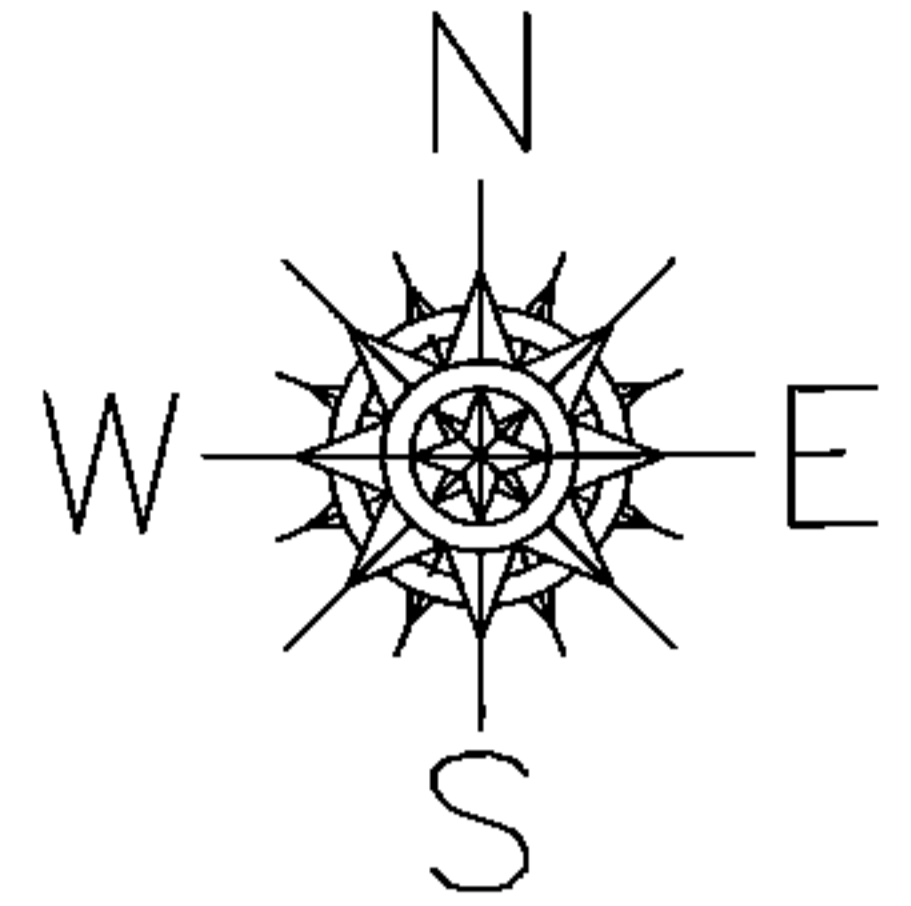

LOR-20-22.13  
126-WDV

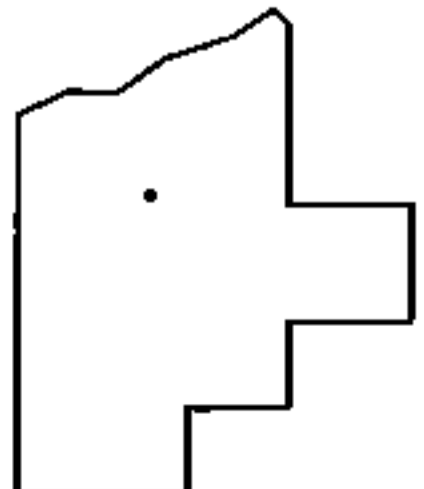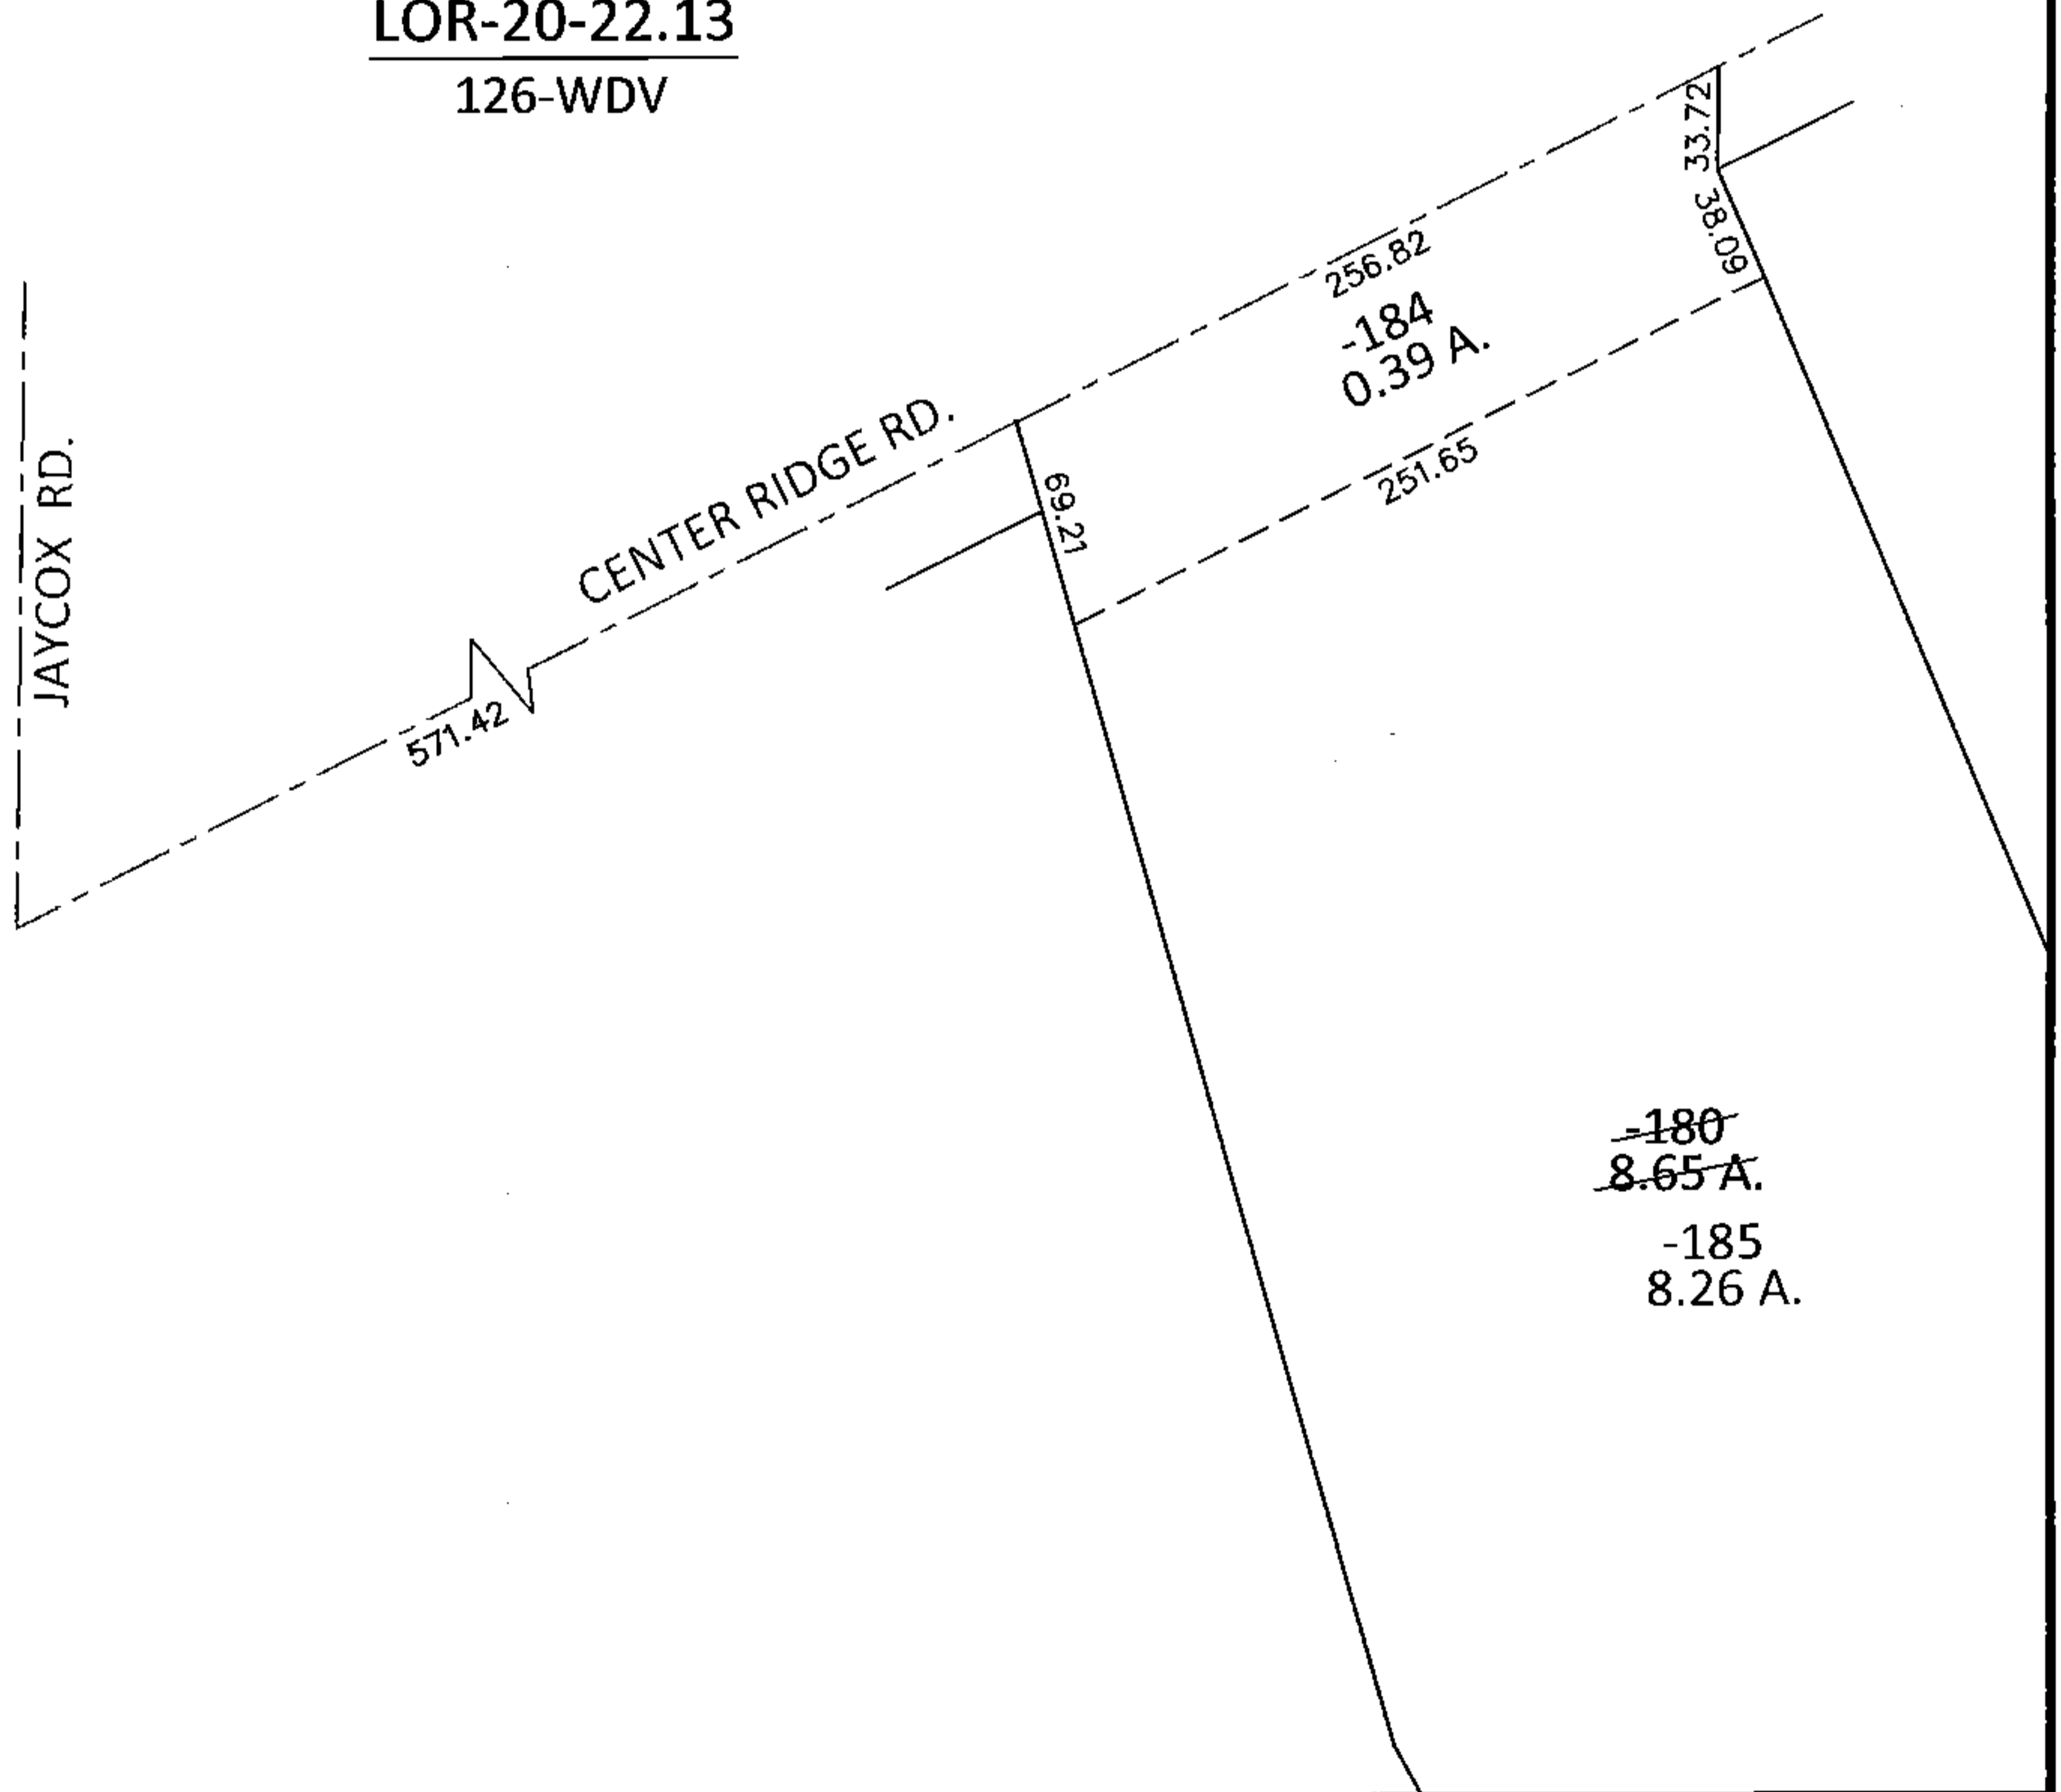

SPLITS/DEEDS PROCESSED

LORAIN COUNTY TAX MAP DEPARTMENT  
226 MIDDLE AVE. ELYRIA, OHIO

SURVEYED BY: WILLIAM D. THOMAS

CLOSURE: .00:10,000

MAP PAGE(S): 7-00-016-A

APPROVED BY: RRM DATE: 10-2-14

SCALE: 1"= 100 PRIOR INST.: 20060154188