
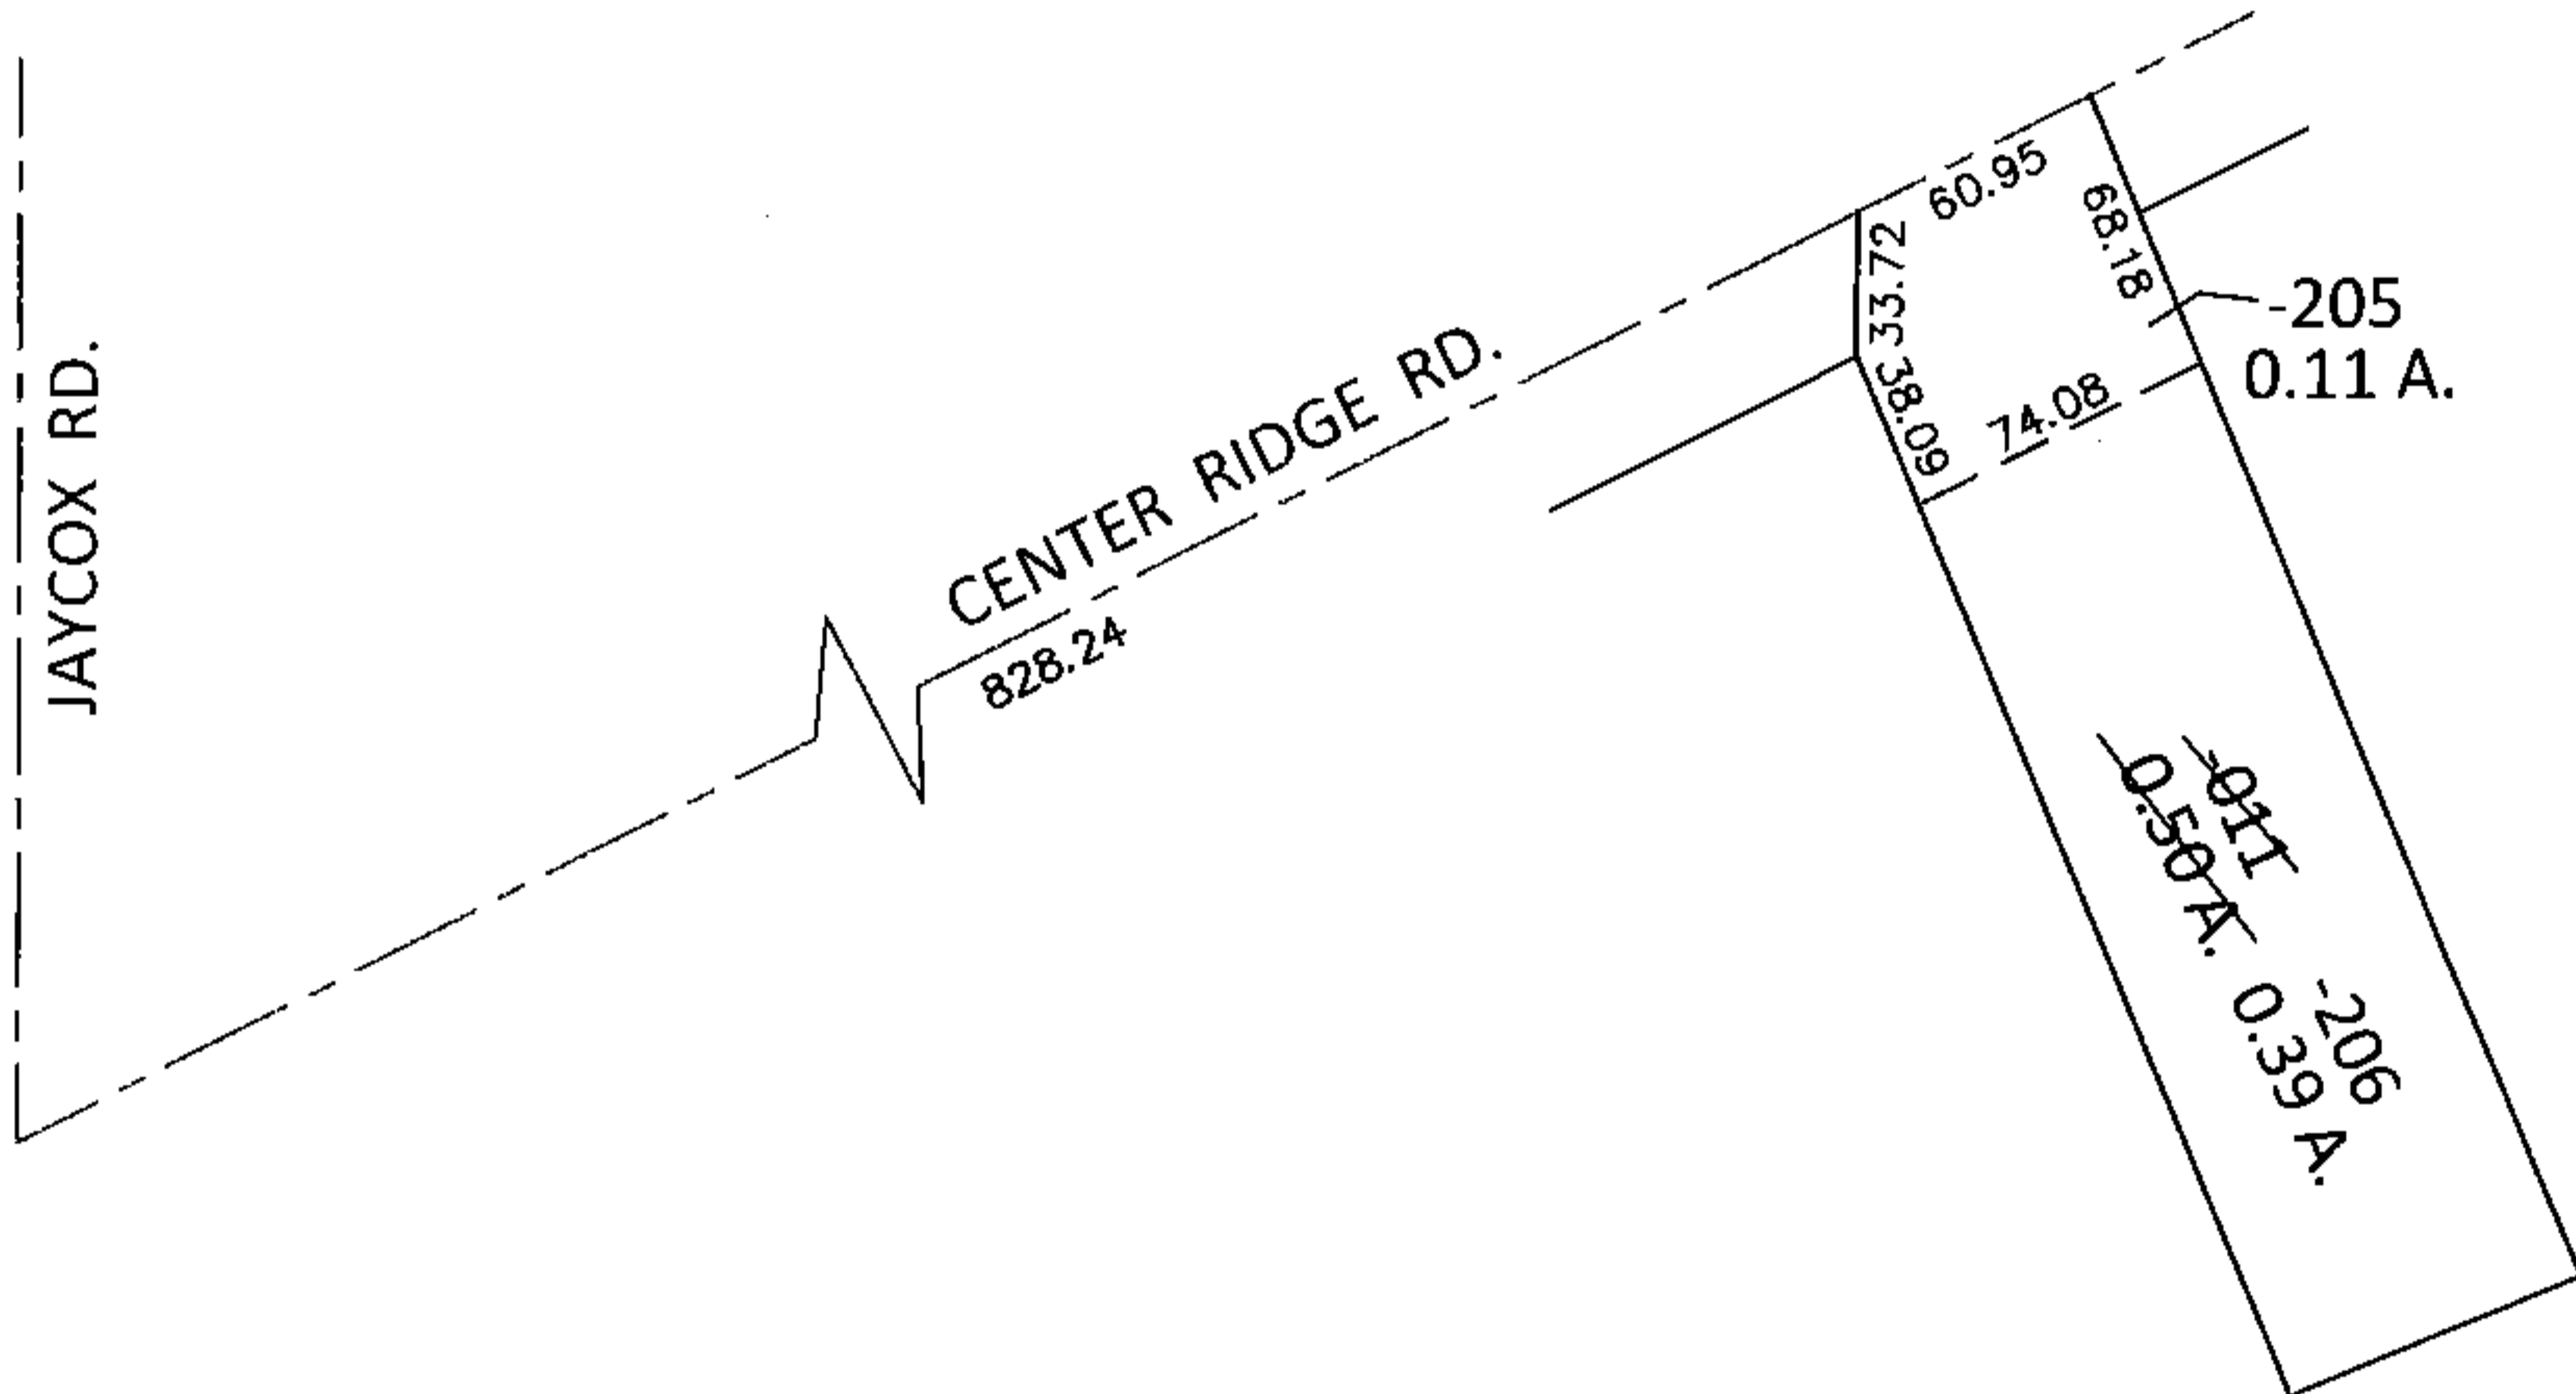


PARENT PARCEL: 07-00-016-104-011


CHILD PARCEL: 07-00-016-104-205, -206

STARTING POINT: INTERSECTION OF C/L OF CENTER RIDGE RD. AND C/L OF JAYCOX RD.

14-00593

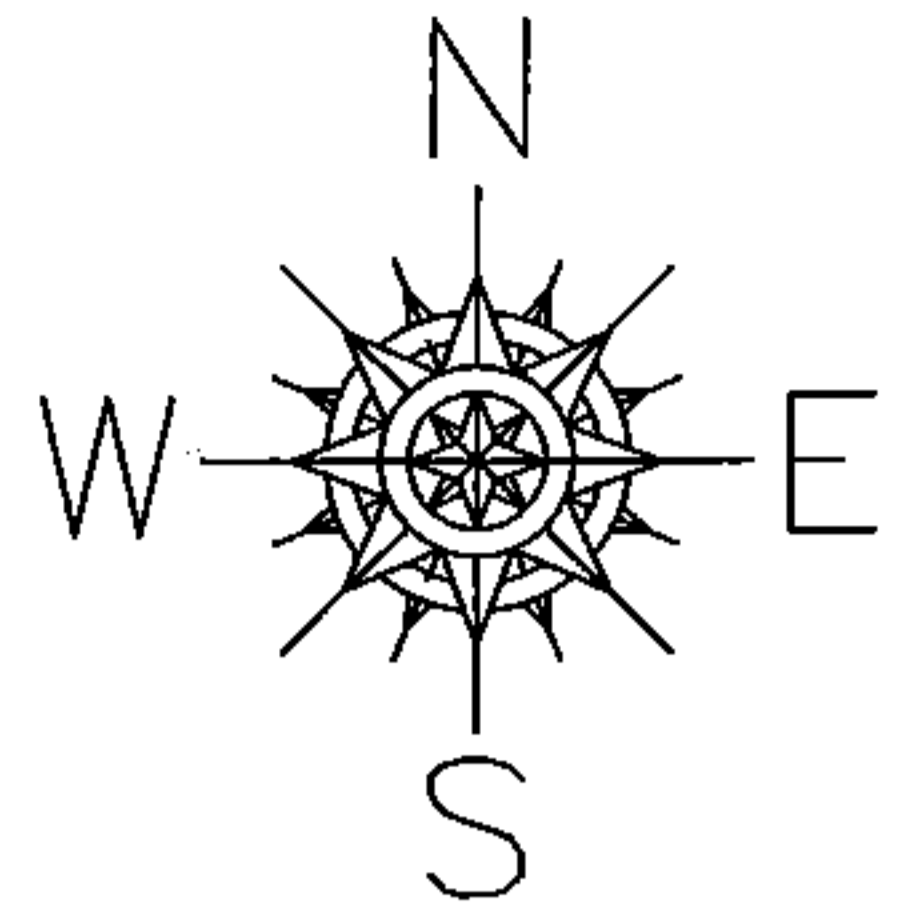

LOR-20-22.13
127-WDV

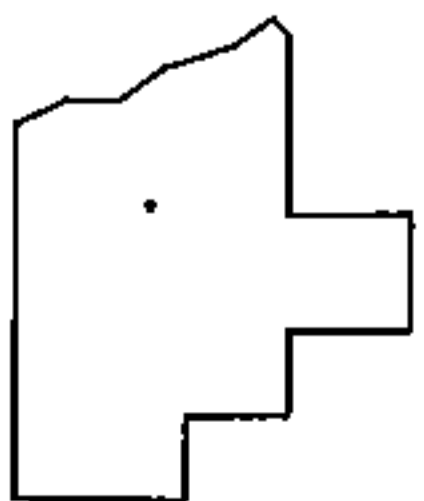

SPLITS/DEEDS PROCESSED
LORAIN COUNTY TAX MAP DEPARTMENT
226 MIDDLE AVE. ELYRIA, OHIO

SURVEYED BY: WILLIAM D. THOMAS
CLOSURE: .00:10,000
MAP PAGE(S): 7-00-016-A
APPROVED BY: RRM DATE: 2-3-15
SCALE: 1"= 100 PRIOR INST.: OR 57/538