


PARENT PARCEL: 07-00-016-104-018



CHILD PARCEL: 07-00-016-104-211, -212

14-00600

STARTING POINT: INTERSECTION OF C/L OF CENTER RIDGE RD. AND C/L OF OLIVE AVE.

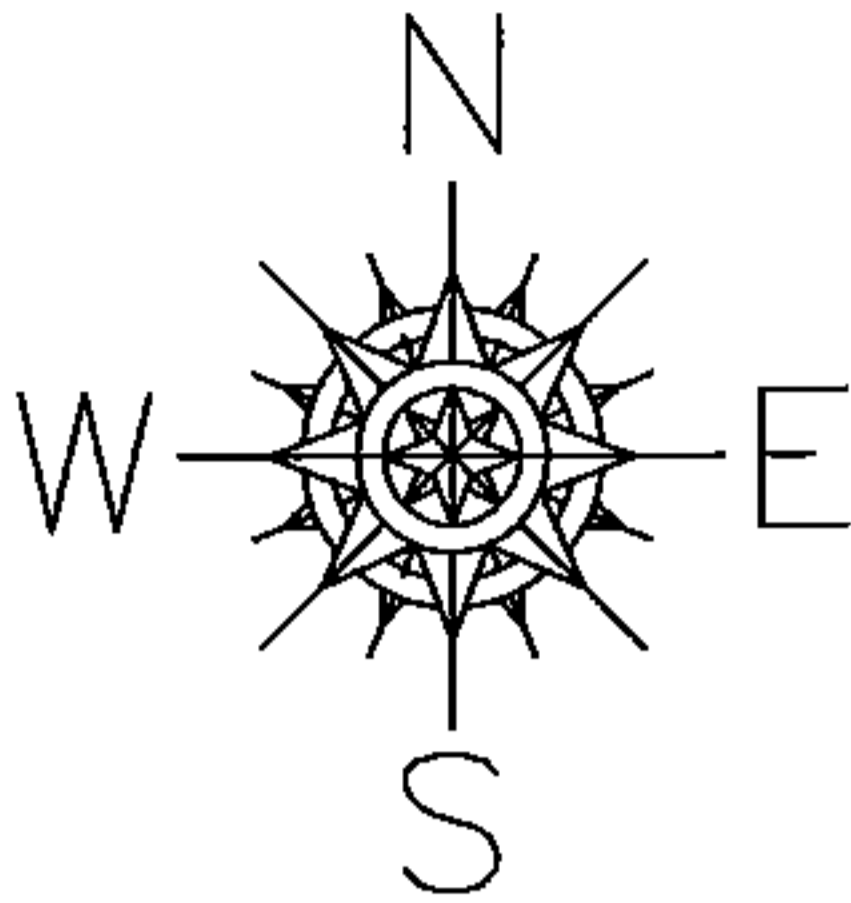

LOR-20-22.13
134-WDV

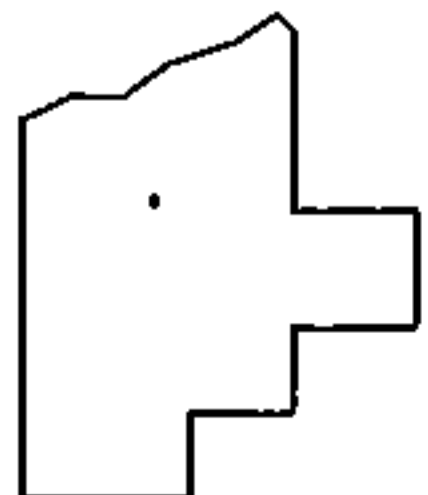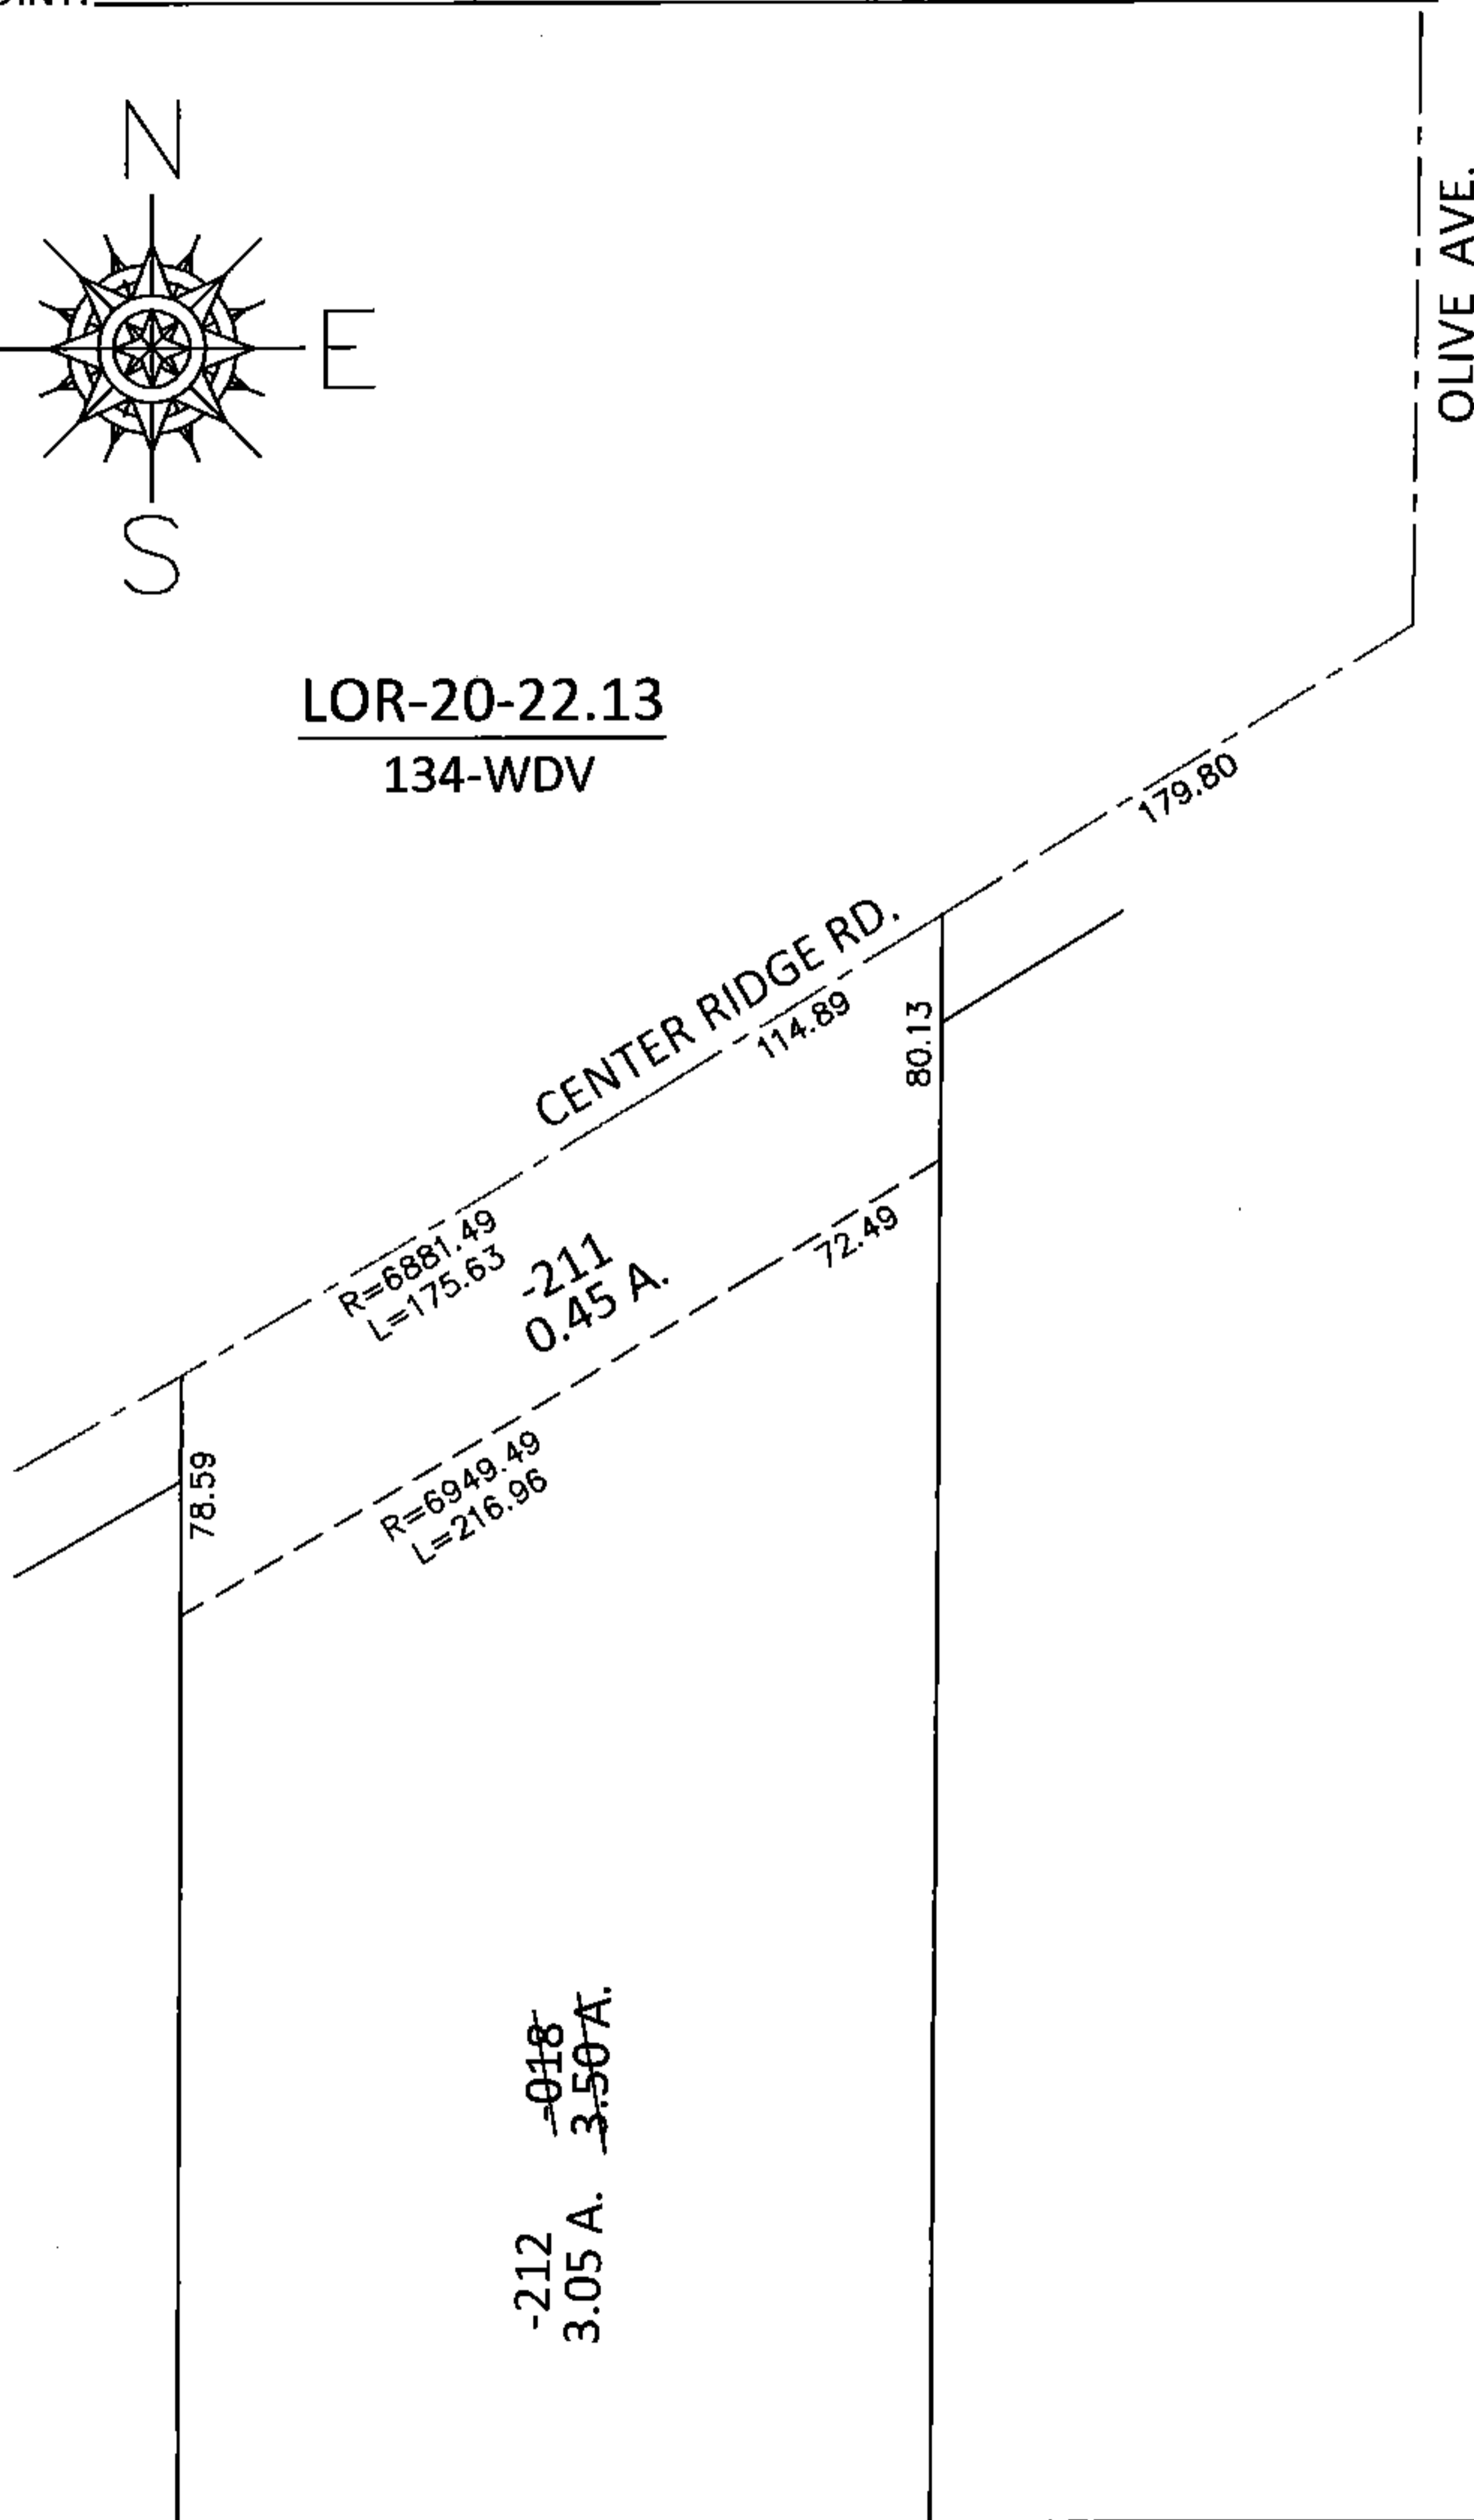

SPLITS/DEEDS PROCESSED

LORAIN COUNTY TAX MAP DEPARTMENT
226 MIDDLE AVE. ELYRIA, OHIO

SURVEYED BY: WILLIAM D. THOMAS

CLOSURE: .00:10,000

MAP PAGE(S): 7-00-016-A

APPROVED BY: RRM DATE: 2-11-15

SCALE: 1"= 100 PRIOR INST.: DV 1387/334