
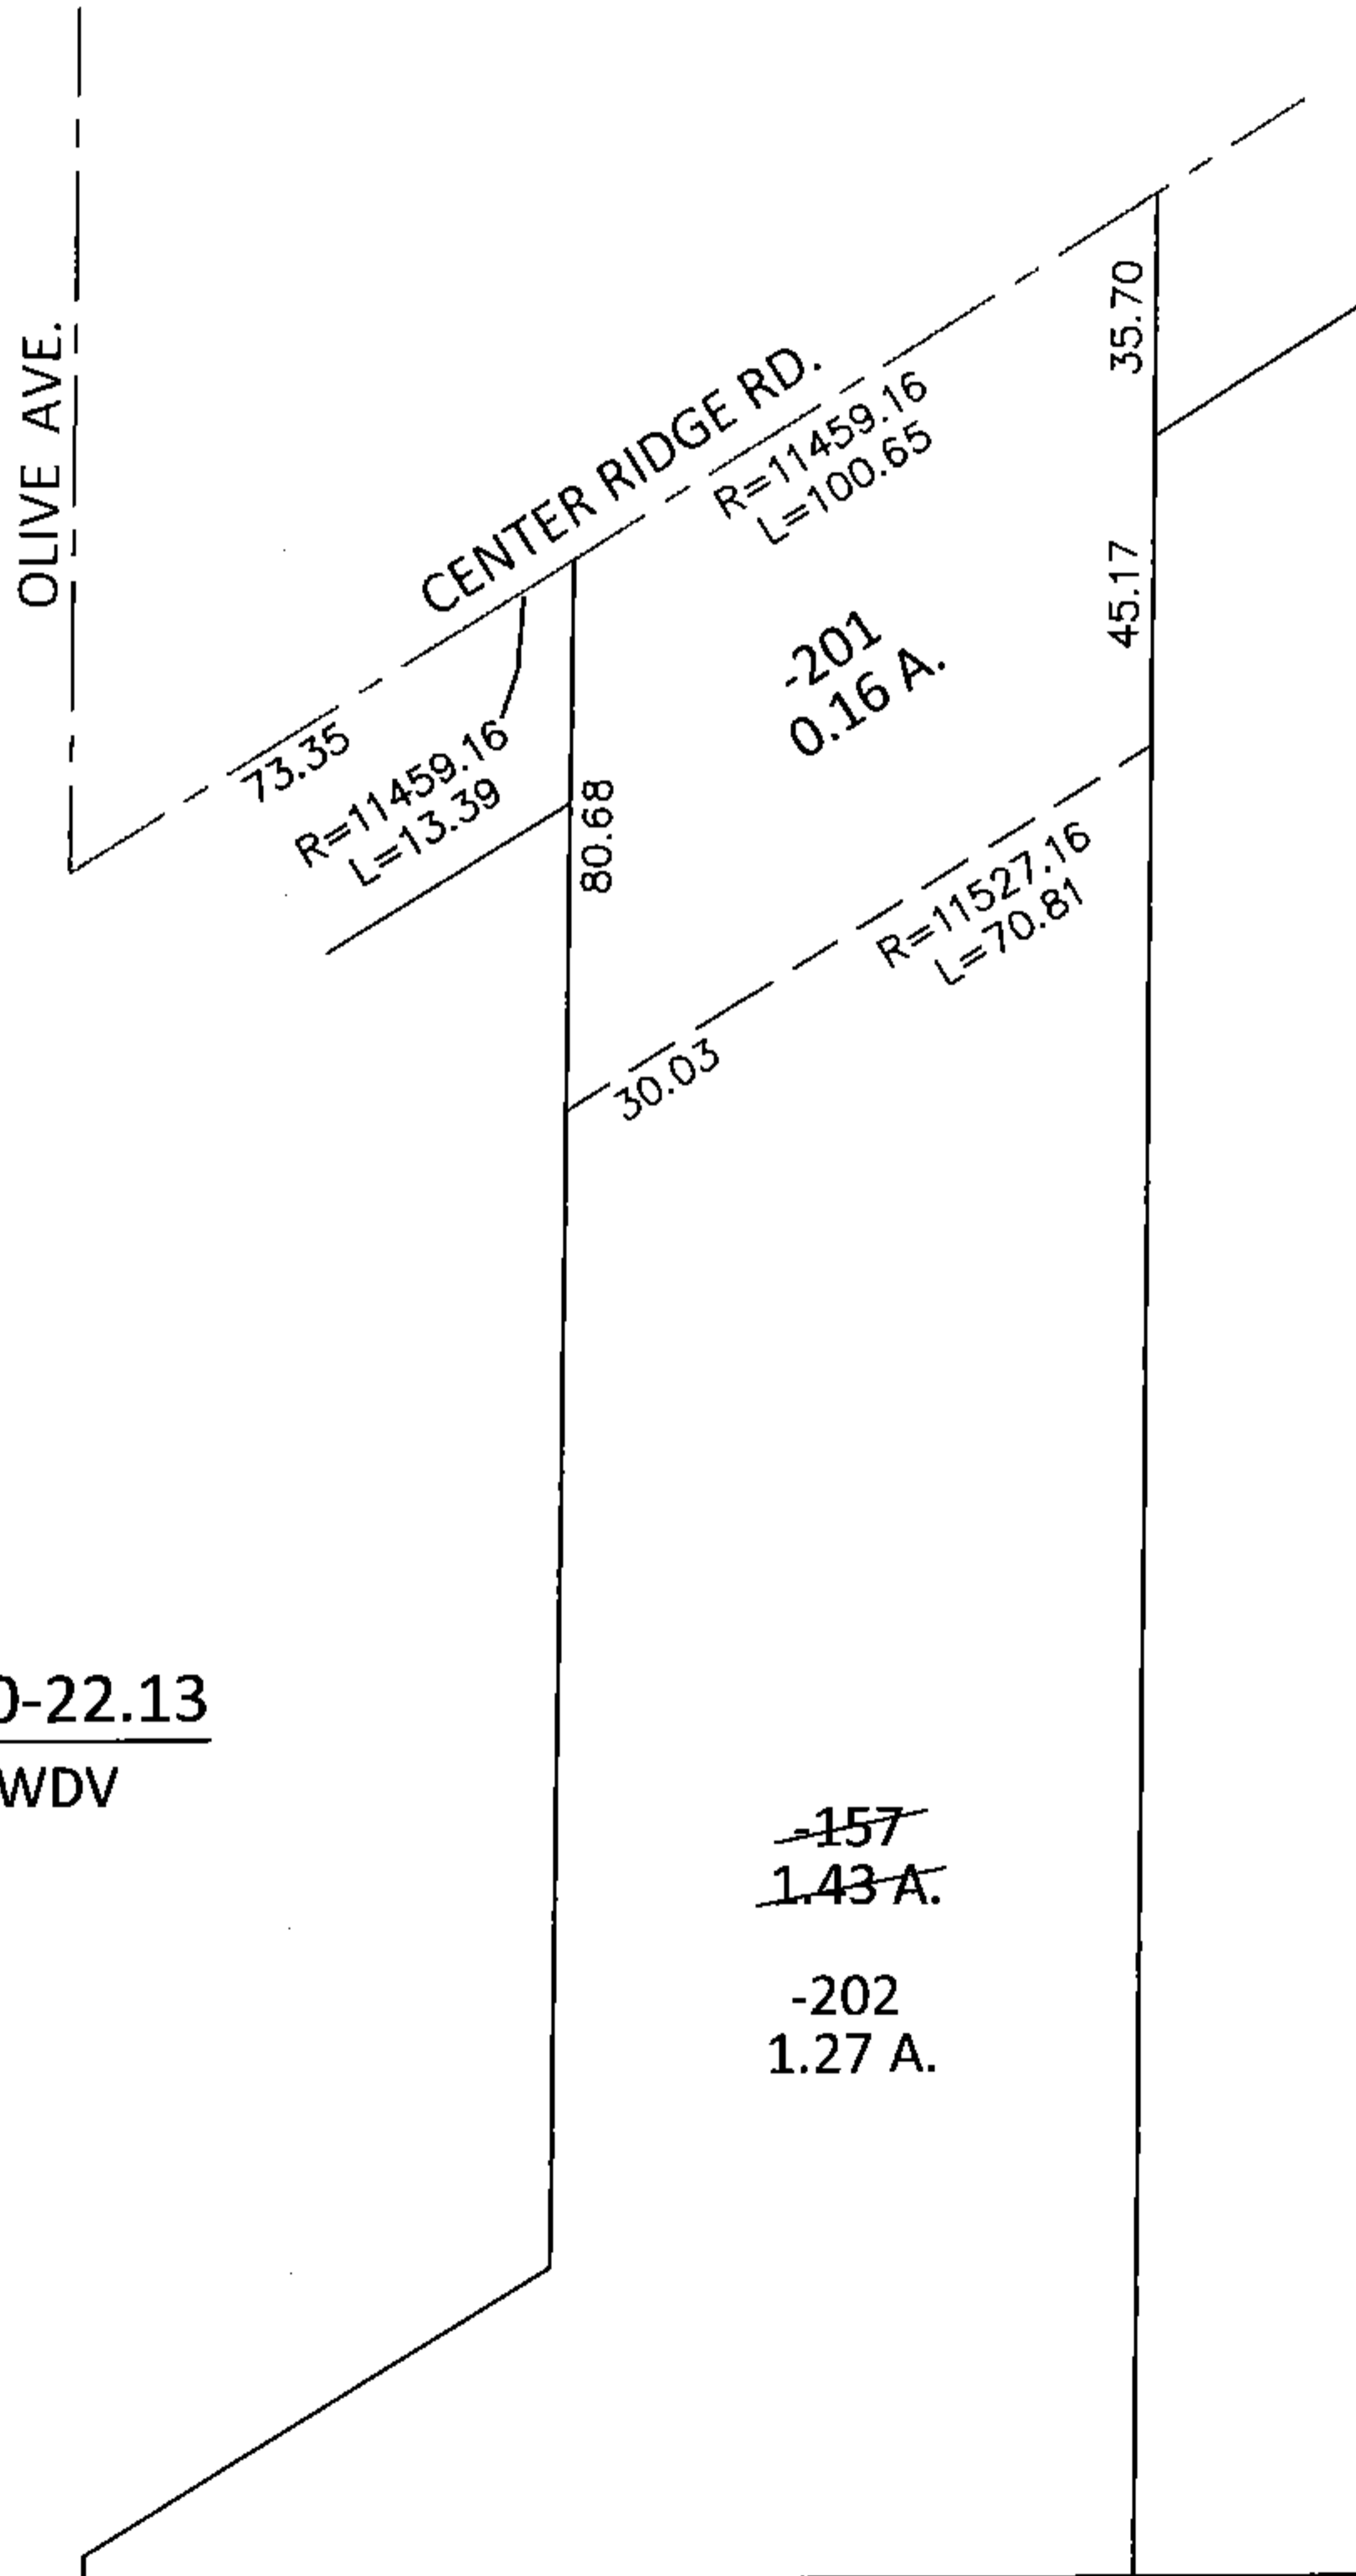


PARENT PARCEL: 07-00-016-104-157

CHILD PARCEL: 07-00-016-104-201, -202

STARTING POINT: INTERSECTION OF C/L OF CENTER RIDGE RD. AND C/L OF OLIVE AVE.


14-00603

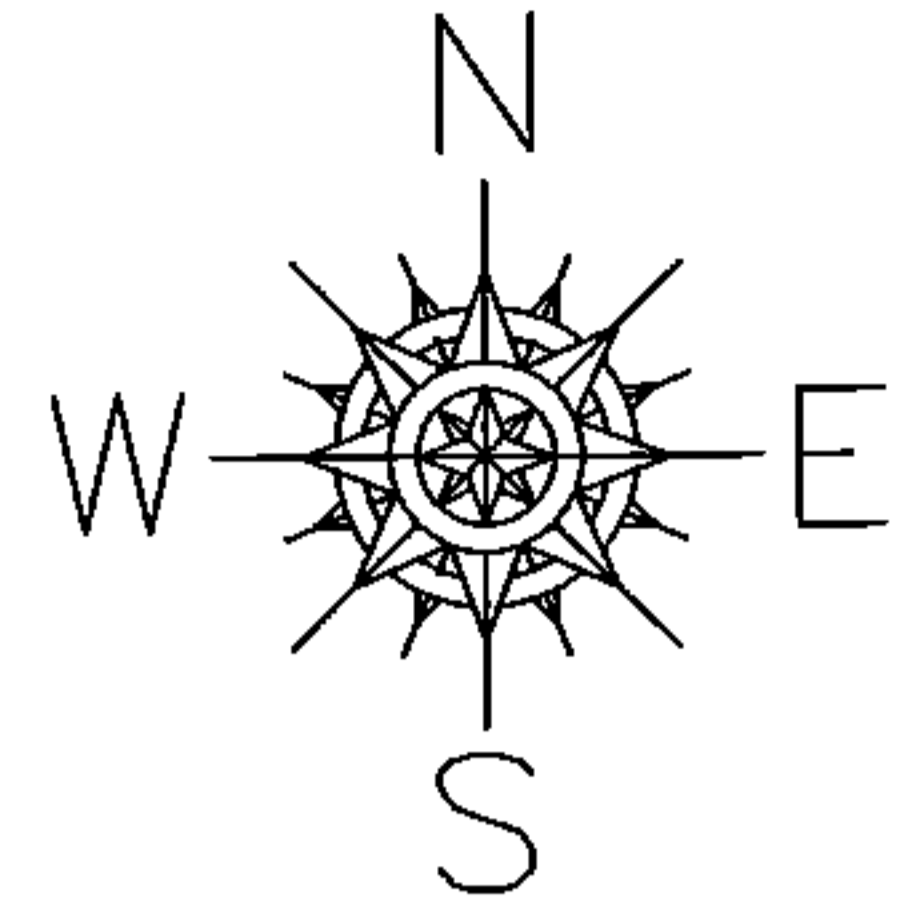

LOR-20-22.13
137-WDV

~~-157~~
1.43 A.

-202
1.27 A.

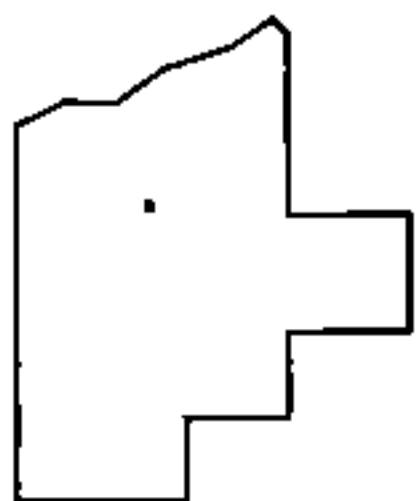

SPLITS/DEEDS PROCESSED

LORAIN COUNTY TAX MAP DEPARTMENT
226 MIDDLE AVE. ELYRIA, OHIO

SURVEYED BY: WILLIAM D. THOMAS

CLOSURE: .01:10,000

MAP PAGE(S): 7-00-016-B

APPROVED BY: RRM DATE: 12-17-14

SCALE: 1"= 50' PRIOR INST.: 20110383724