


PARENT PARCEL: 07-00-016-104-120



CHILD PARCEL: 07-00-016-104-215, -216

STARTING POINT: INTERSECTION OF C/L OF CENTER RIDGE RD. AND C/L OF PITTS BLVD.

14-00604

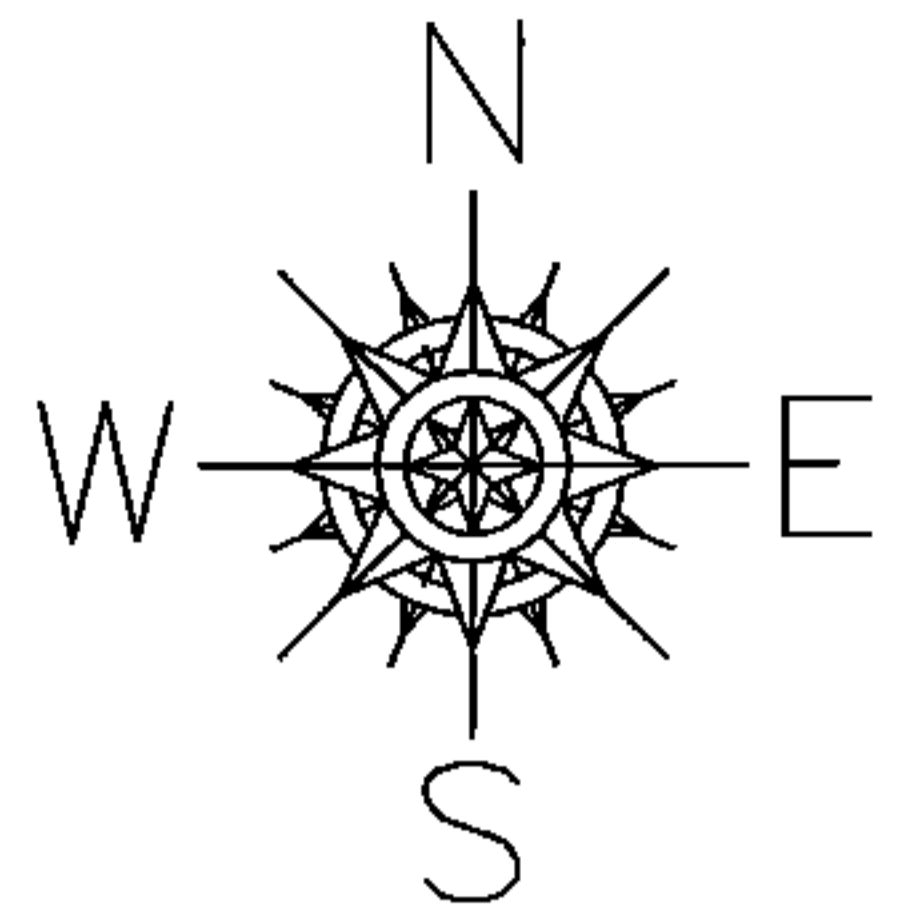

LOR-20-22.13
138-WDV

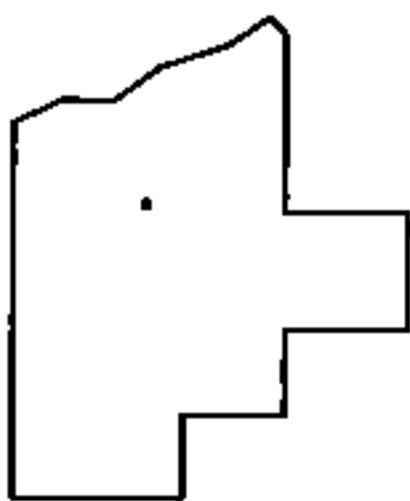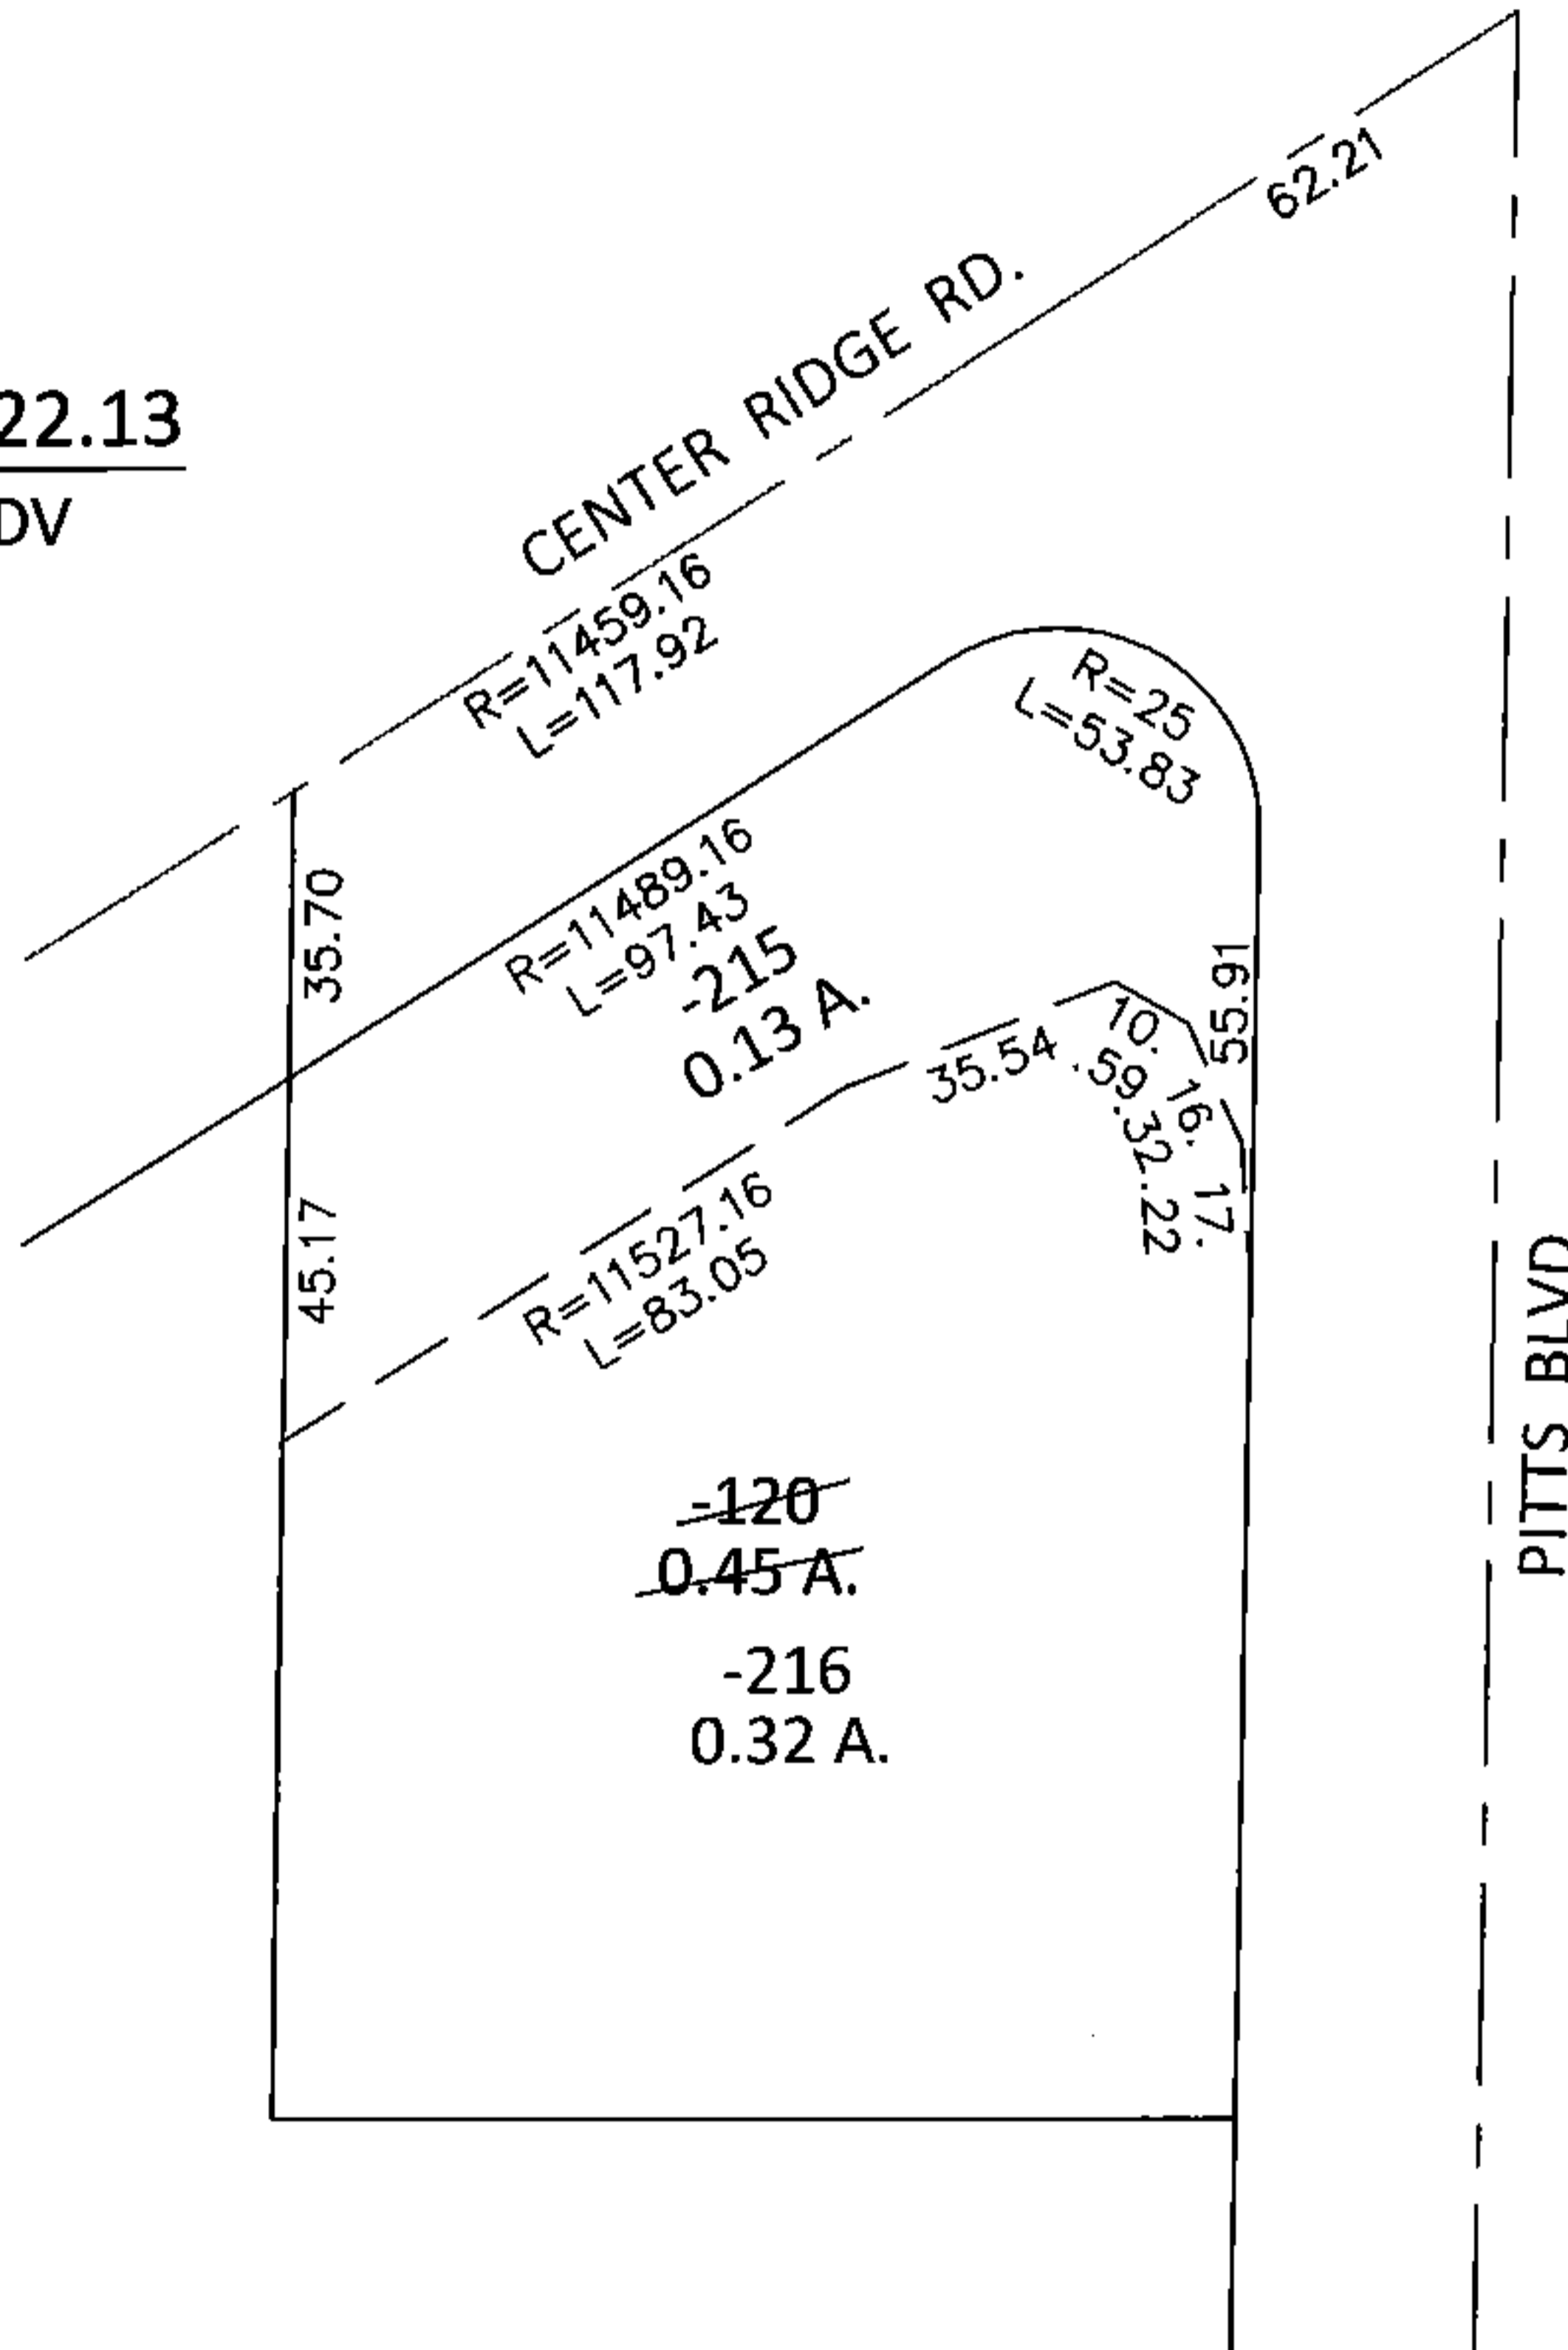

SPLITS/DEEDS PROCESSED

LORAIN COUNTY TAX MAP DEPARTMENT
226 MIDDLE AVE. ELYRIA, OHIO

SURVEYED BY: WILLIAM D. THOMAS

CLOSURE: .01:10,000

MAP PAGE(S): 7-00-016-B

APPROVED BY: RRM DATE: 2-11-15

SCALE: 1"= 50' PRIOR INST.: 20110394665