
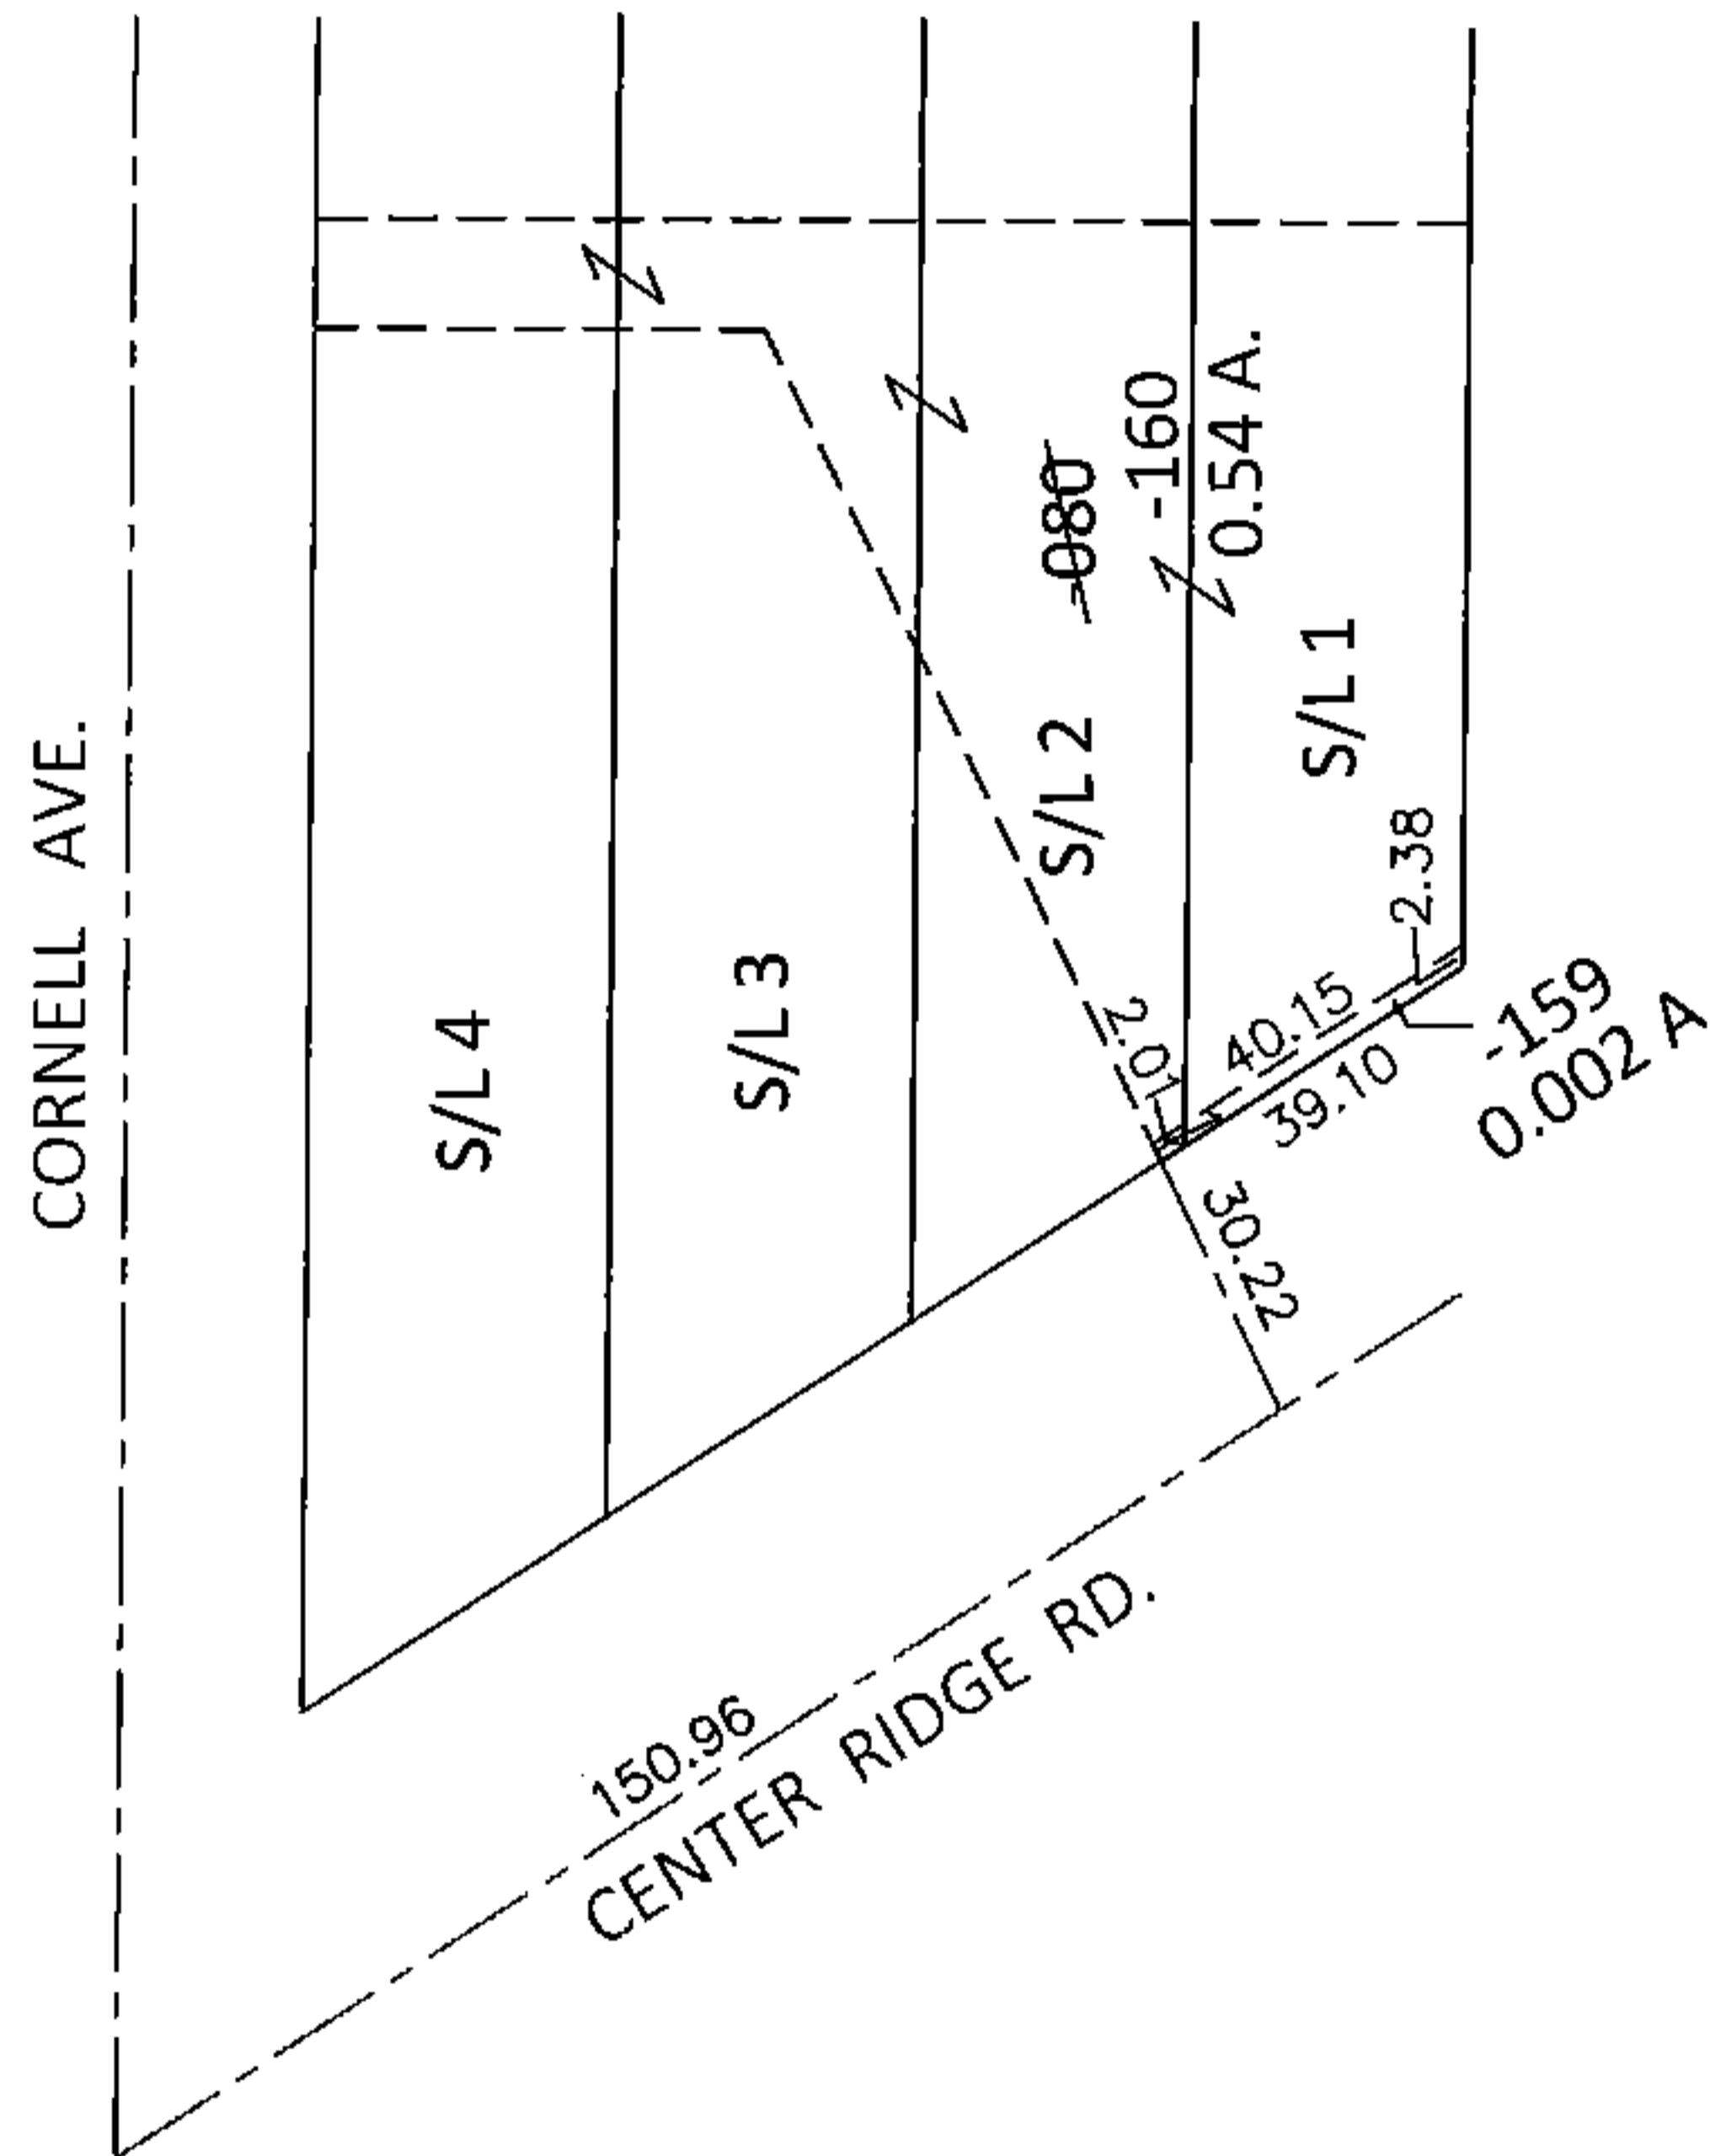


PARENT PARCEL: 07-00-017-128-080


CHILD PARCEL: 07-00-017-128-159, -160

STARTING POINT: INTERSECTION OF C/L OF CENTER RIDGE RD. AND C/L OF CORNELL AVE.

14-00611

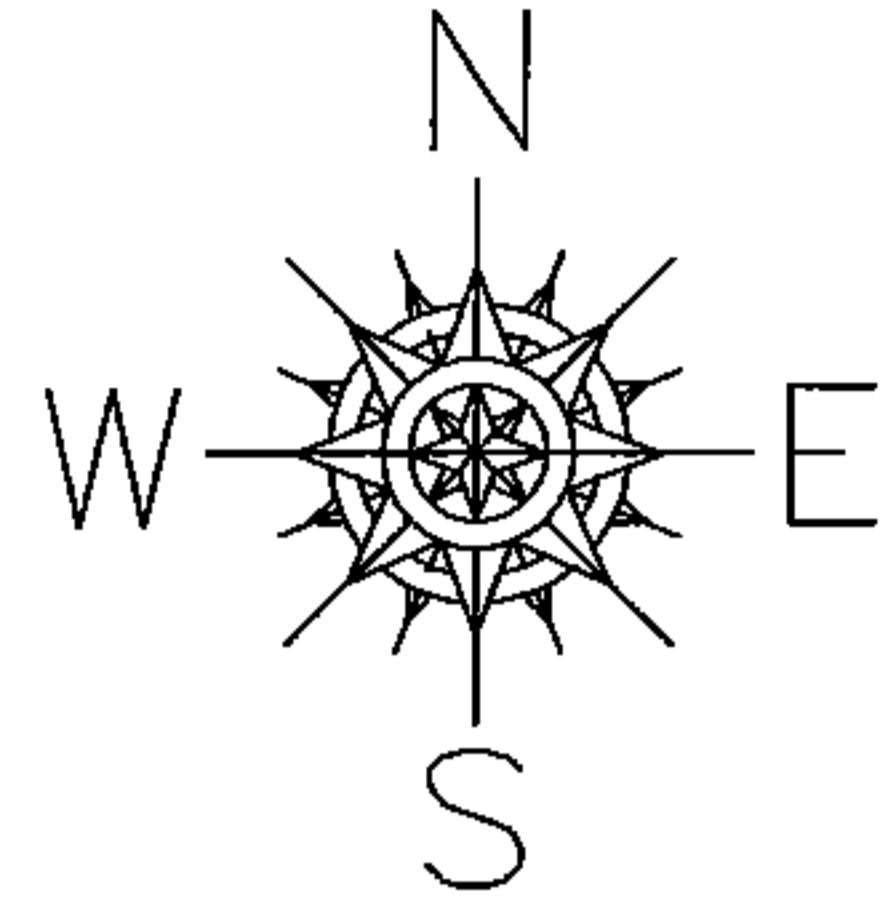

LOR-20-22.13
158-WDV

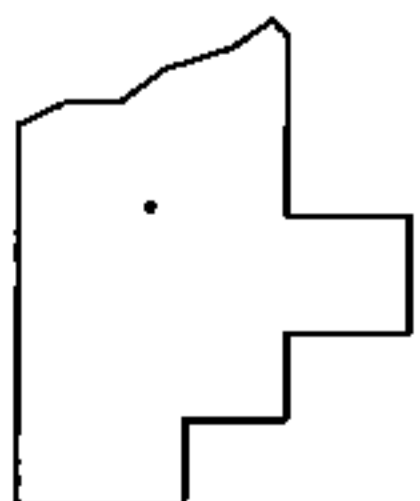

SPLITS/DEEDS PROCESSED

LORAIN COUNTY TAX MAP DEPARTMENT
226 MIDDLE AVE. ELYRIA, OHIO

SURVEYED BY: WILLIAM D. THOMAS

CLOSURE: .01:10,000

MAP PAGE(S): 7-00-017-D

APPROVED BY: RRM DATE: 2-13-15

SCALE: 1"= 50' PRIOR INST.: 19990643849