


PARENT PARCEL: 07-00-008-116-005

CHILD PARCEL: 07-00-008-116-029, -030

STARTING POINT: INTERSECTION OF C/L OF CENTER RIDGE RD. AND C/L OF LEAR NAGLE RD.


14-00626

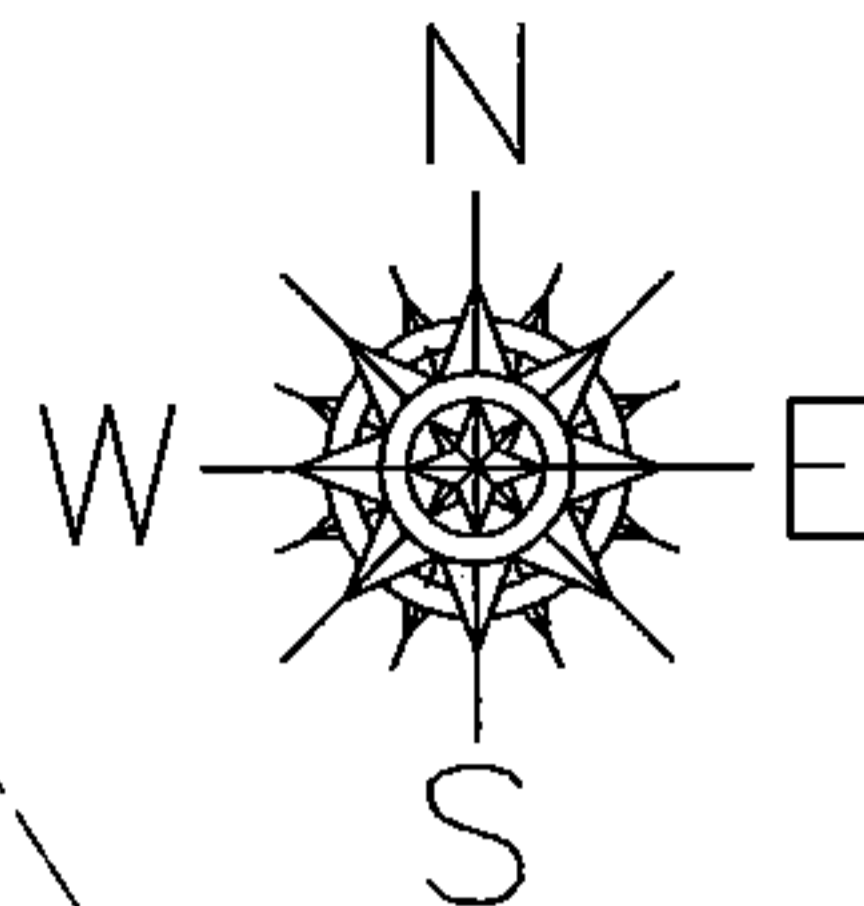

CENTER RIDGE RD.


736.29

LEAR NAGLE RD.

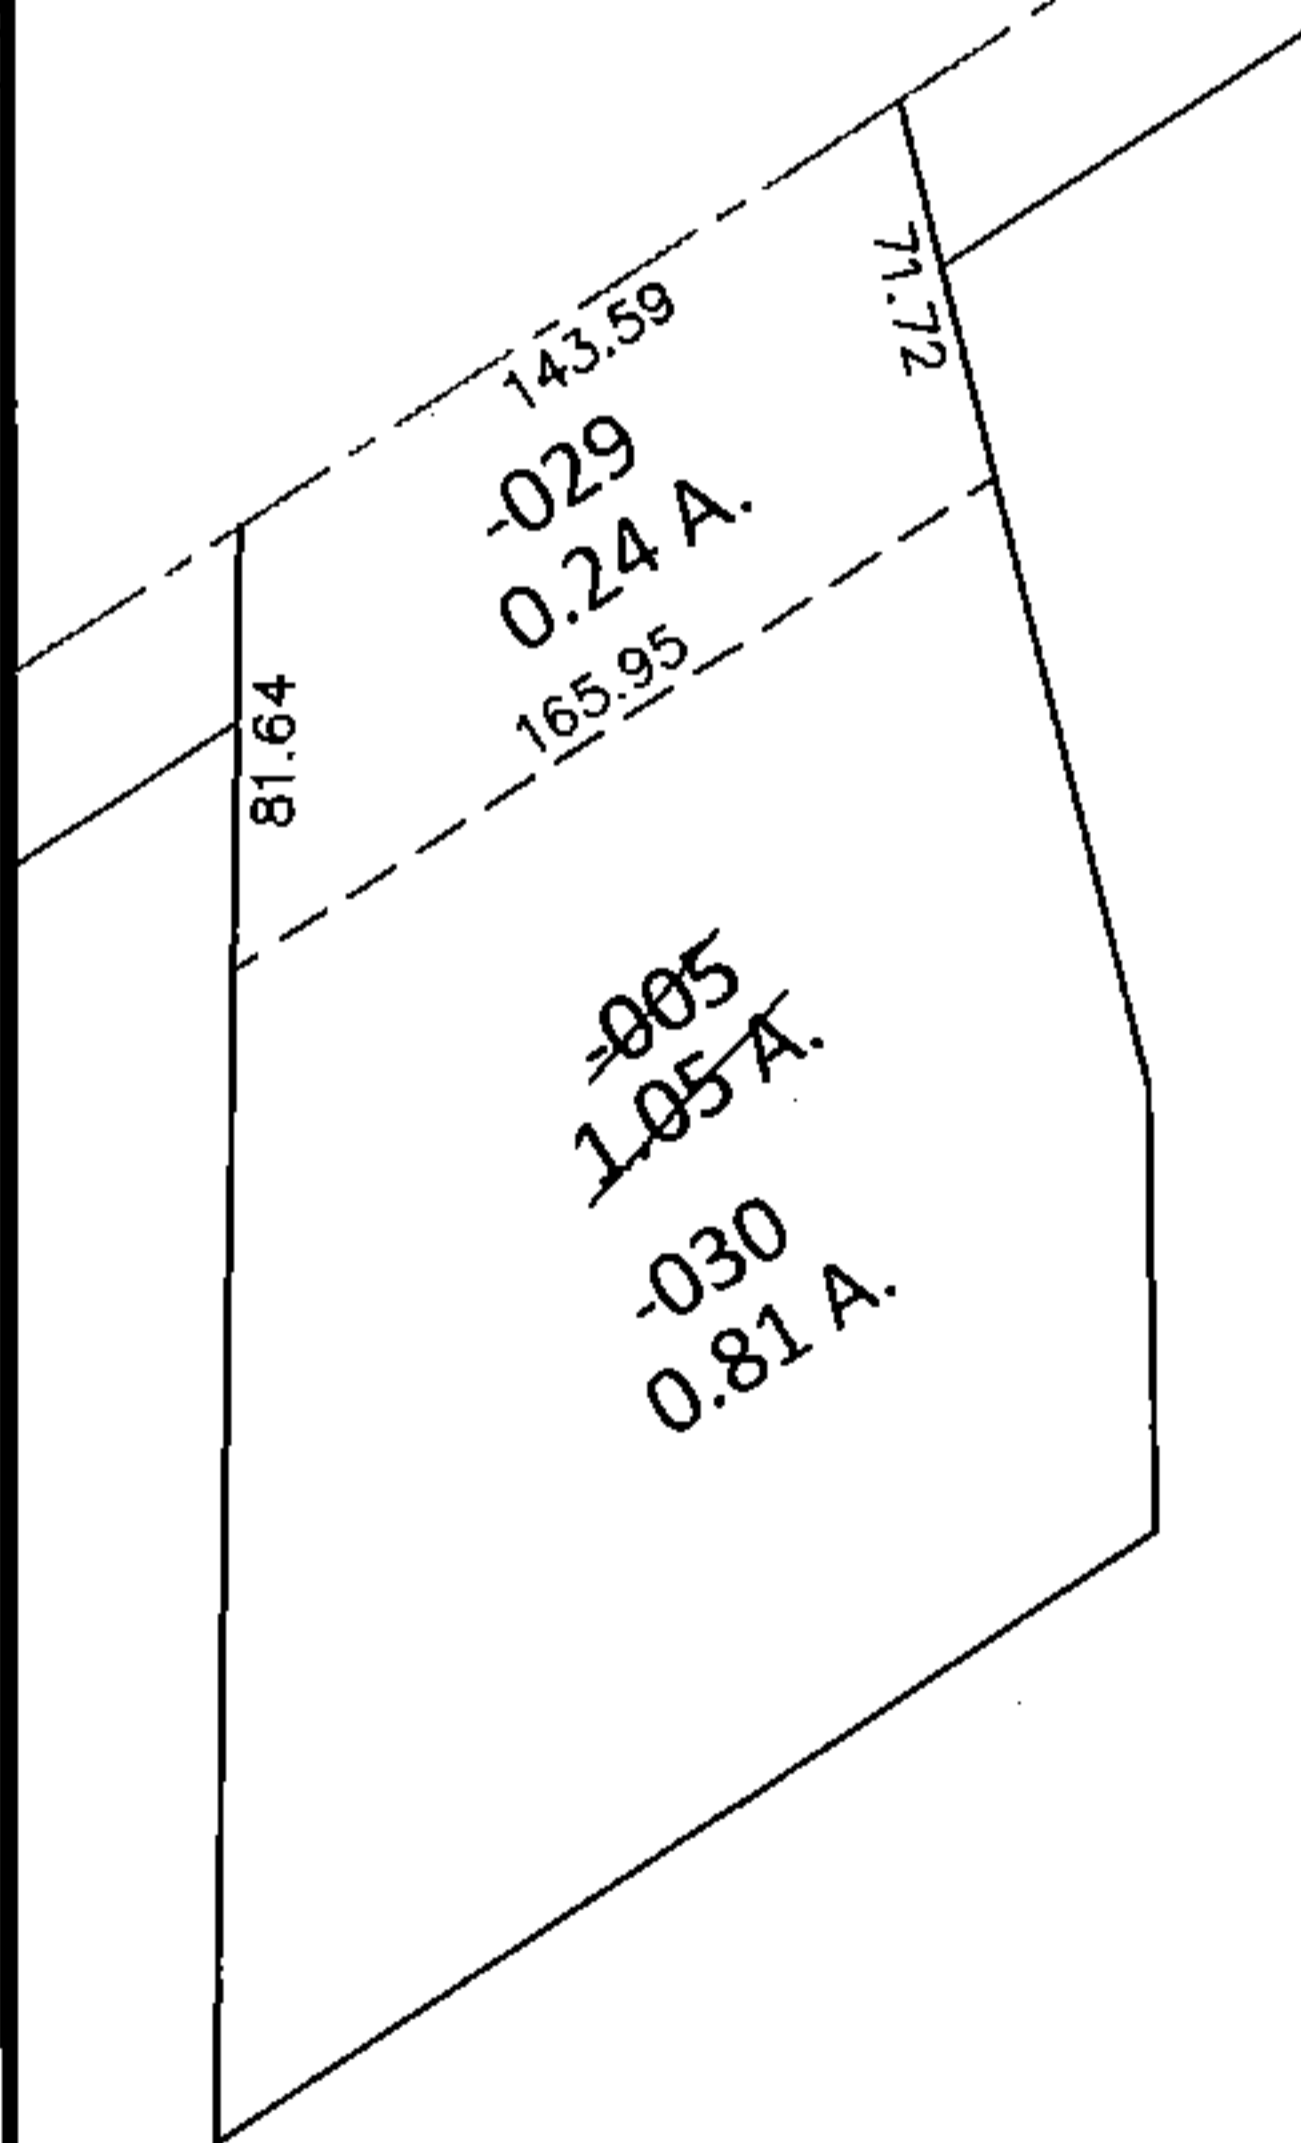

LOR-20-22.13

174-WDV

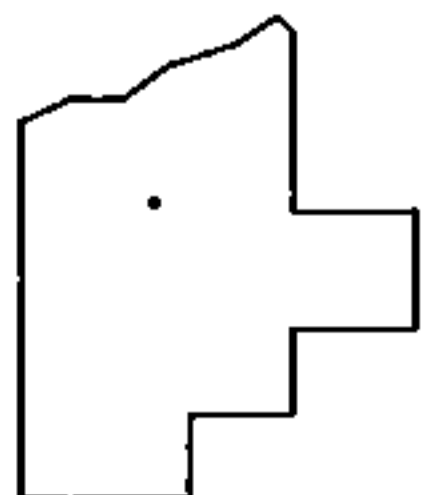

SPLITS/DEEDS PROCESSED

LORAIN COUNTY TAX MAP DEPARTMENT
226 MIDDLE AVE. ELYRIA, OHIO

SURVEYED BY: WILLIAM D. THOMAS

CLOSURE: .01:10,000

MAP PAGE(S): 7-00-008-C

APPROVED BY: RRM DATE: 3-5-15

SCALE: 1"= 100 PRIOR INST.: 20000661900