
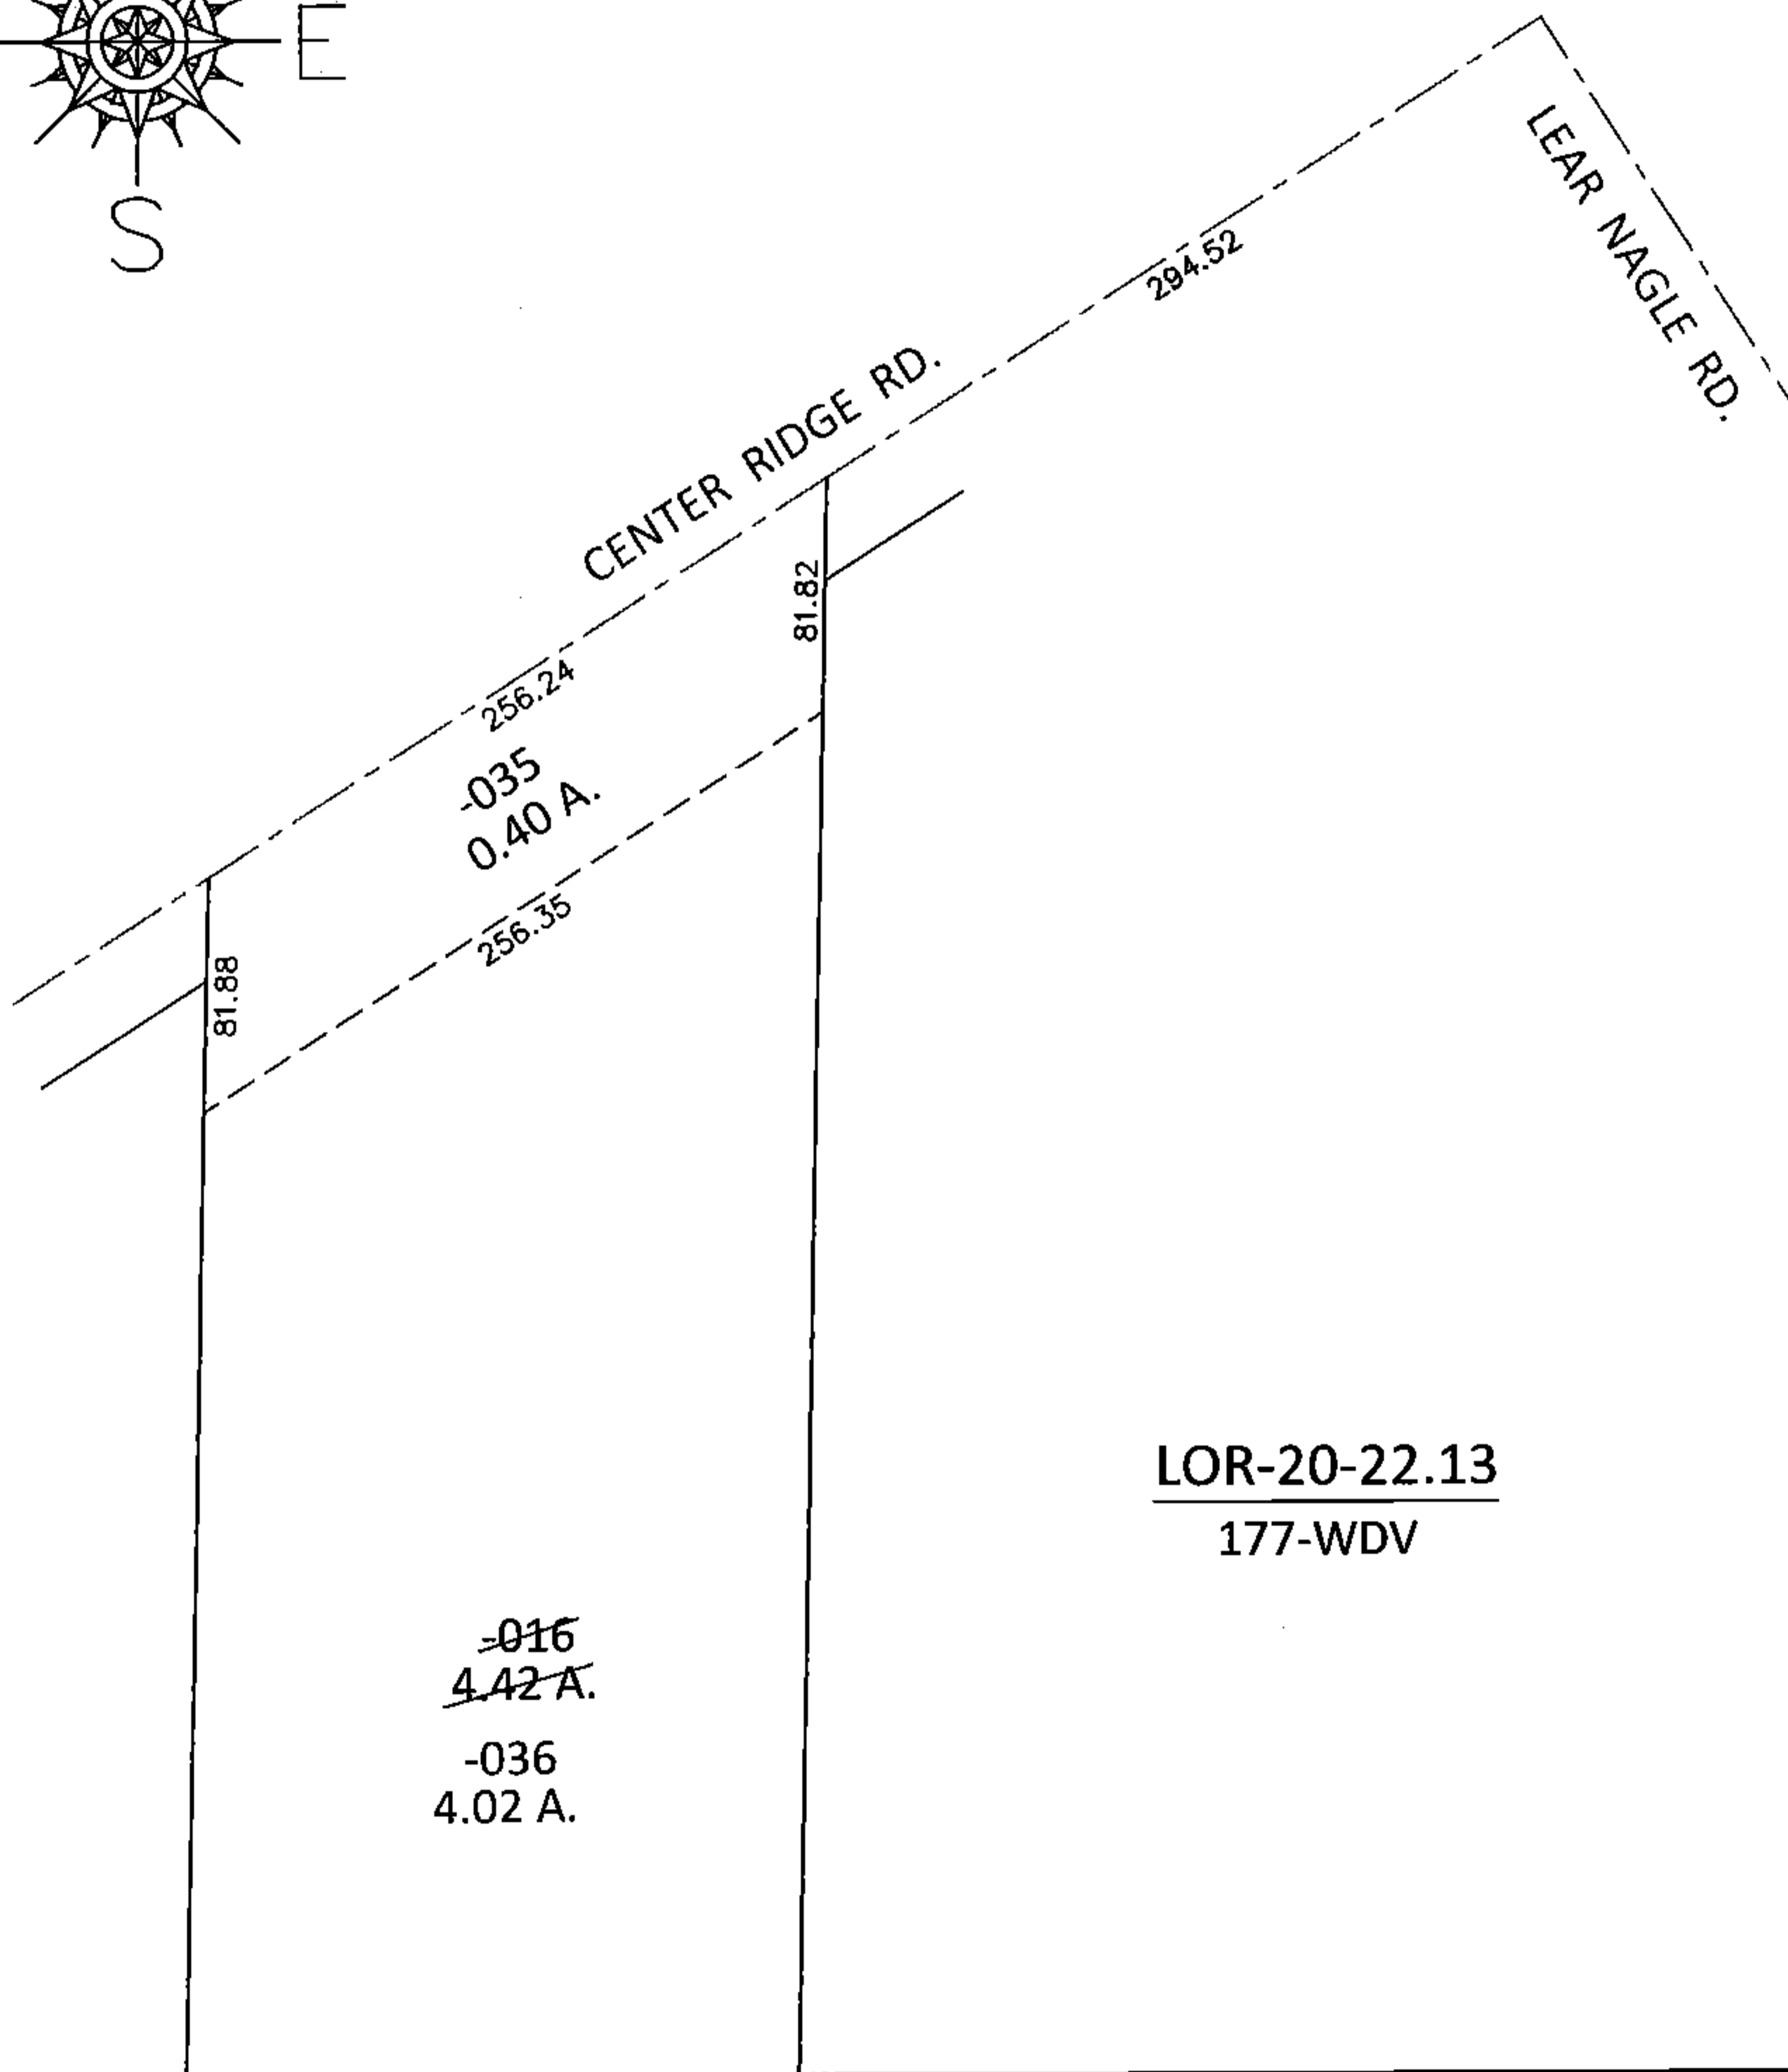


PARENT PARCEL: 07-00-008-116-016

CHILD PARCEL: 07-00-008-116-035, -036

STARTING POINT: INTERSECTION OF C/L OF CENTER RIDGE RD. AND C/L OF LEAR NAGLE RD.

14-00629

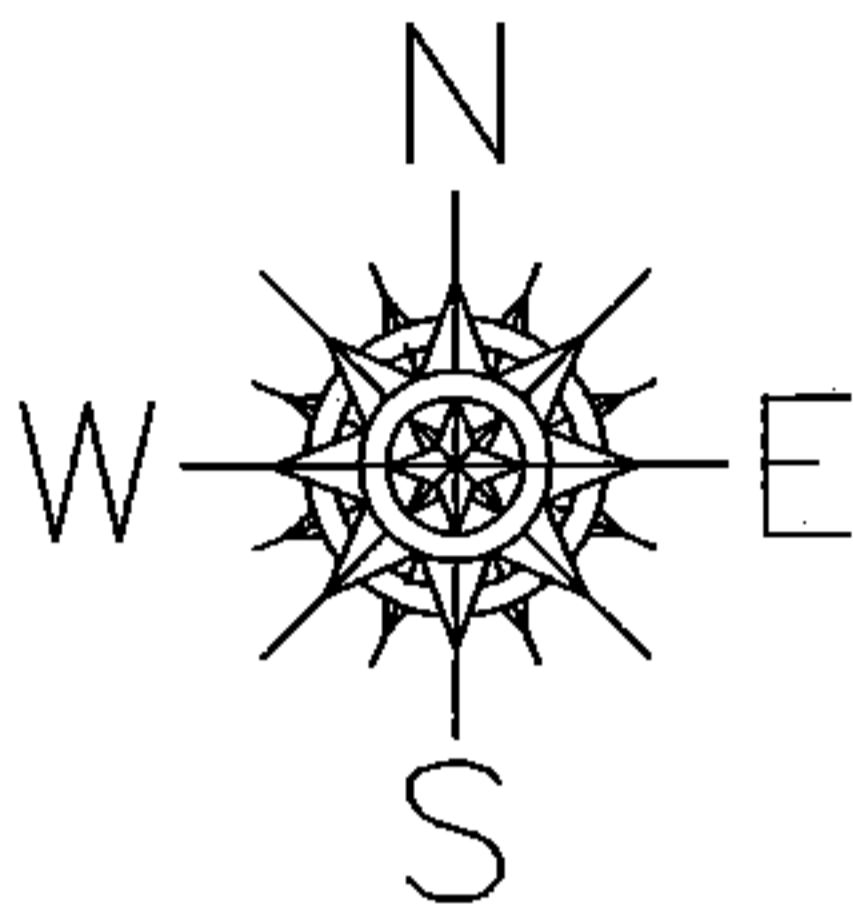


LOR-20-22.13

177-WDV

~~-016~~
~~4.42 A.~~

-036
4.02 A.

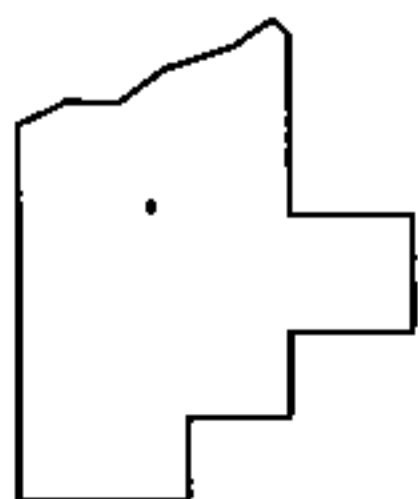

SPLITS/DEEDS PROCESSED

LORAIN COUNTY TAX MAP DEPARTMENT
226 MIDDLE AVE. ELYRIA, OHIO

SURVEYED BY: WILLIAM D. THOMAS

CLOSURE: .01:10,000

MAP PAGE(S): 7-00-008-C

APPROVED BY: RRM DATE: 3-5-15

SCALE: 1"= 100 PRIOR INST.: 20070194140