
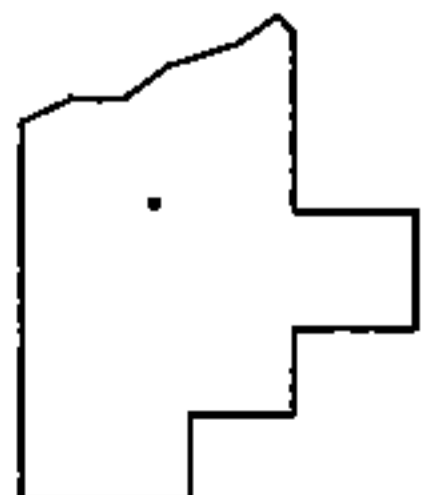
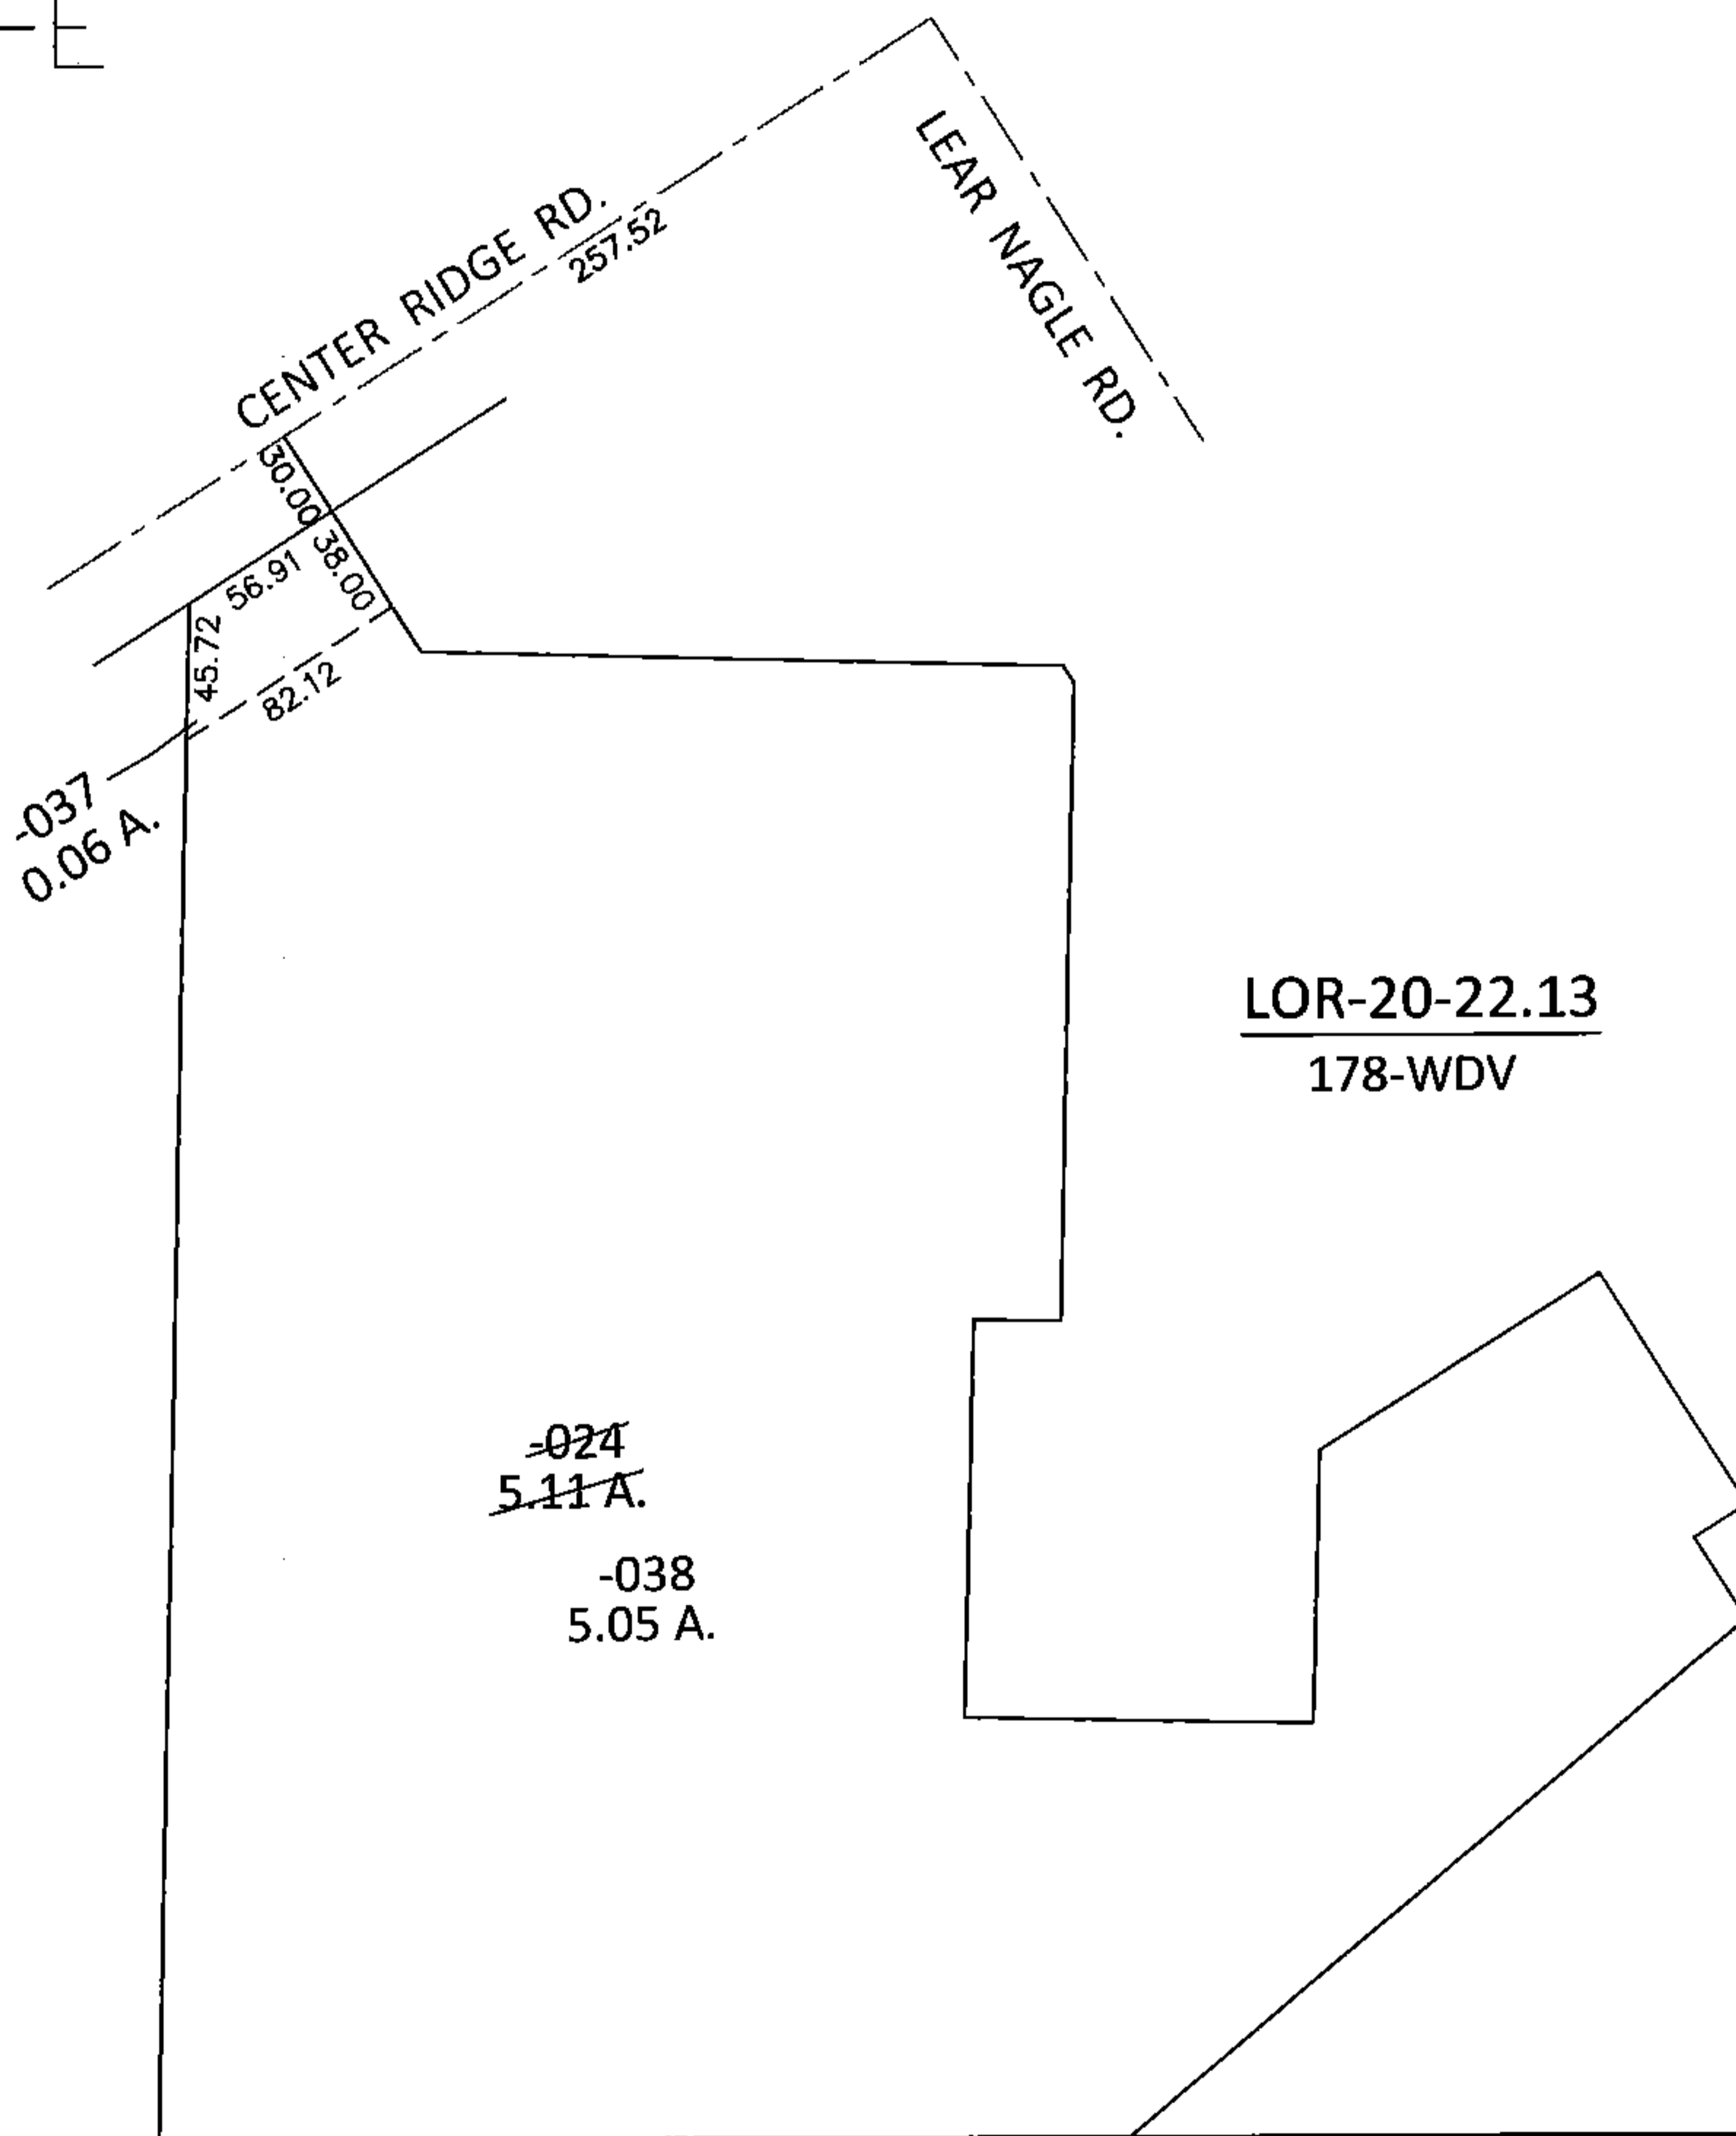


PARENT PARCEL: 07-00-008-116-024

CHILD PARCEL: 07-00-008-116-037, -038

14-00630

STARTING POINT: INTERSECTION OF C/L OF CENTER RIDGE RD. AND C/L OF LEAR NAGLE RD.

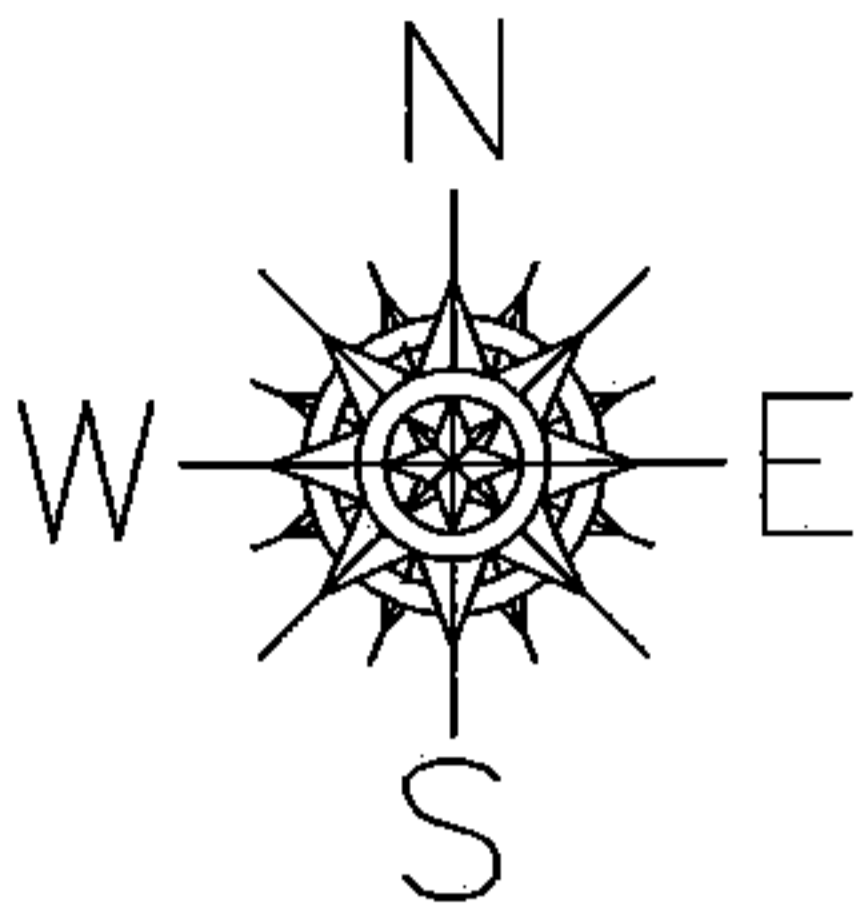

SPLITS/DEEDS PROCESSED

LORAIN COUNTY TAX MAP DEPARTMENT
226 MIDDLE AVE. ELYRIA, OHIO

SURVEYED BY: WILLIAM D. THOMAS
 CLOSURE: .01:10,000
 MAP PAGE(S): 7-00-008-C
 APPROVED BY: RRM DATE: 3-5-15
 SCALE: 1"= 100 PRIOR INST.: 20050110074