
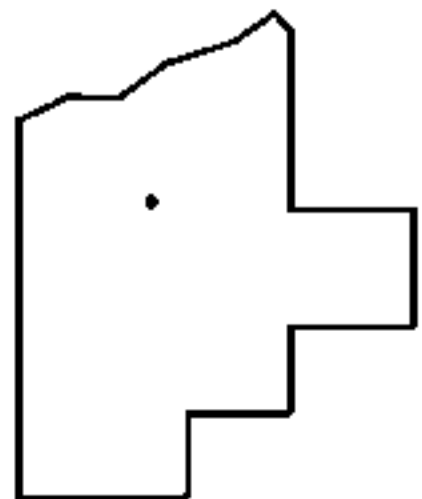


PARENT PARCEL: 07-00-008-116-019

CHILD PARCEL: 07-00-008-116-039, -040

STARTING POINT: INTERSECTION OF C/L OF CENTER RIDGE RD. AND C/L OF LEAR NAGLE RD.

14-00631

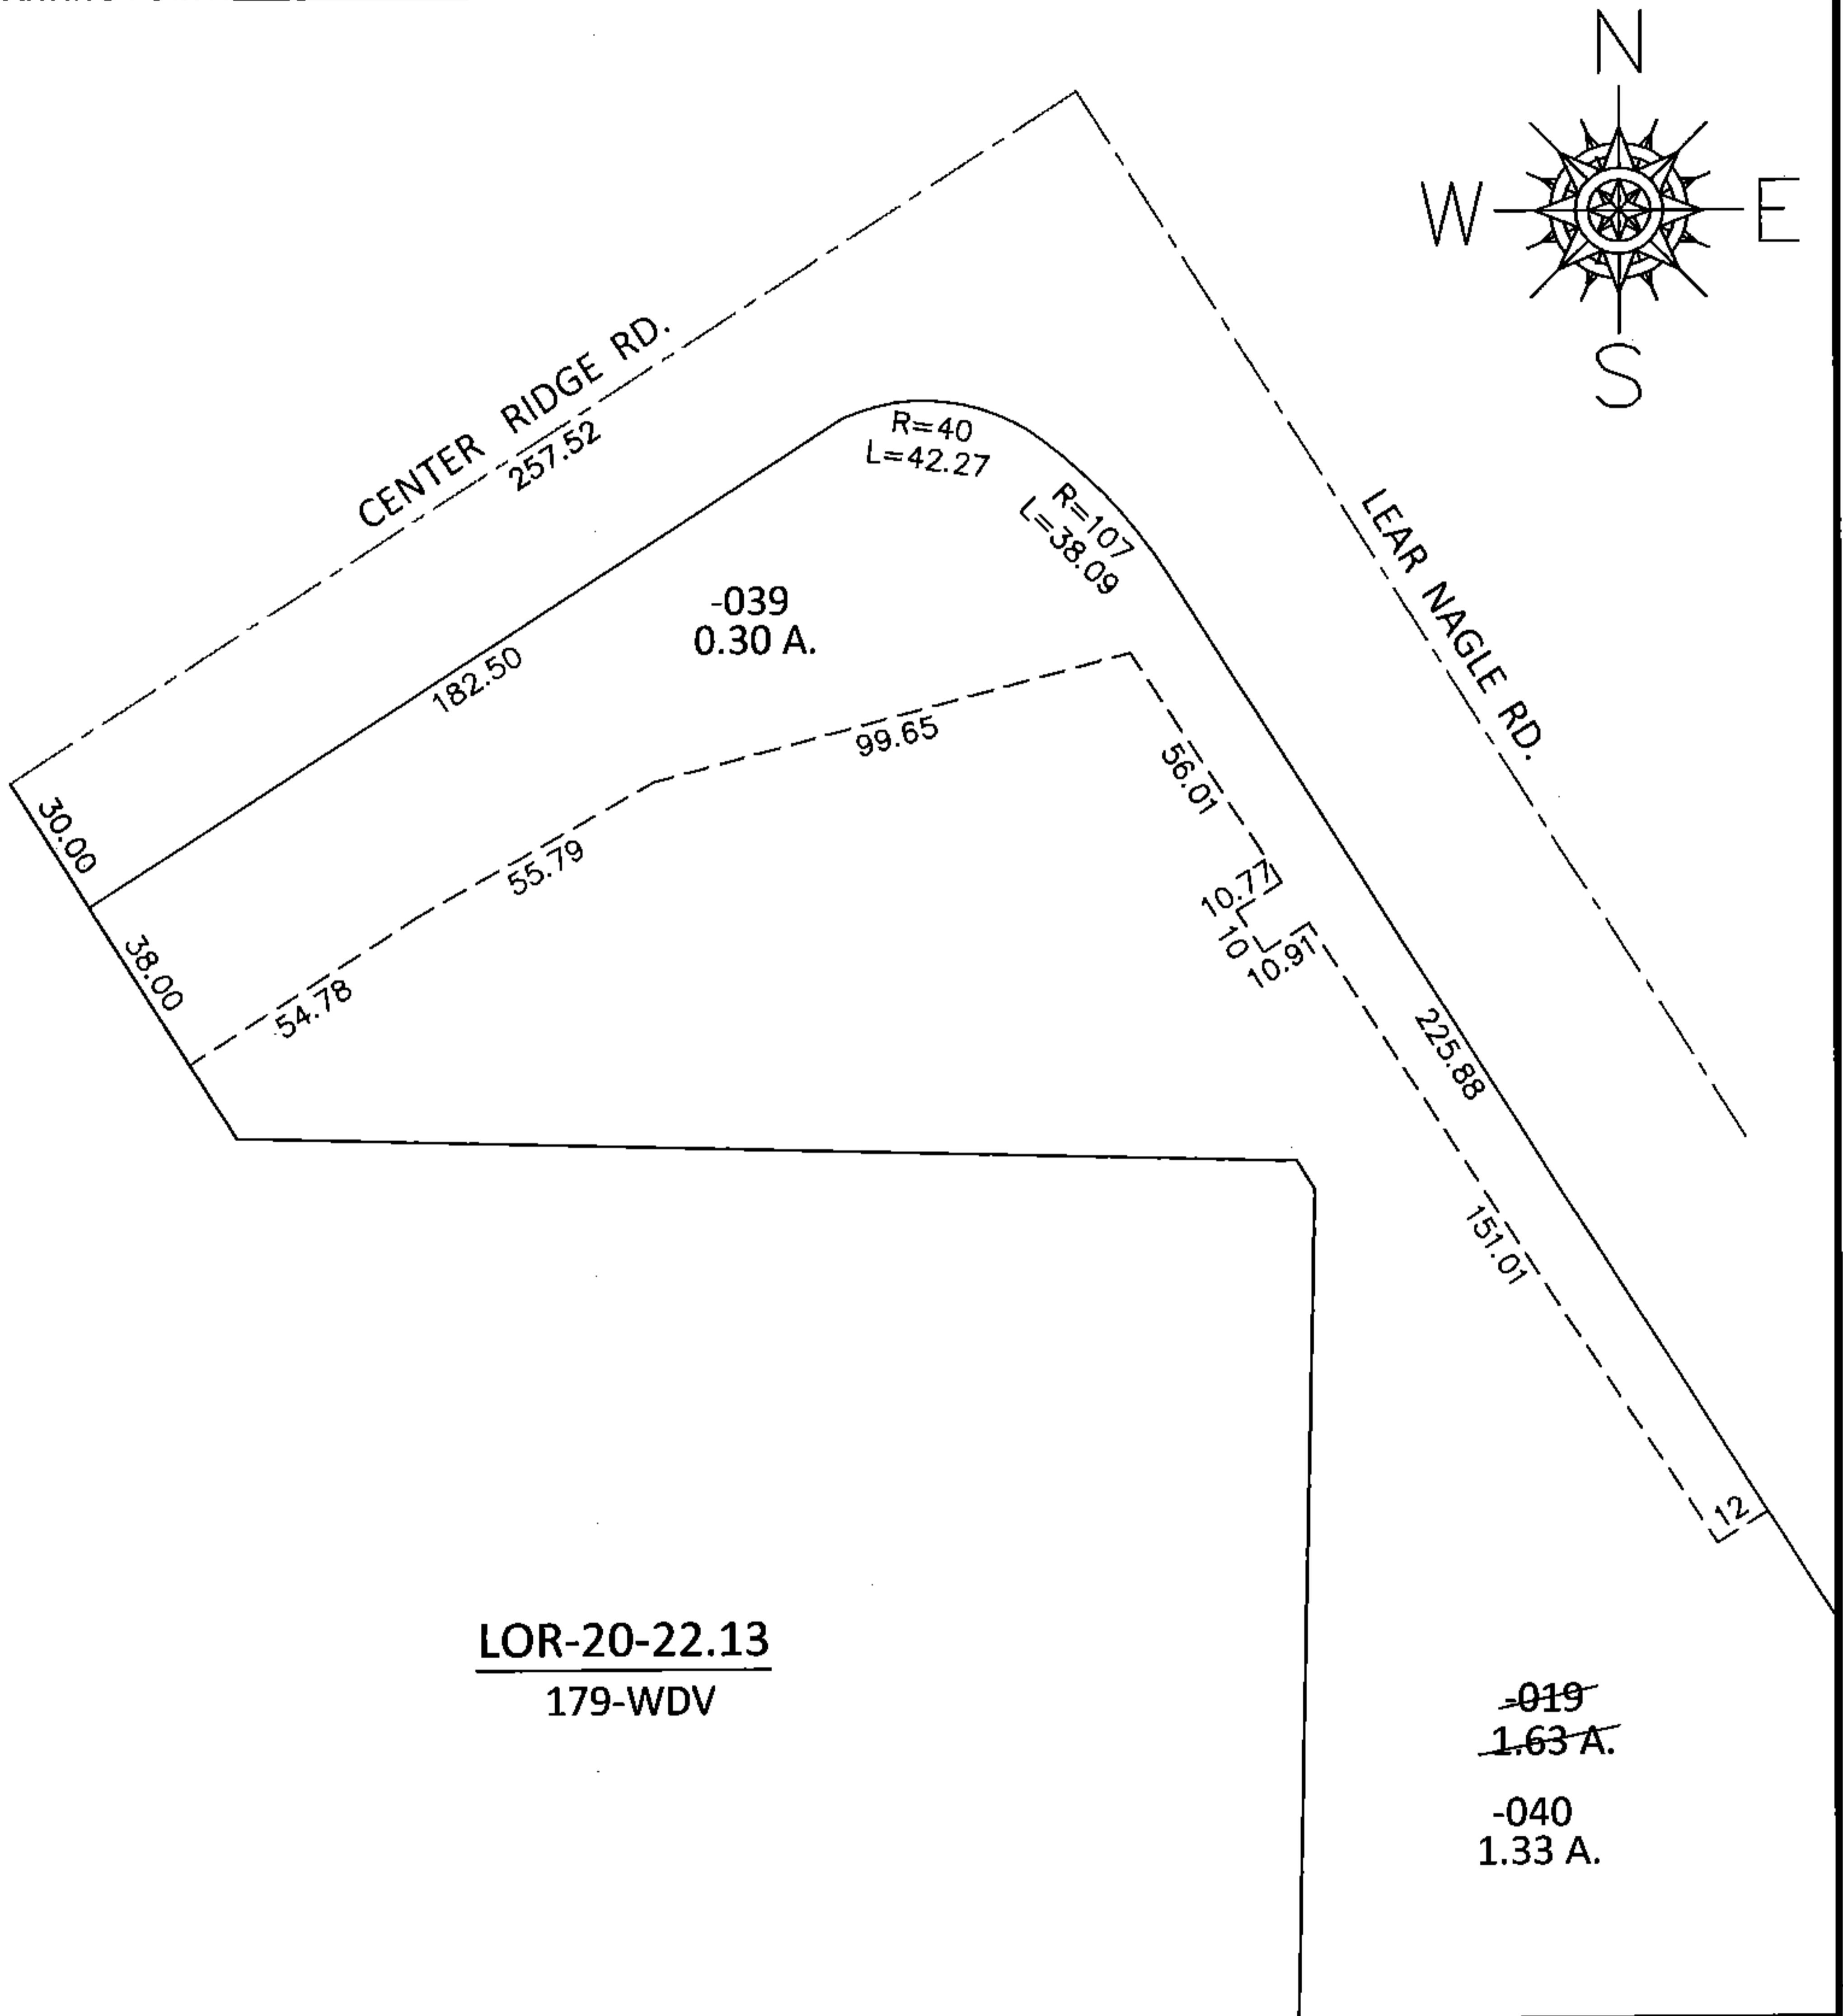

**SPLITS/DEEDS PROCESSED**

LORAIN COUNTY TAX MAP DEPARTMENT  
226 MIDDLE AVE. ELYRIA, OHIO

SURVEYED BY: WILLIAM D. THOMAS

CLOSURE: .01:10,000

MAP PAGE(S): 7-00-008-C

APPROVED BY: RRM DATE: 3-5-15

SCALE: 1"= 50' PRIOR INST.: 20050110074