
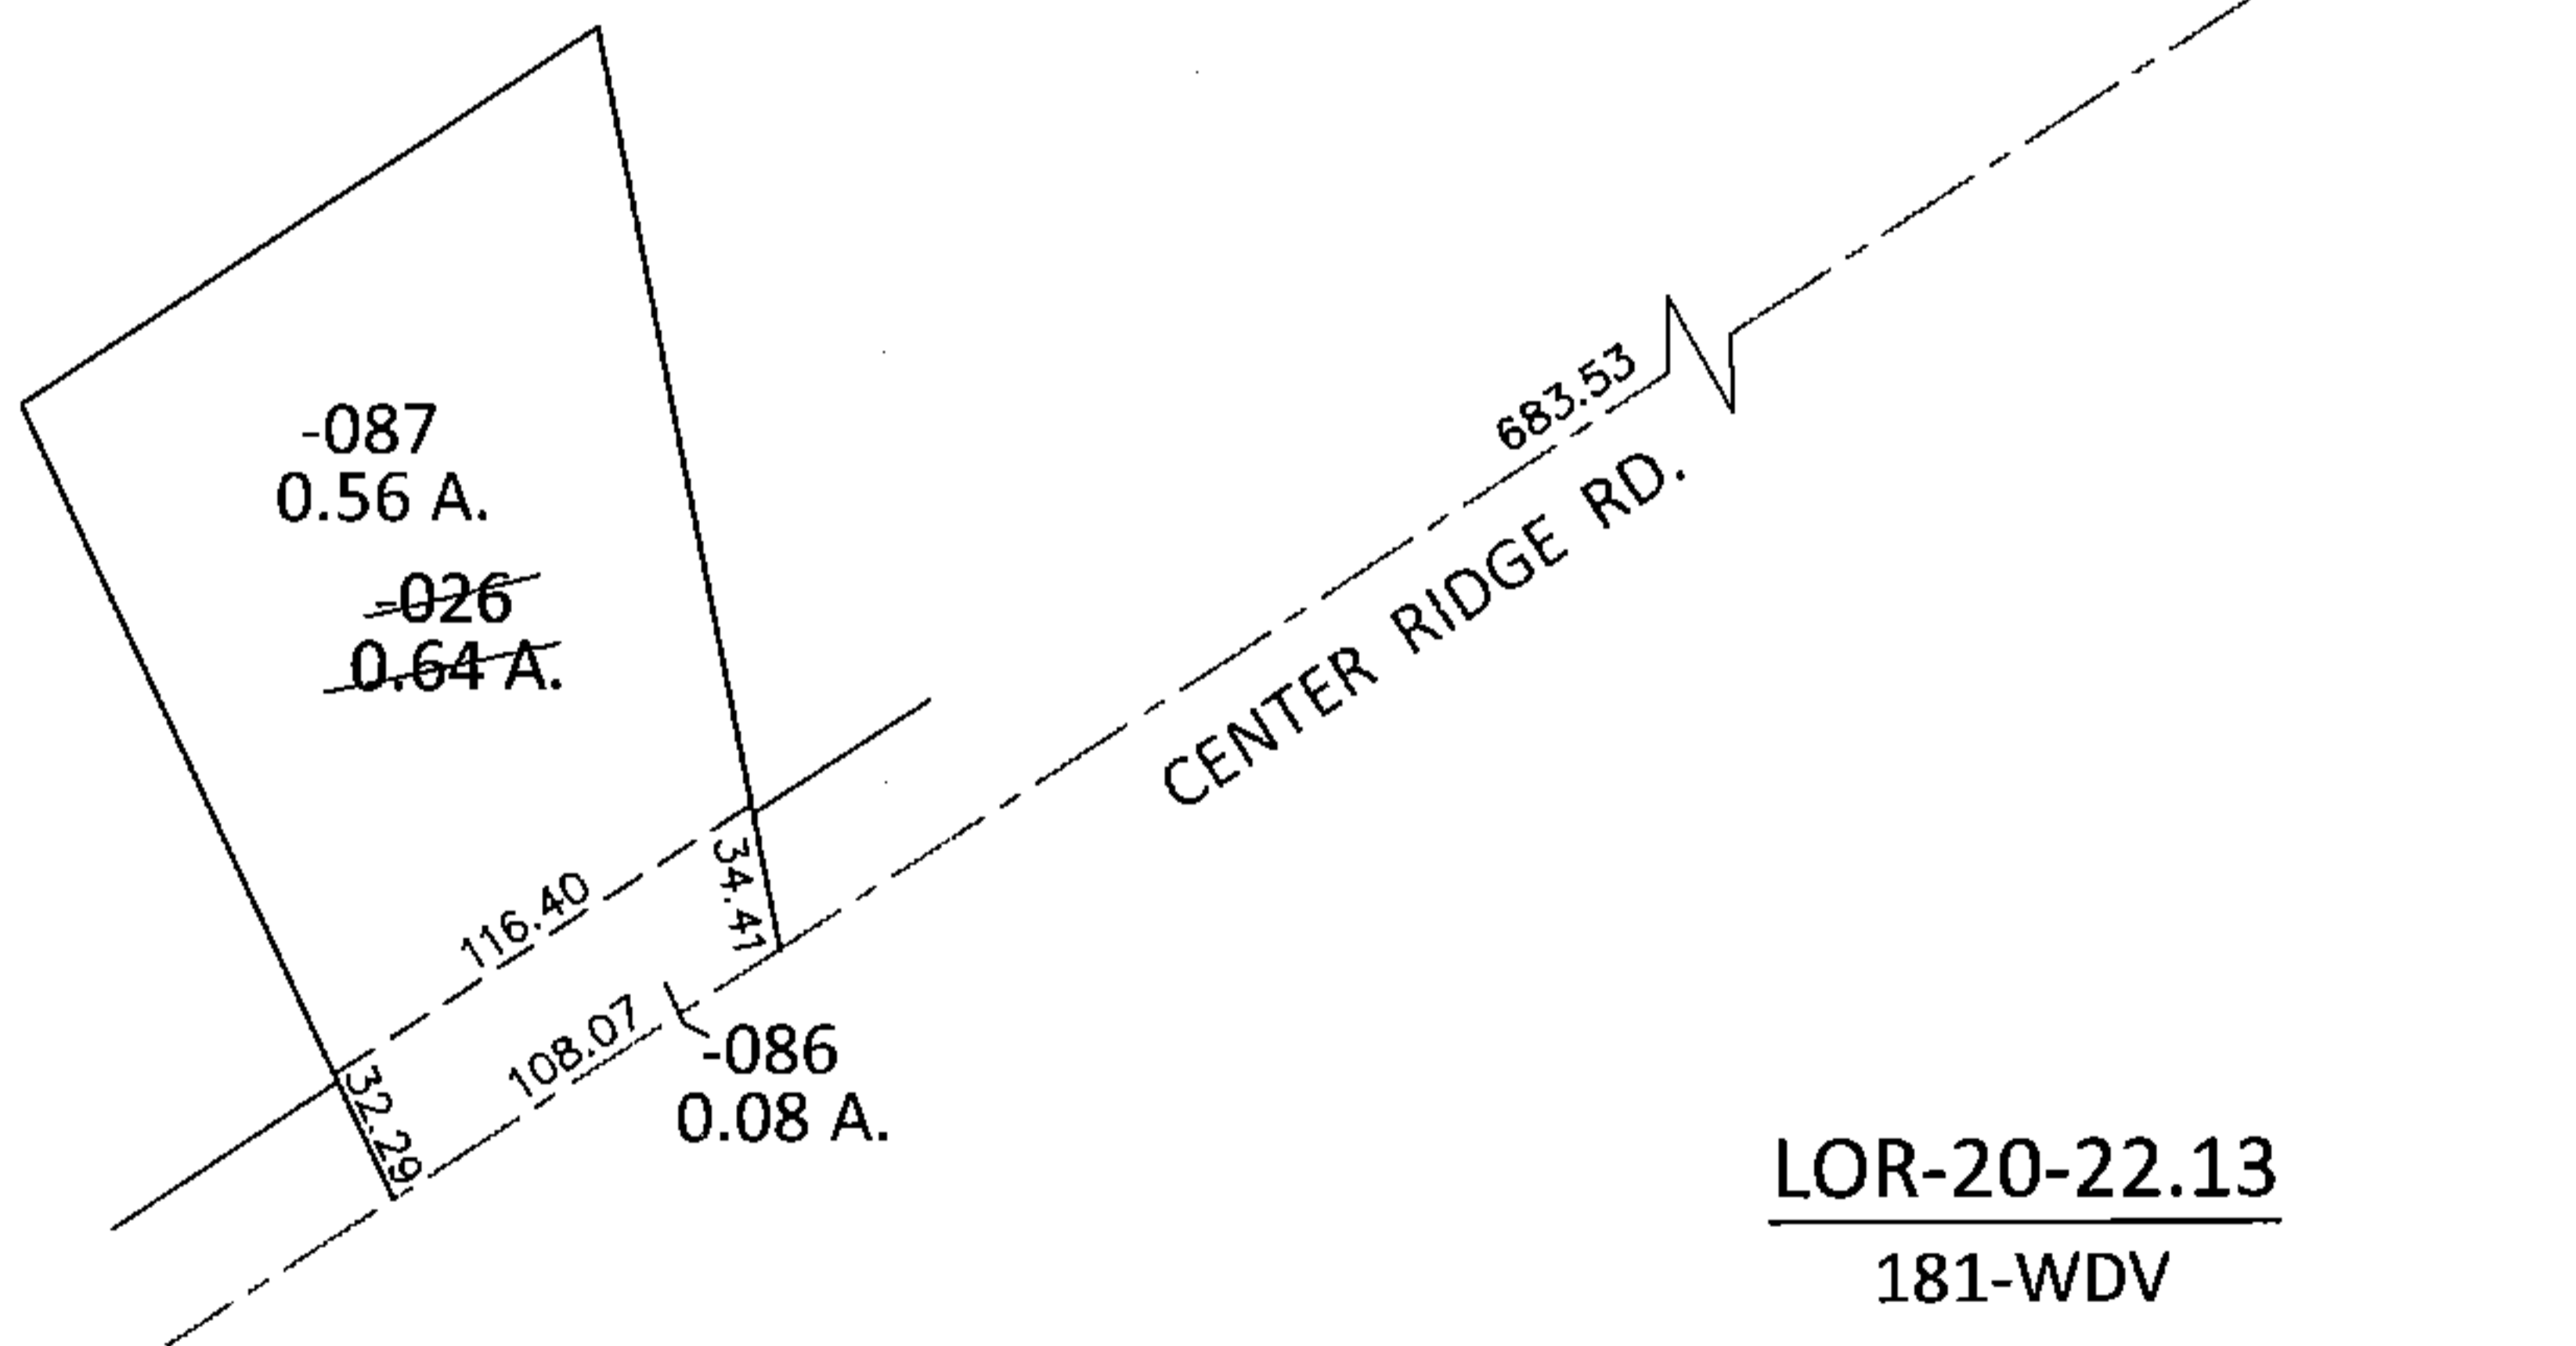


PARENT PARCEL: 07-00-008-117-026

CHILD PARCEL: 07-00-008-117-086, -087


STARTING POINT: INTERSECTION OF C/L OF CENTER RIDGE RD. AND C/L OF LEAR NAGLE RD.

14-00632

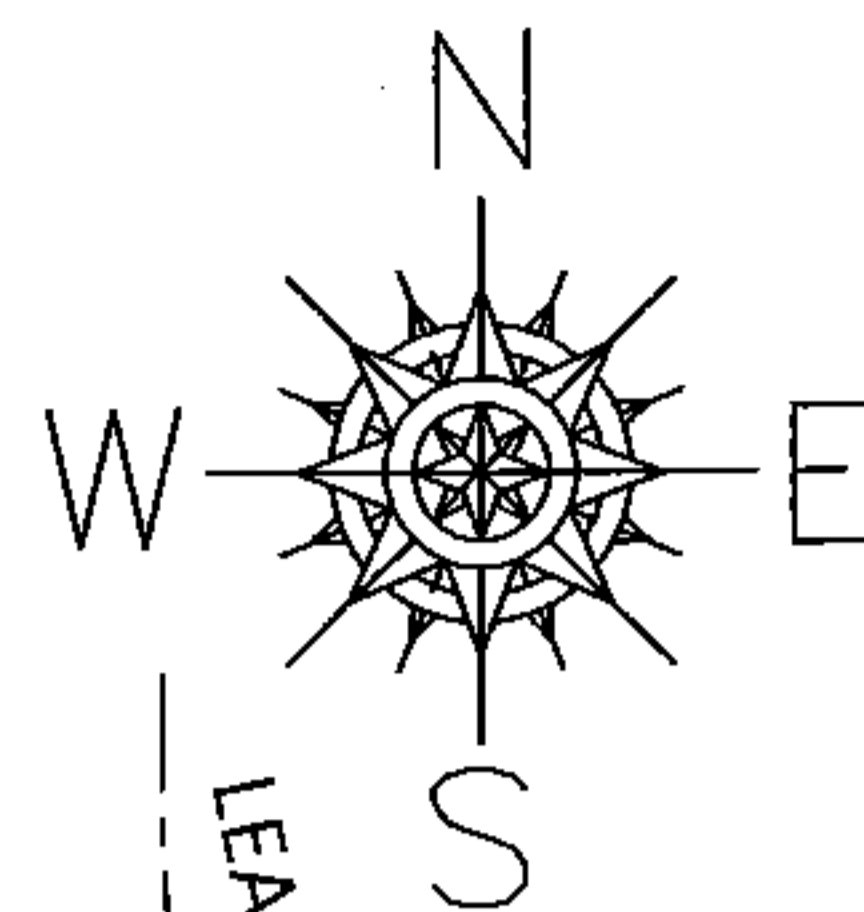

LOR-20-22.13

181-WDV

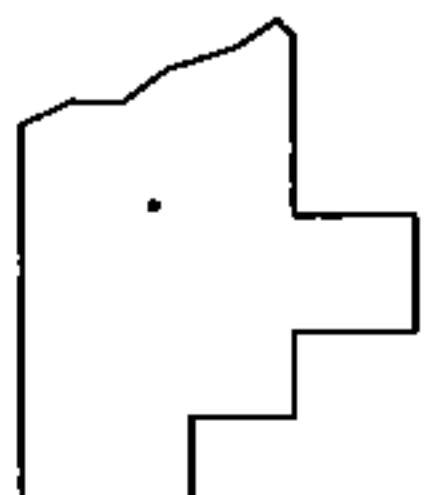

SPLITS/DEEDS PROCESSED

LORAIN COUNTY TAX MAP DEPARTMENT  
226 MIDDLE AVE. ELYRIA, OHIO

SURVEYED BY: WILLIAM D. THOMAS

CLOSURE: .01:10,000

MAP PAGE(S): 7-00-008-C

APPROVED BY: RRM DATE: 3-9-15

SCALE: 1"=100 PRIOR INST.: 20070236220