
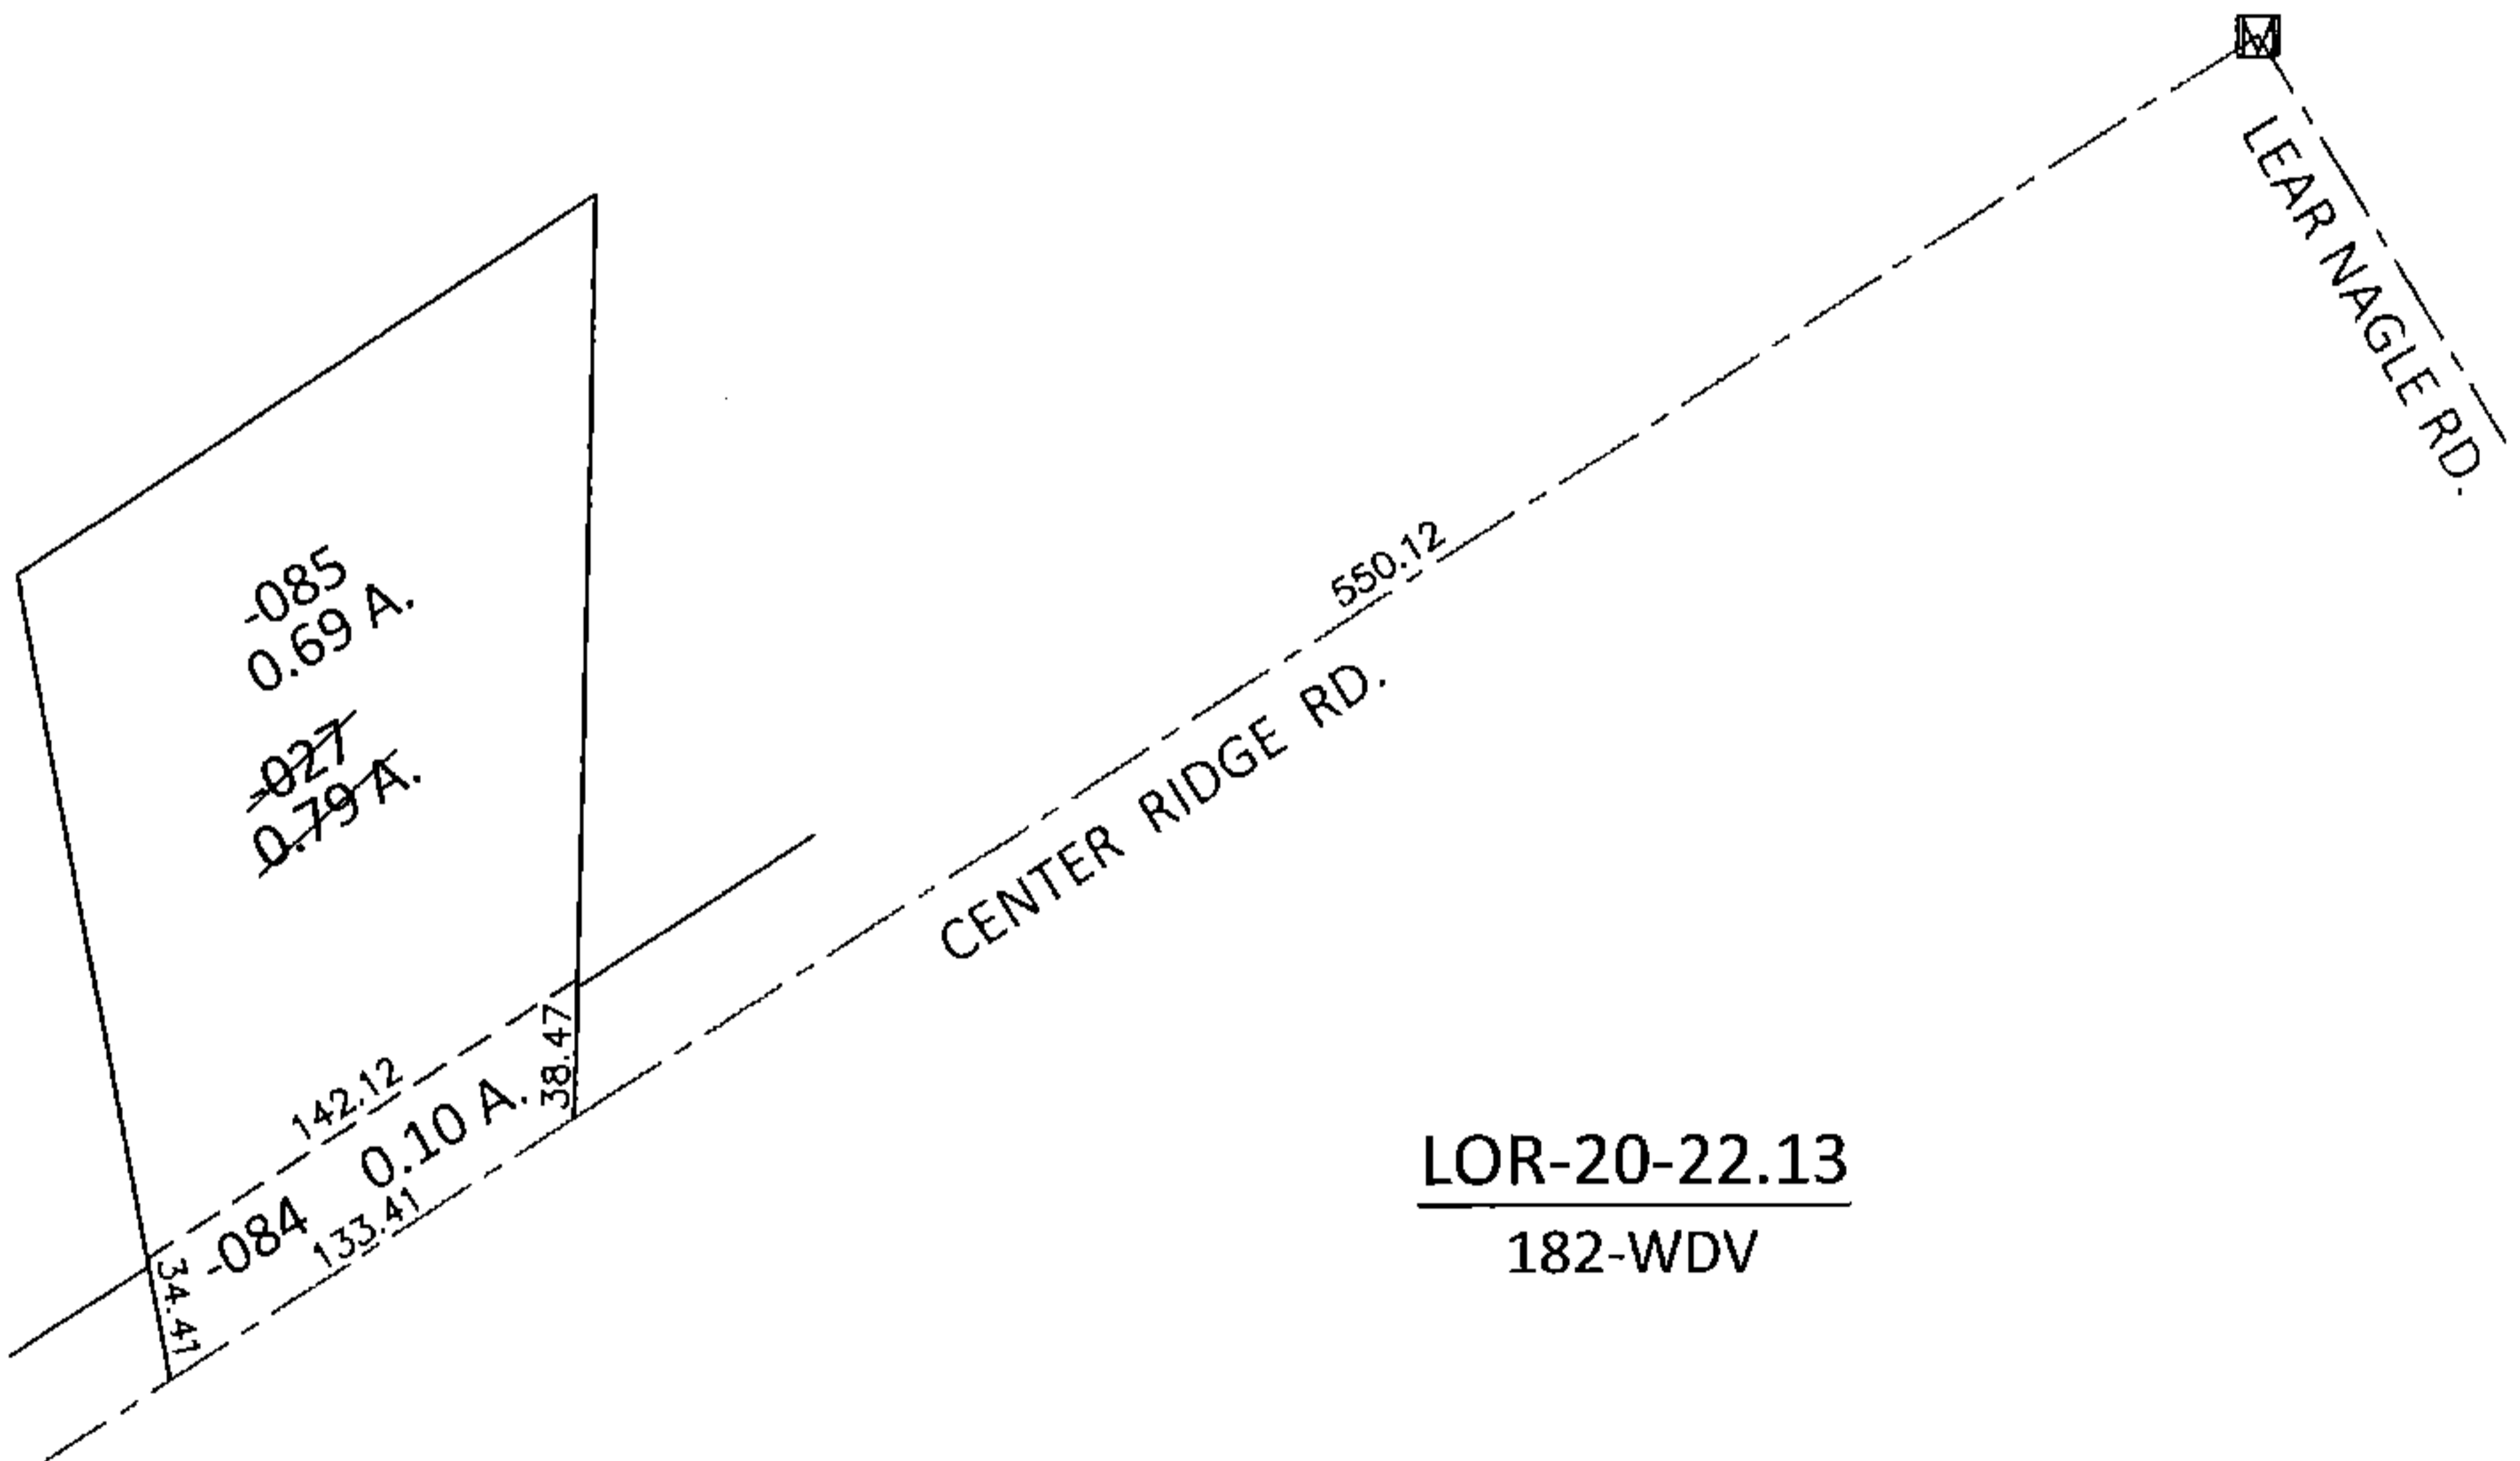


PARENT PARCEL: 07-00-008-117-027


CHILD PARCEL: 07-00-008-117-084, -085

14-00633

STARTING POINT: AT A MON BOX AT THE INTERSECTION OF C/L OF CENTER RIDGE RD. AND C/L OF LEAR NAGLE RD.

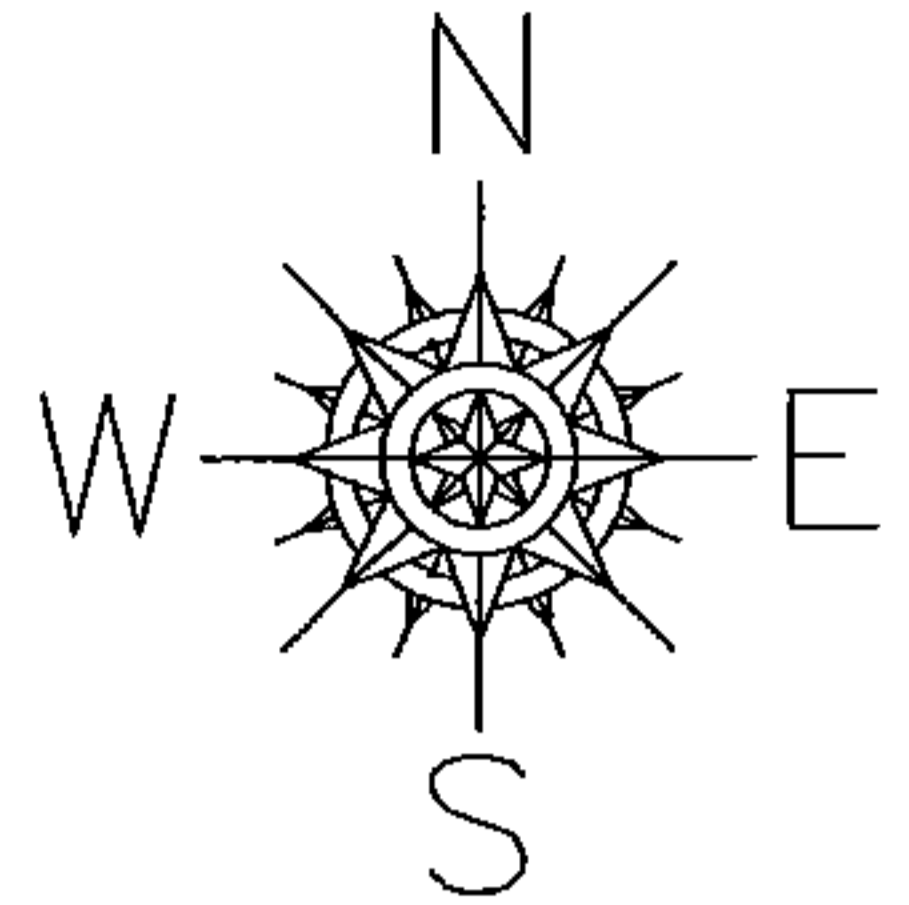

LOR-20-22.13
182-WDV

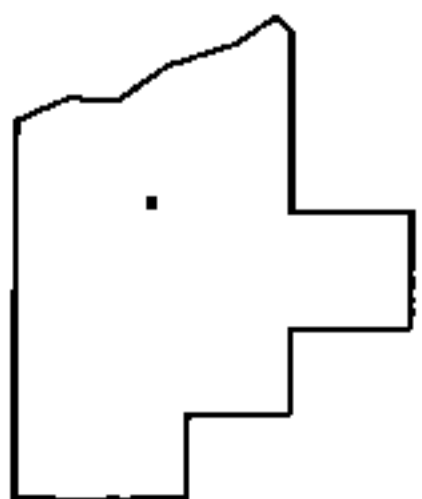

SPLITS/DEEDS PROCESSED

LORAIN COUNTY TAX MAP DEPARTMENT
226 MIDDLE AVE. ELYRIA, OHIO

SURVEYED BY: WILLIAM D. THOMAS
 CLOSURE: .01:10,000
 MAP PAGE(S): 7-00-008-C
 APPROVED BY: RRM DATE: 10-21-14
 SCALE: 1"= 100 PRIOR INST.: 19980563779