
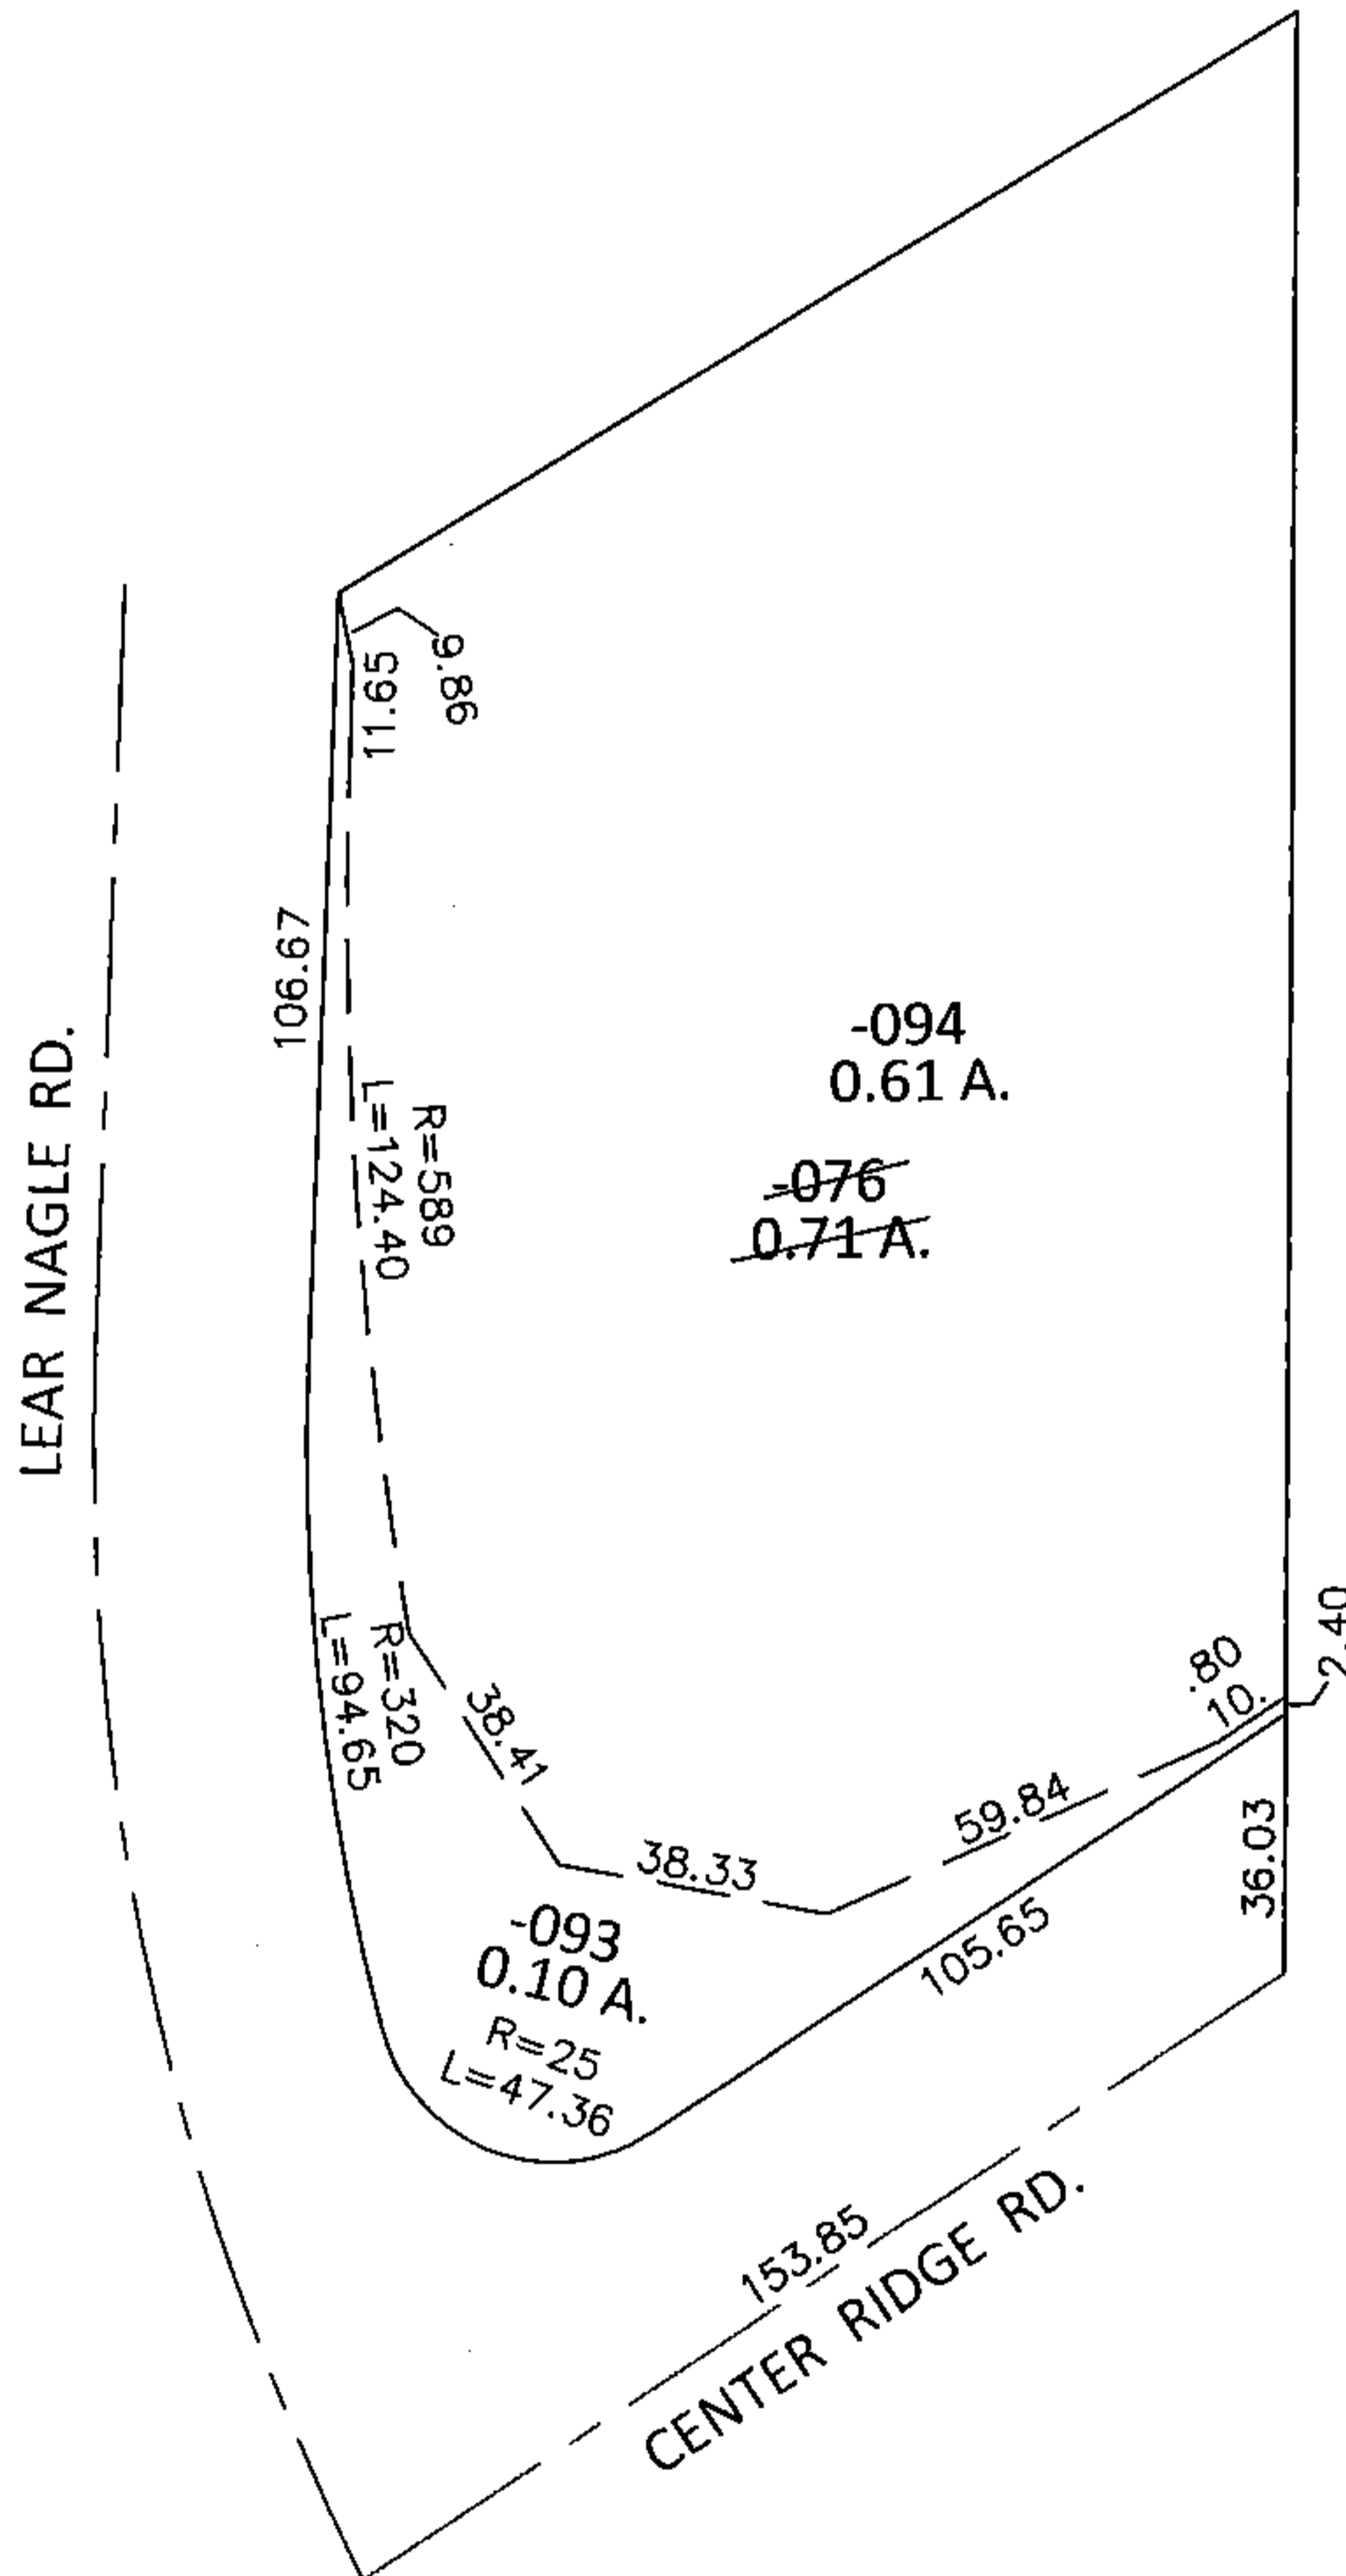


PARENT PARCEL: 07-00-008-117-076


CHILD PARCEL: 07-00-008-117-093, -094

STARTING POINT: INTERSECTION OF C/L OF CENTER RIDGE RD. AND C/L OF LEAR NAGLE RD.

14-00637

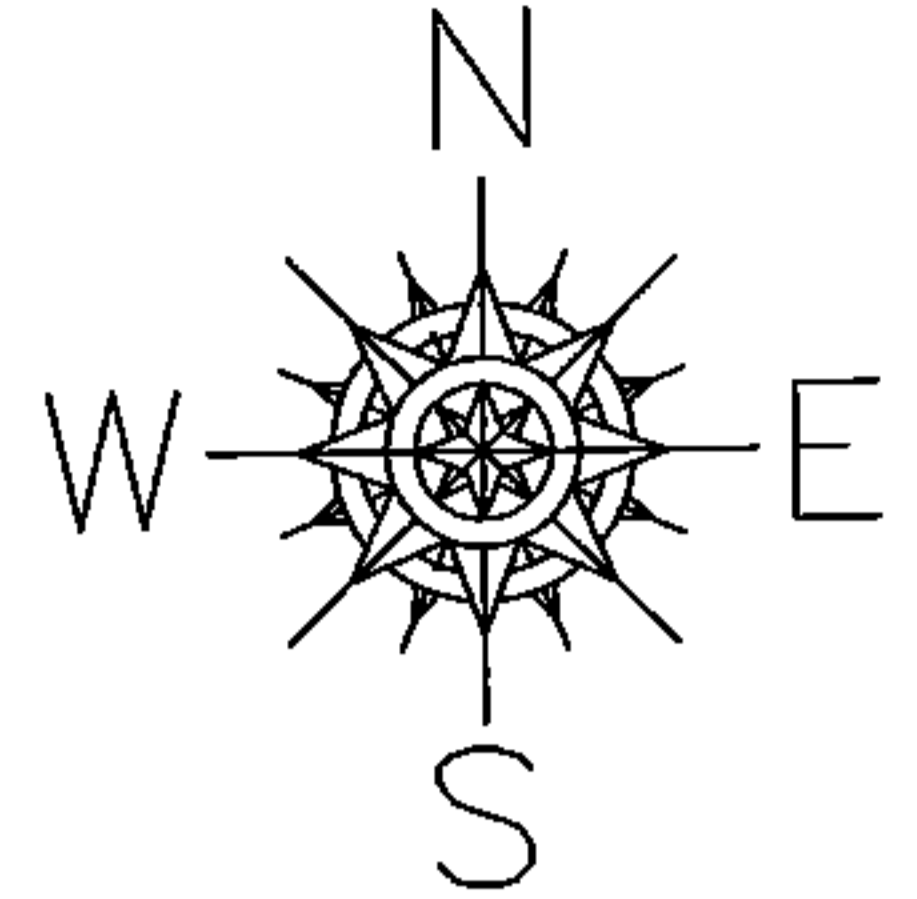

LOR-20-22.13
187-WDV

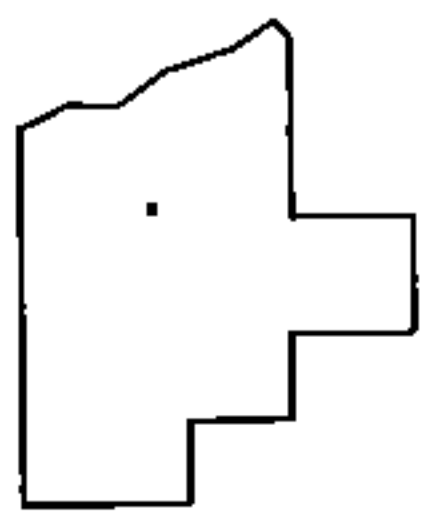

SPLITS/DEEDS PROCESSED

LORAIN COUNTY TAX MAP DEPARTMENT
226 MIDDLE AVE. ELYRIA, OHIO

SURVEYED BY: WILLIAM D. THOMAS
 CLOSURE: .01:10,000
 MAP PAGE(S): 7-00-008-C
 APPROVED BY: RRM DATE: 3-12-15
 SCALE: 1"= 50 PRIOR INST.: 20080237037