



PARENT PARCEL: 07-00-008-111-029 THRU -033
 CHILD PARCEL: 07-00-008-111-084 THRU -089
 STARTING POINT: INTERSECTION OF C/L OF CENTER RIDGE RD. AND C/L OF LEAR NAGLE RD.


14-00639

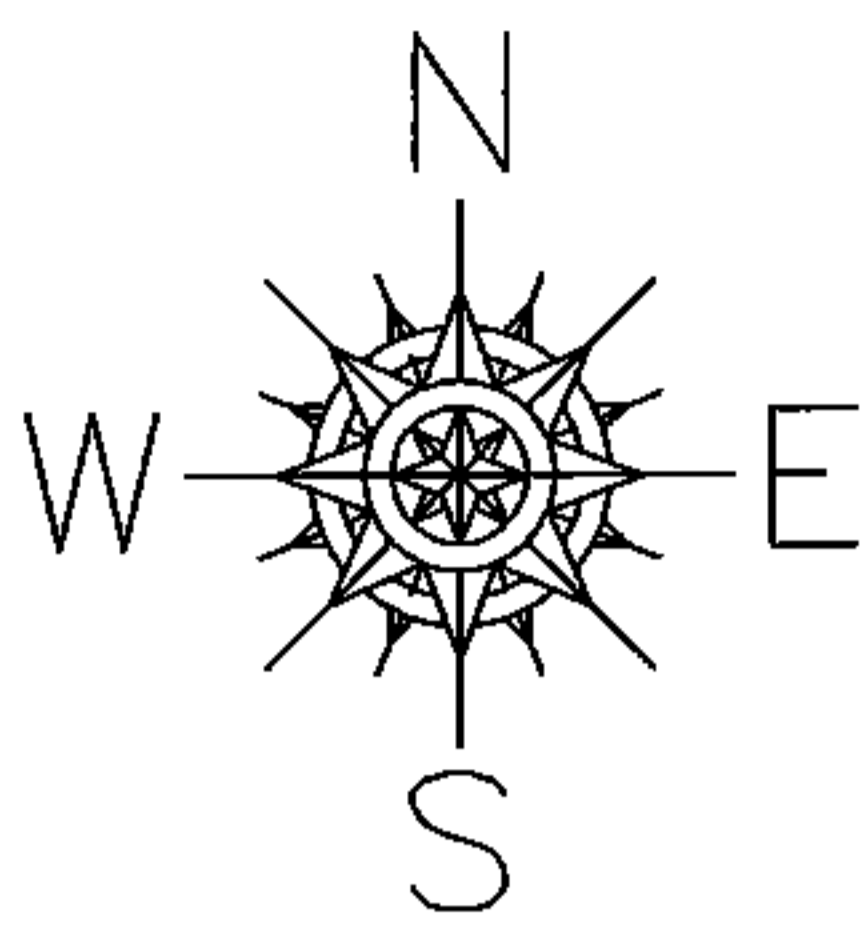

07-00-008-111-029	07-00-008-111-084
62 X 115	0.02 A.
07-00-008-111-030	07-00-008-111-085
20 X 123	57.86 X 88.48
07-00-008-111-031	07-00-008-111-086
20 X 134	20 X 118.14
07-00-008-111-032	07-00-008-111-087
20 X 101	20 X 122.92
07-00-008-111-033	07-00-008-111-088
65 X 119	20 X 122.92
	07-00-008-111-089
	55.36 X 90.29

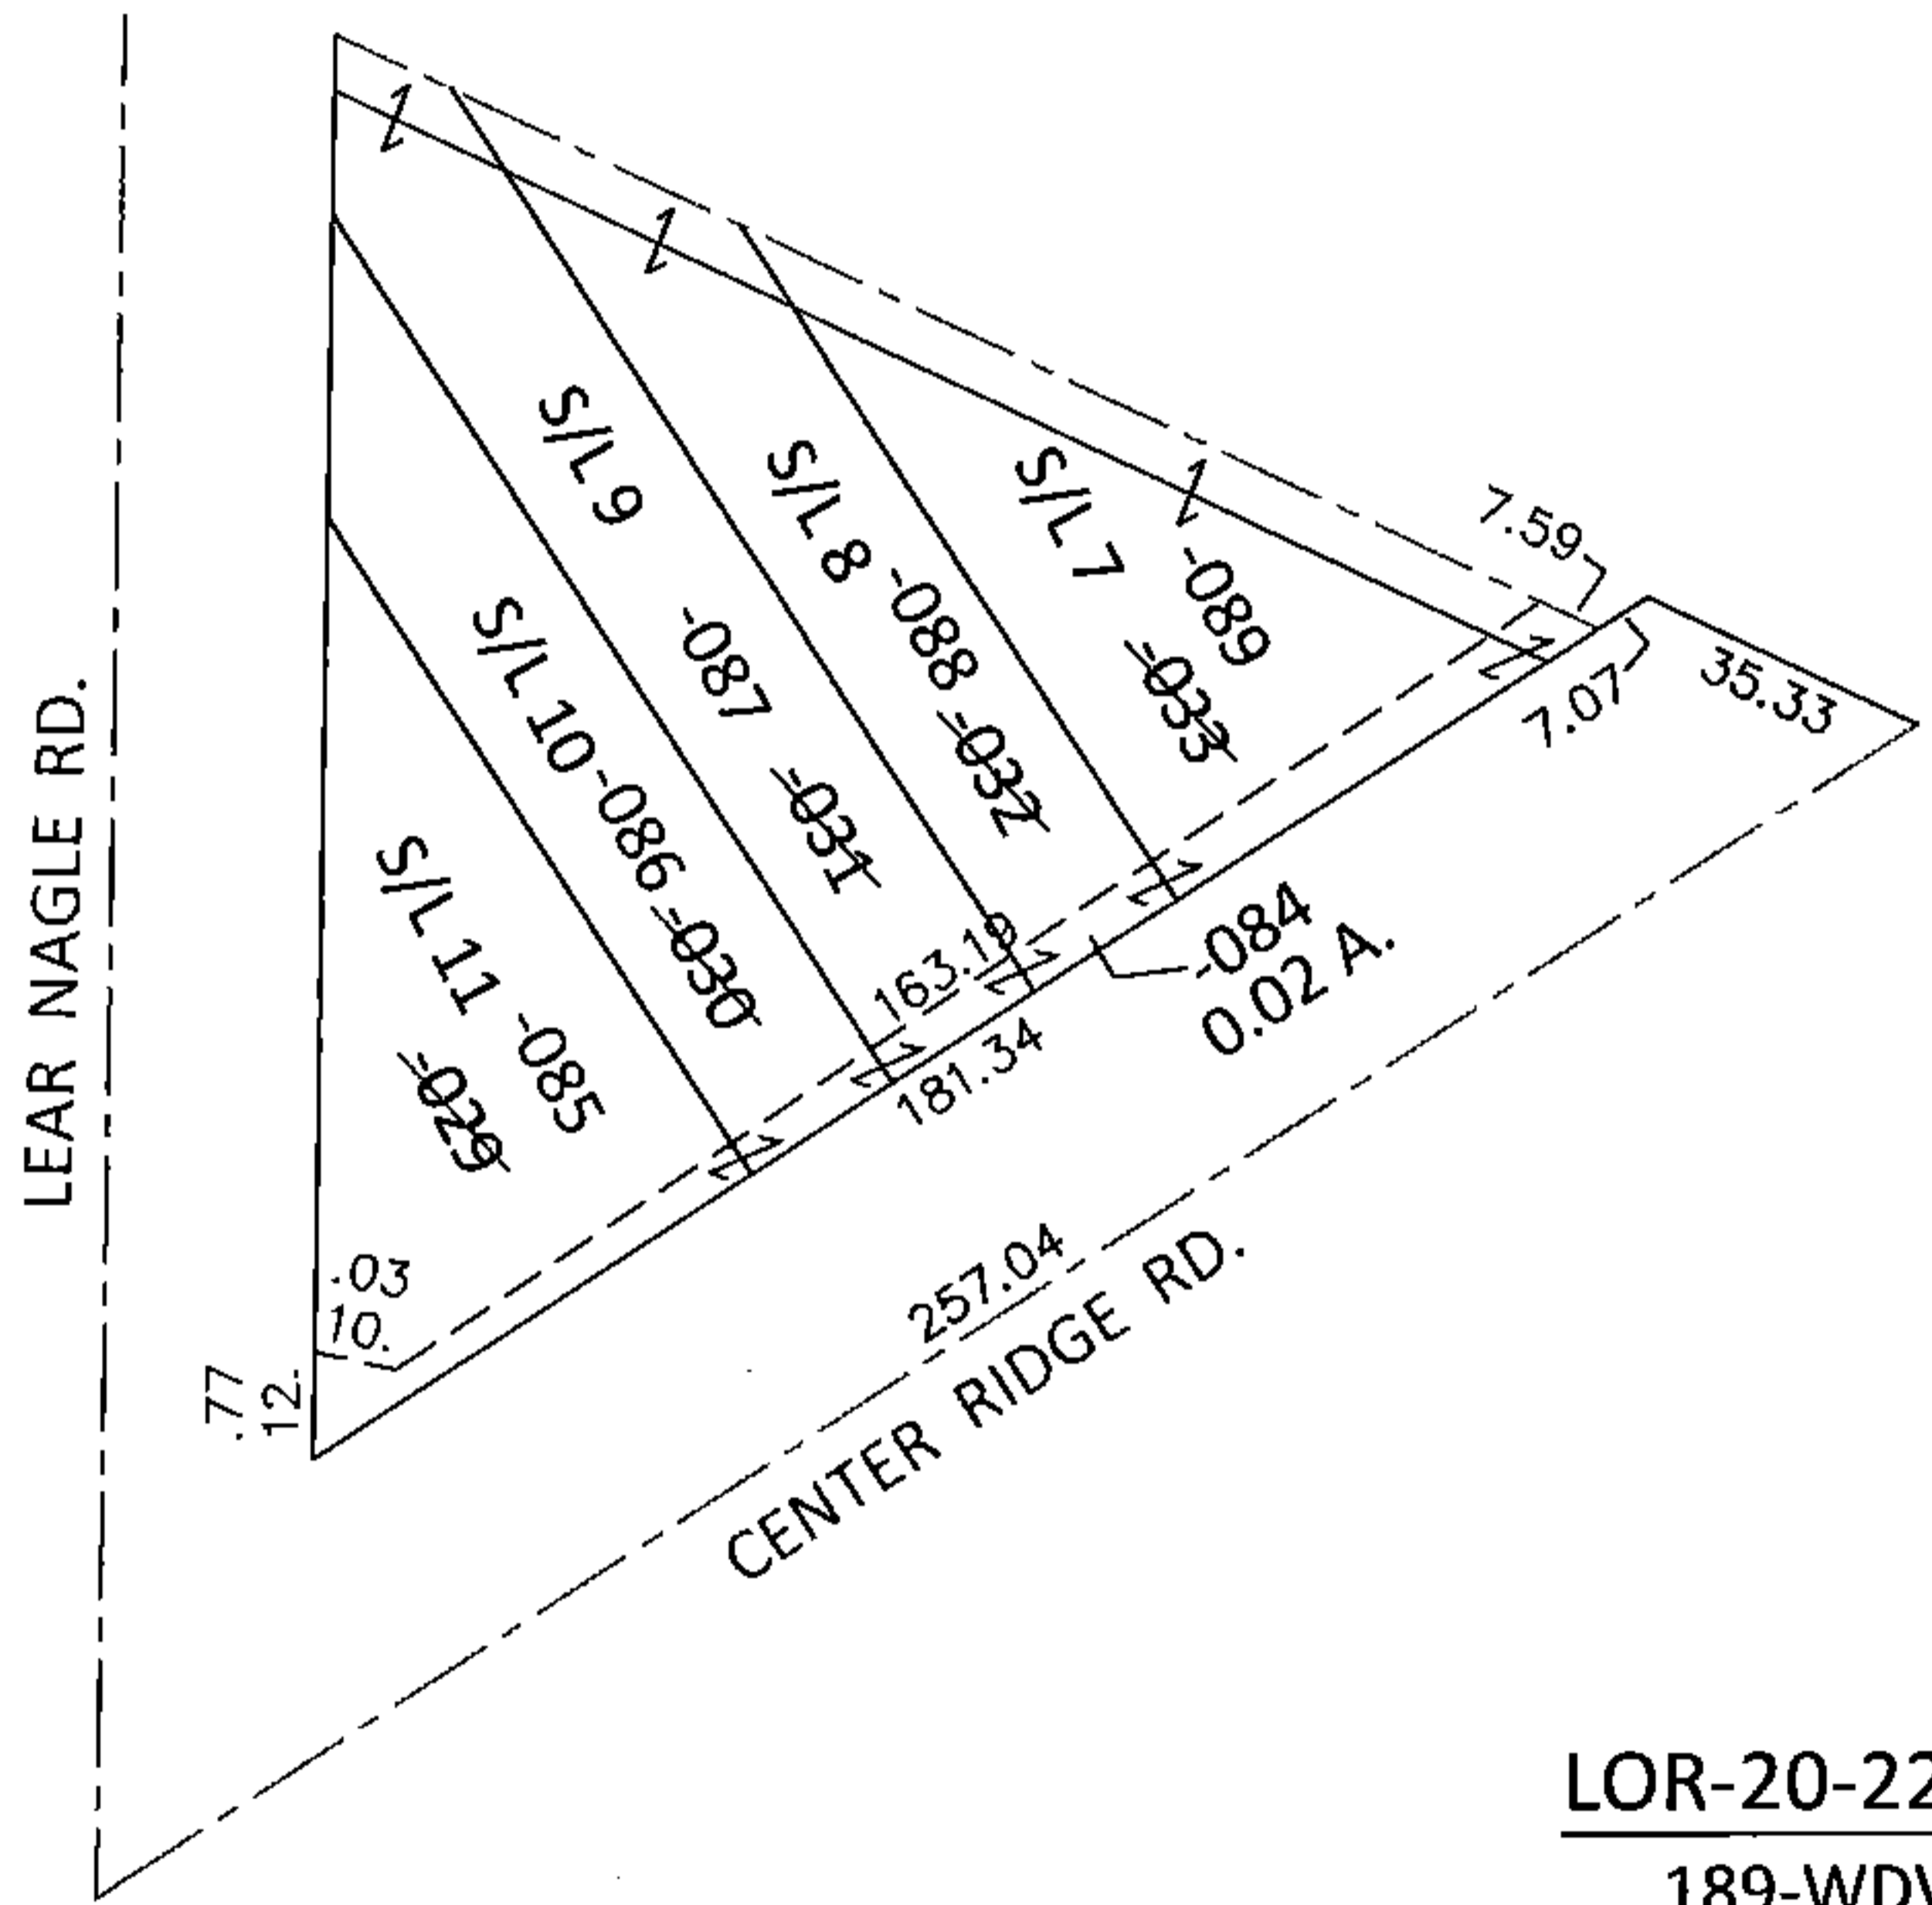

LOR-20-22.13
 189-WDV

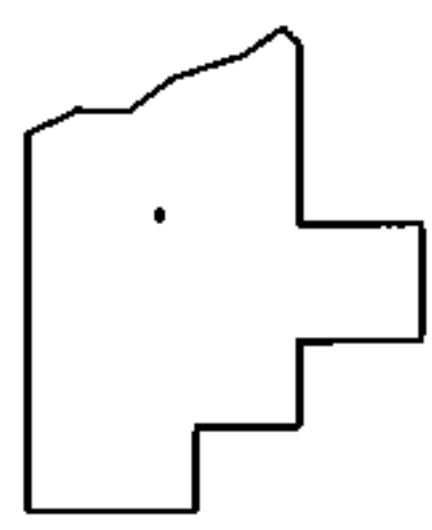

SPLITS/DEEDS PROCESSED
 LORAIN COUNTY TAX MAP DEPARTMENT
 226 MIDDLE AVE. ELYRIA, OHIO

SURVEYED BY: WILLIAM D. THOMAS
 CLOSURE: .01:10,000
 MAP PAGE(S): 7-00-008-C
 APPROVED BY: RRM DATE: 3-30-15
 SCALE: 1"= 50 PRIOR INST.: DV 1392/874