
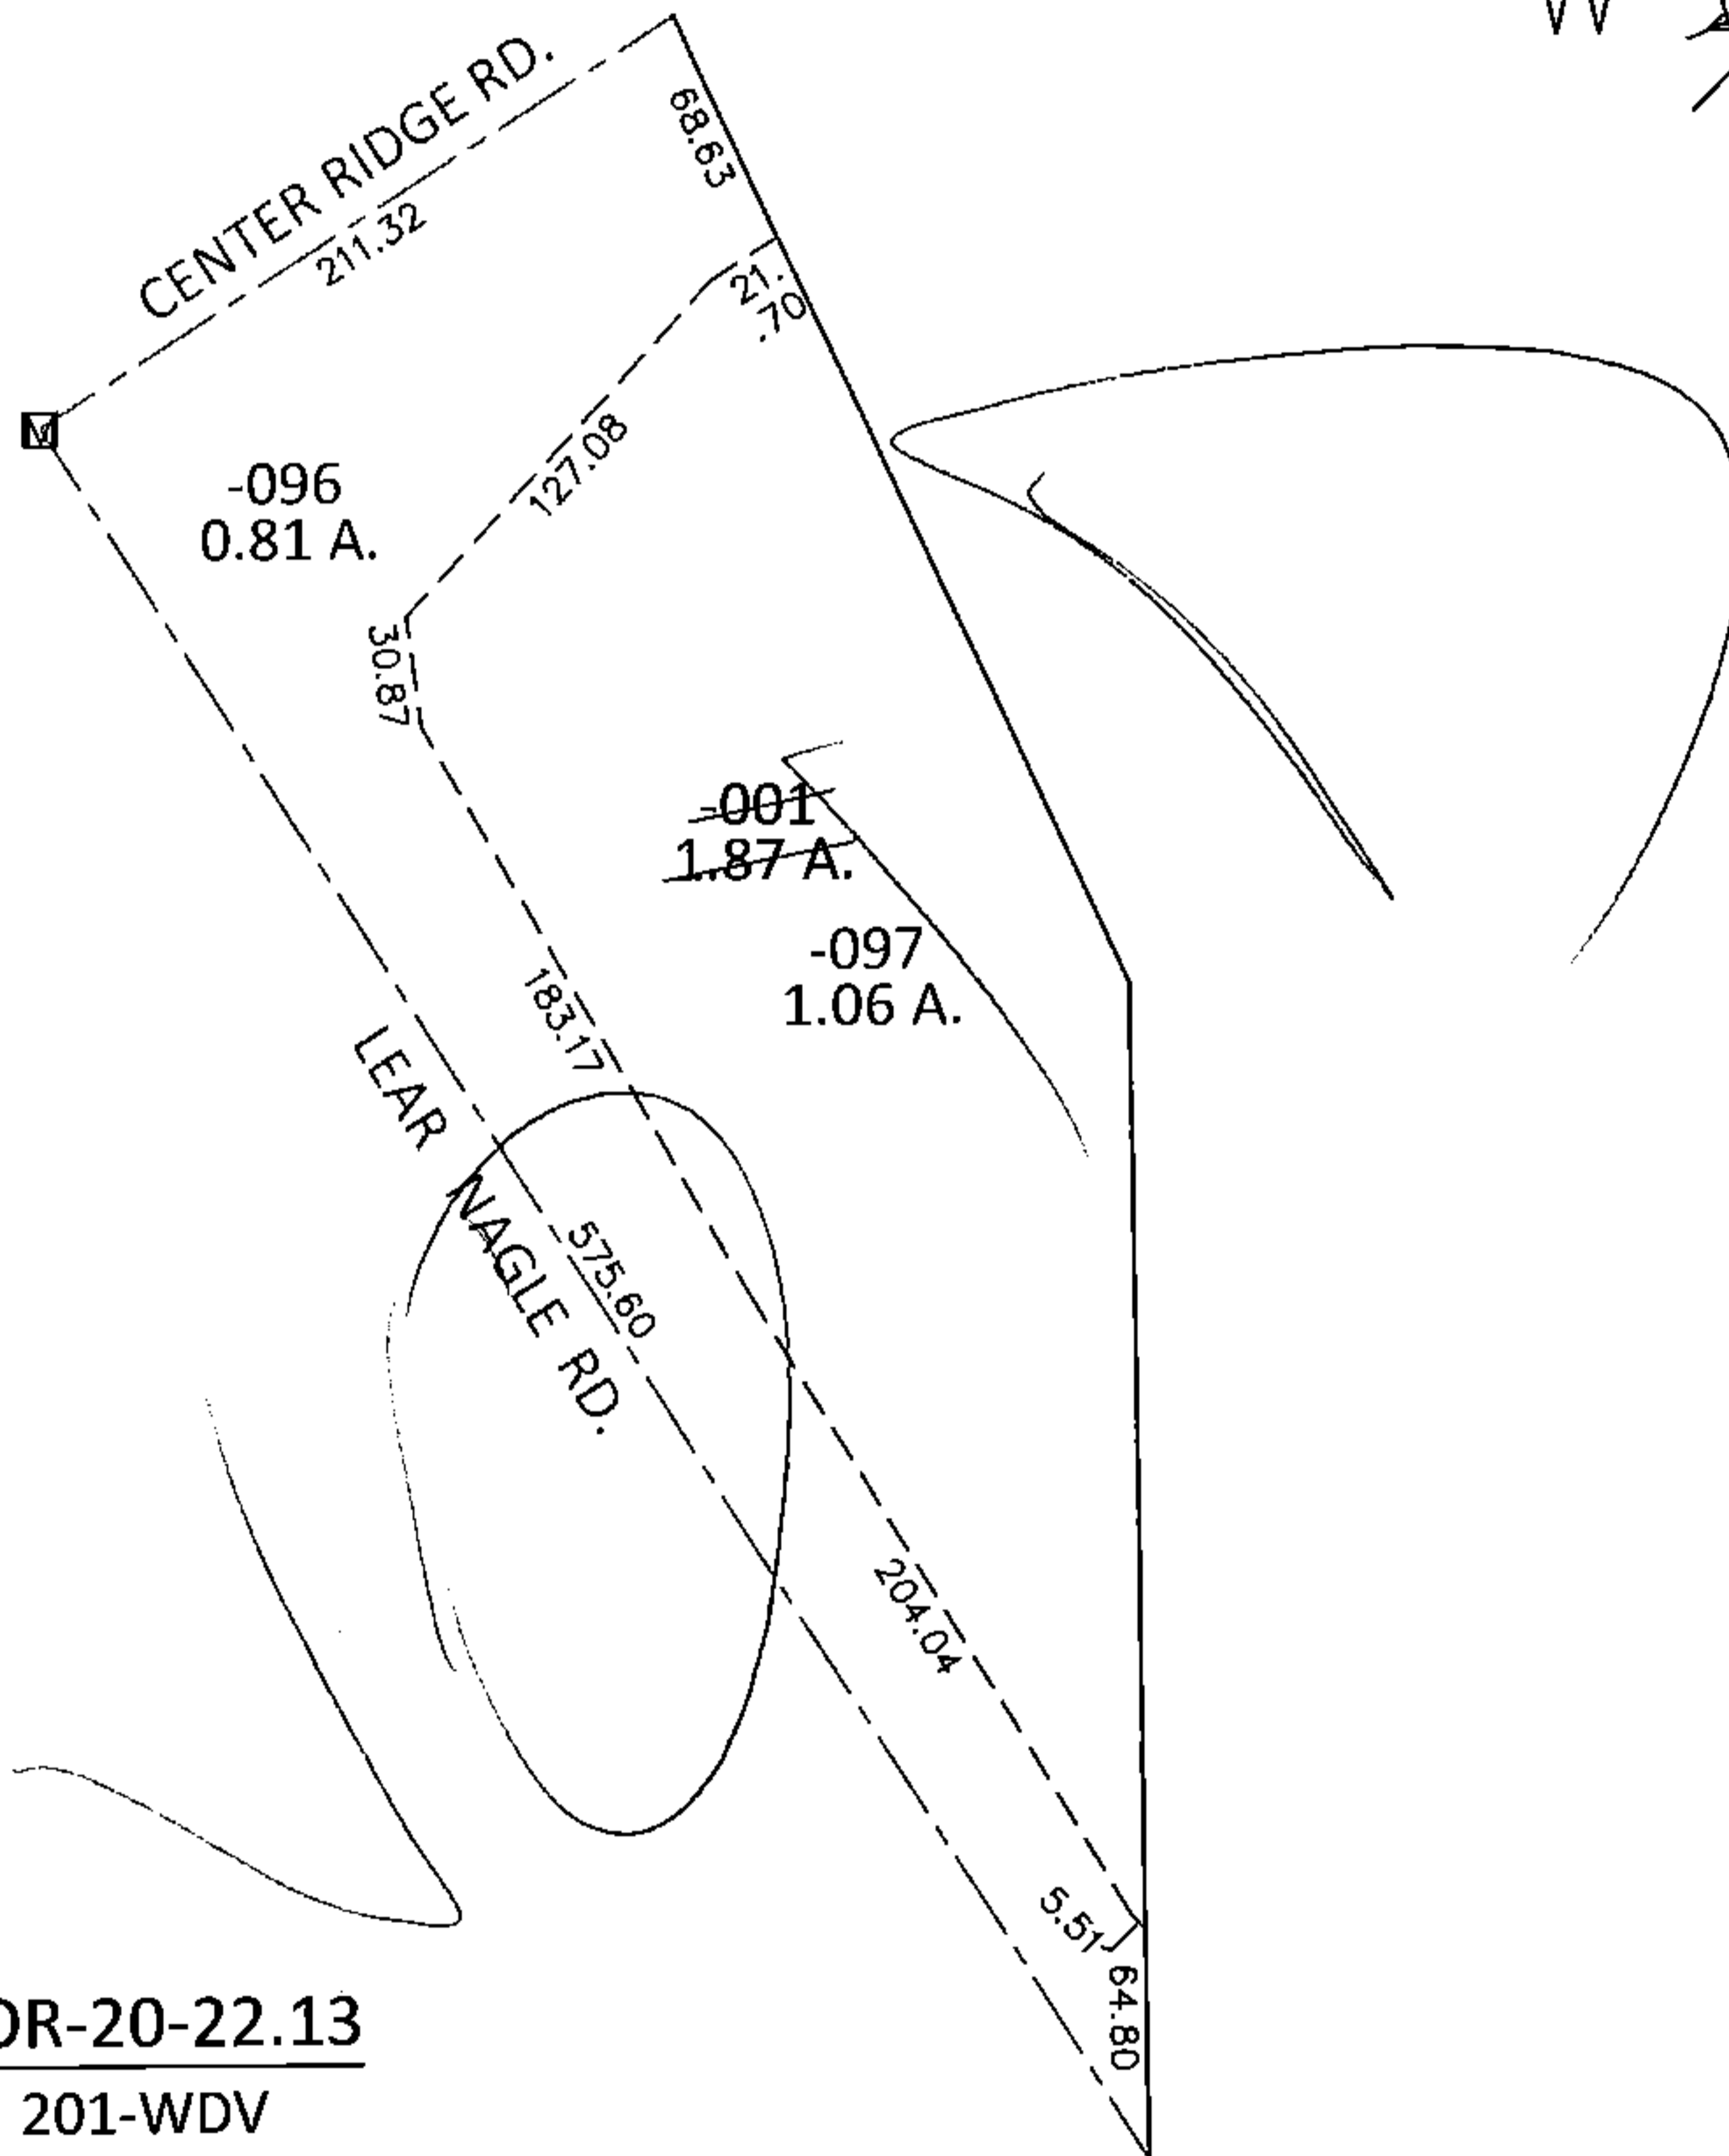


PARENT PARCEL: 07-00-008-115-001

CHILD PARCEL: 07-00-008-115-096, -097


STARTING POINT: AT A MON BOX AT THE INTERSECTION OF C/L OF LEAR NAGLE RD. AND C/L OF CENTER RIDGE RD.

14-00640

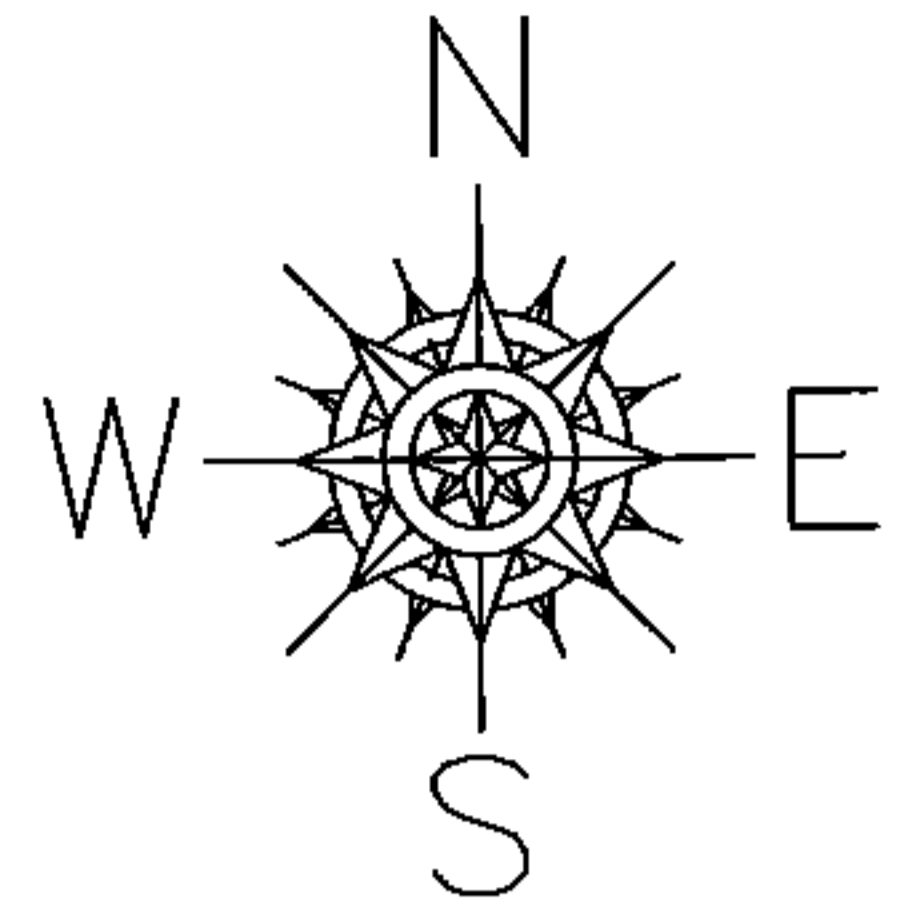

LOR-20-22.13

201-WDV

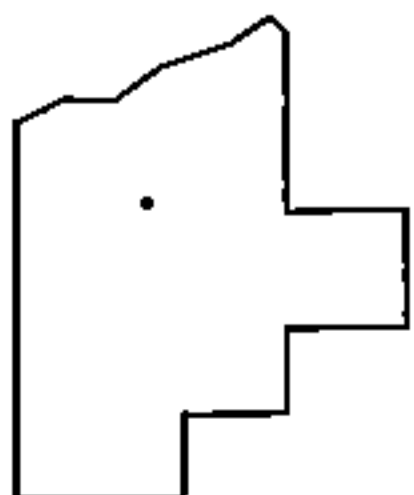

SPLITS/DEEDS PROCESSED

LORAIN COUNTY TAX MAP DEPARTMENT
226 MIDDLE AVE. ELYRIA, OHIO

SURVEYED BY: WILLIAM D. THOMAS

CLOSURE: .01:10,000

MAP PAGE(S): 7-00-008-C

APPROVED BY: RRM DATE: 9-10-14

SCALE: 1"= 100 PRIOR INST.: 20040035083