
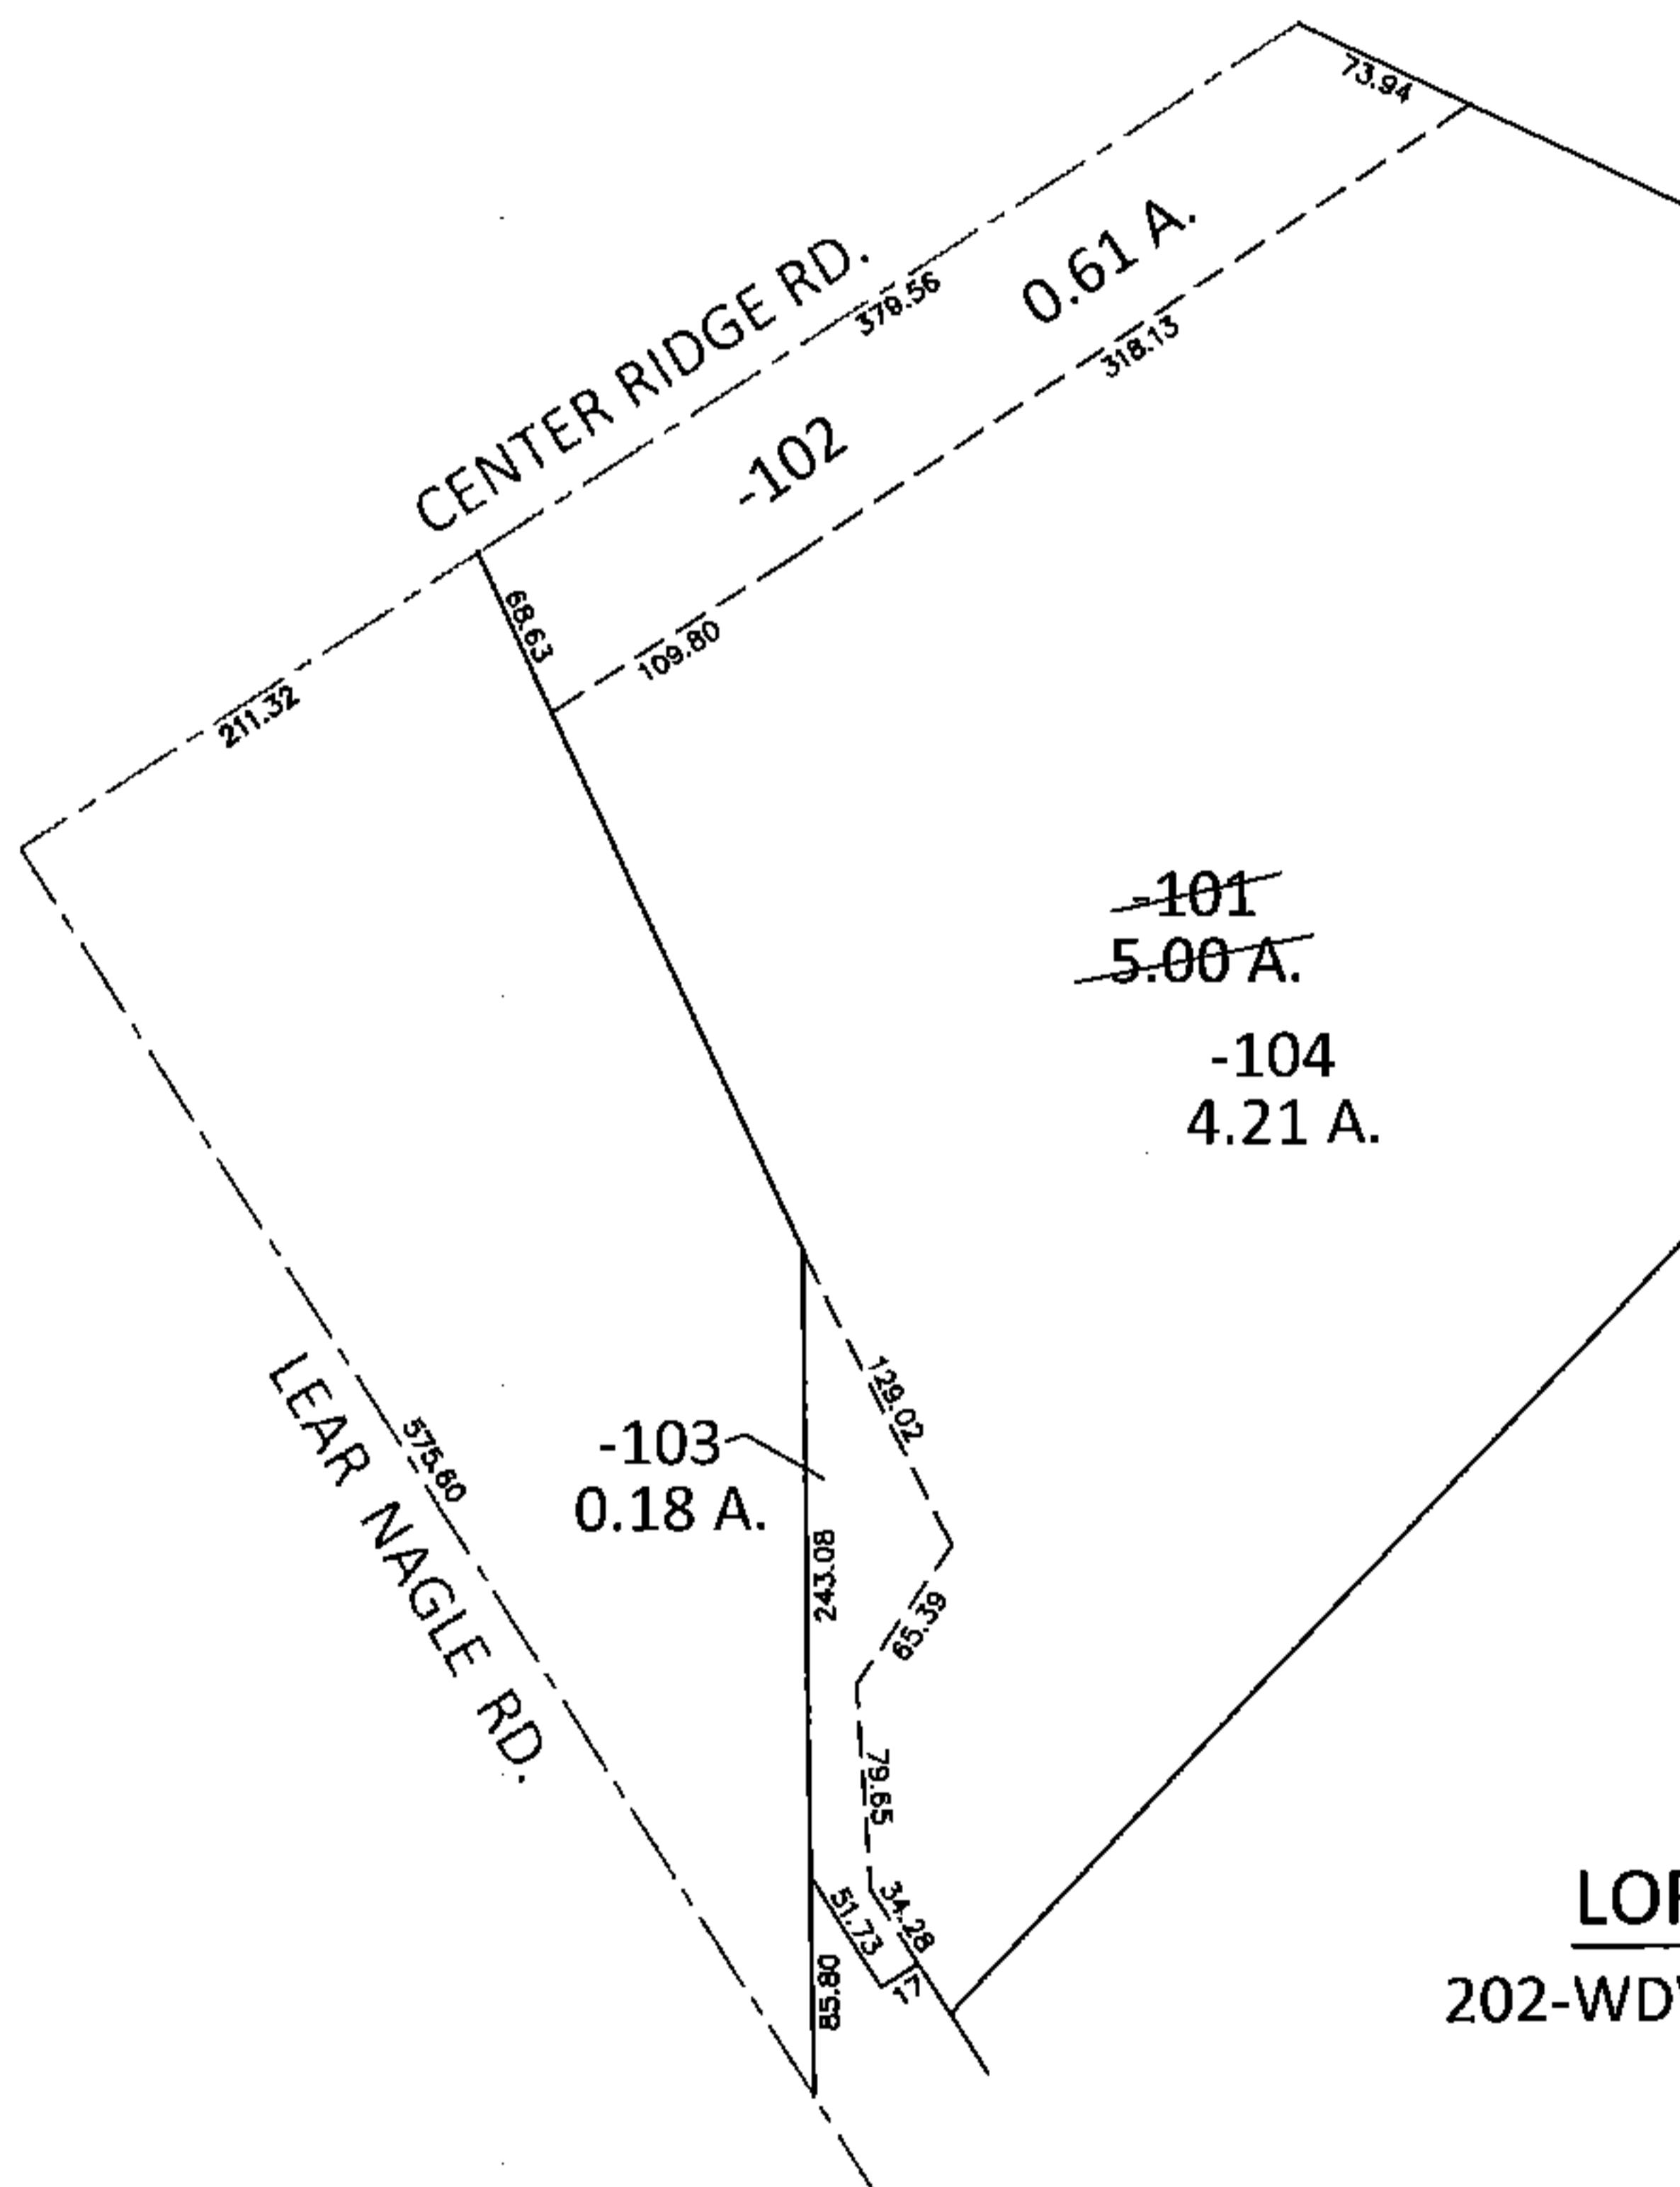


PARENT PARCEL: 07-00-008-115-101


CHILD PARCEL: 07-00-008-115-102 THRU -104

STARTING POINT: INTERSECTION OF C/L OF CENTER RIDGE RD. AND C/L OF LEAR NAGLE RD.

14-00641

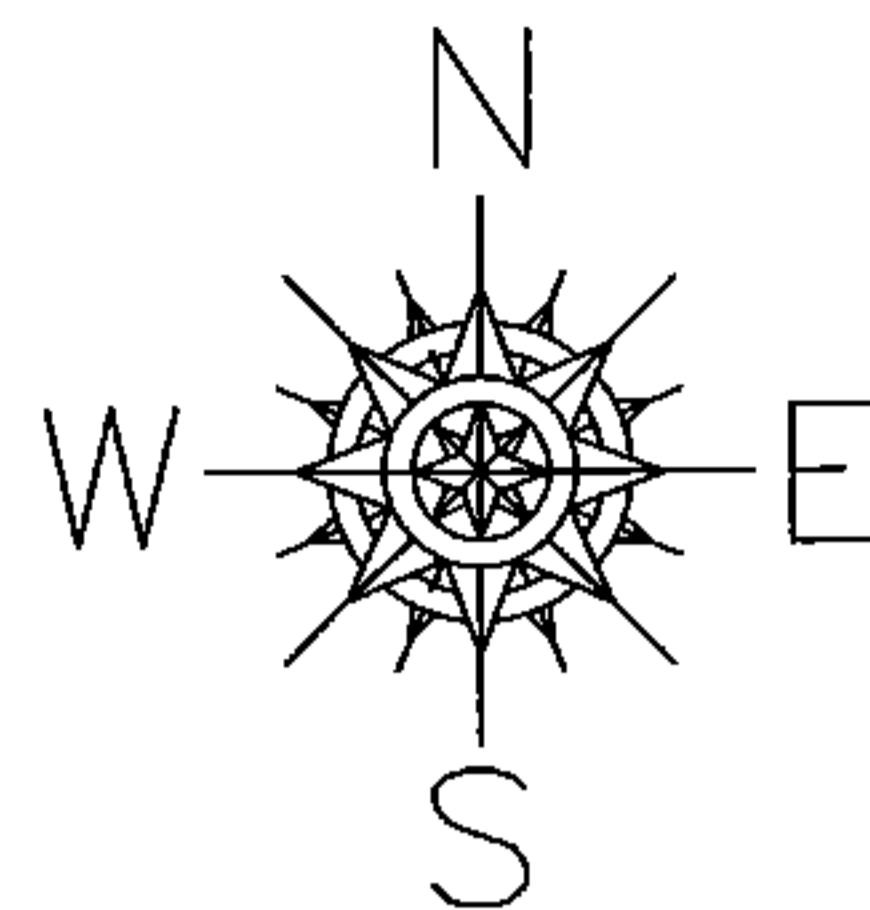

LOR-20-22.13
202-WDV-1 & 202-WDV-2

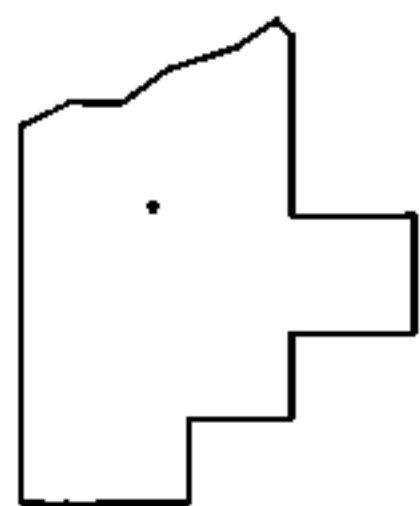

SPLITS/DEEDS PROCESSED

LORAIN COUNTY TAX MAP DEPARTMENT
226 MIDDLE AVE. ELYRIA, OHIO

SURVEYED BY: WILLIAM D. THOMAS

CLOSURE: .01:10,000

MAP PAGE(S): 7-00-008-C

APPROVED BY: RRM DATE: 3-16-15

SCALE: 1"= 150 PRIOR INST.: DV 1292/48