
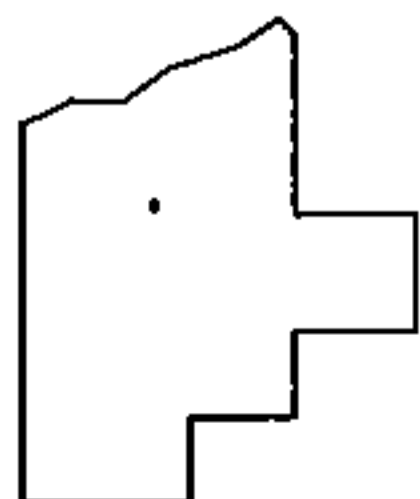
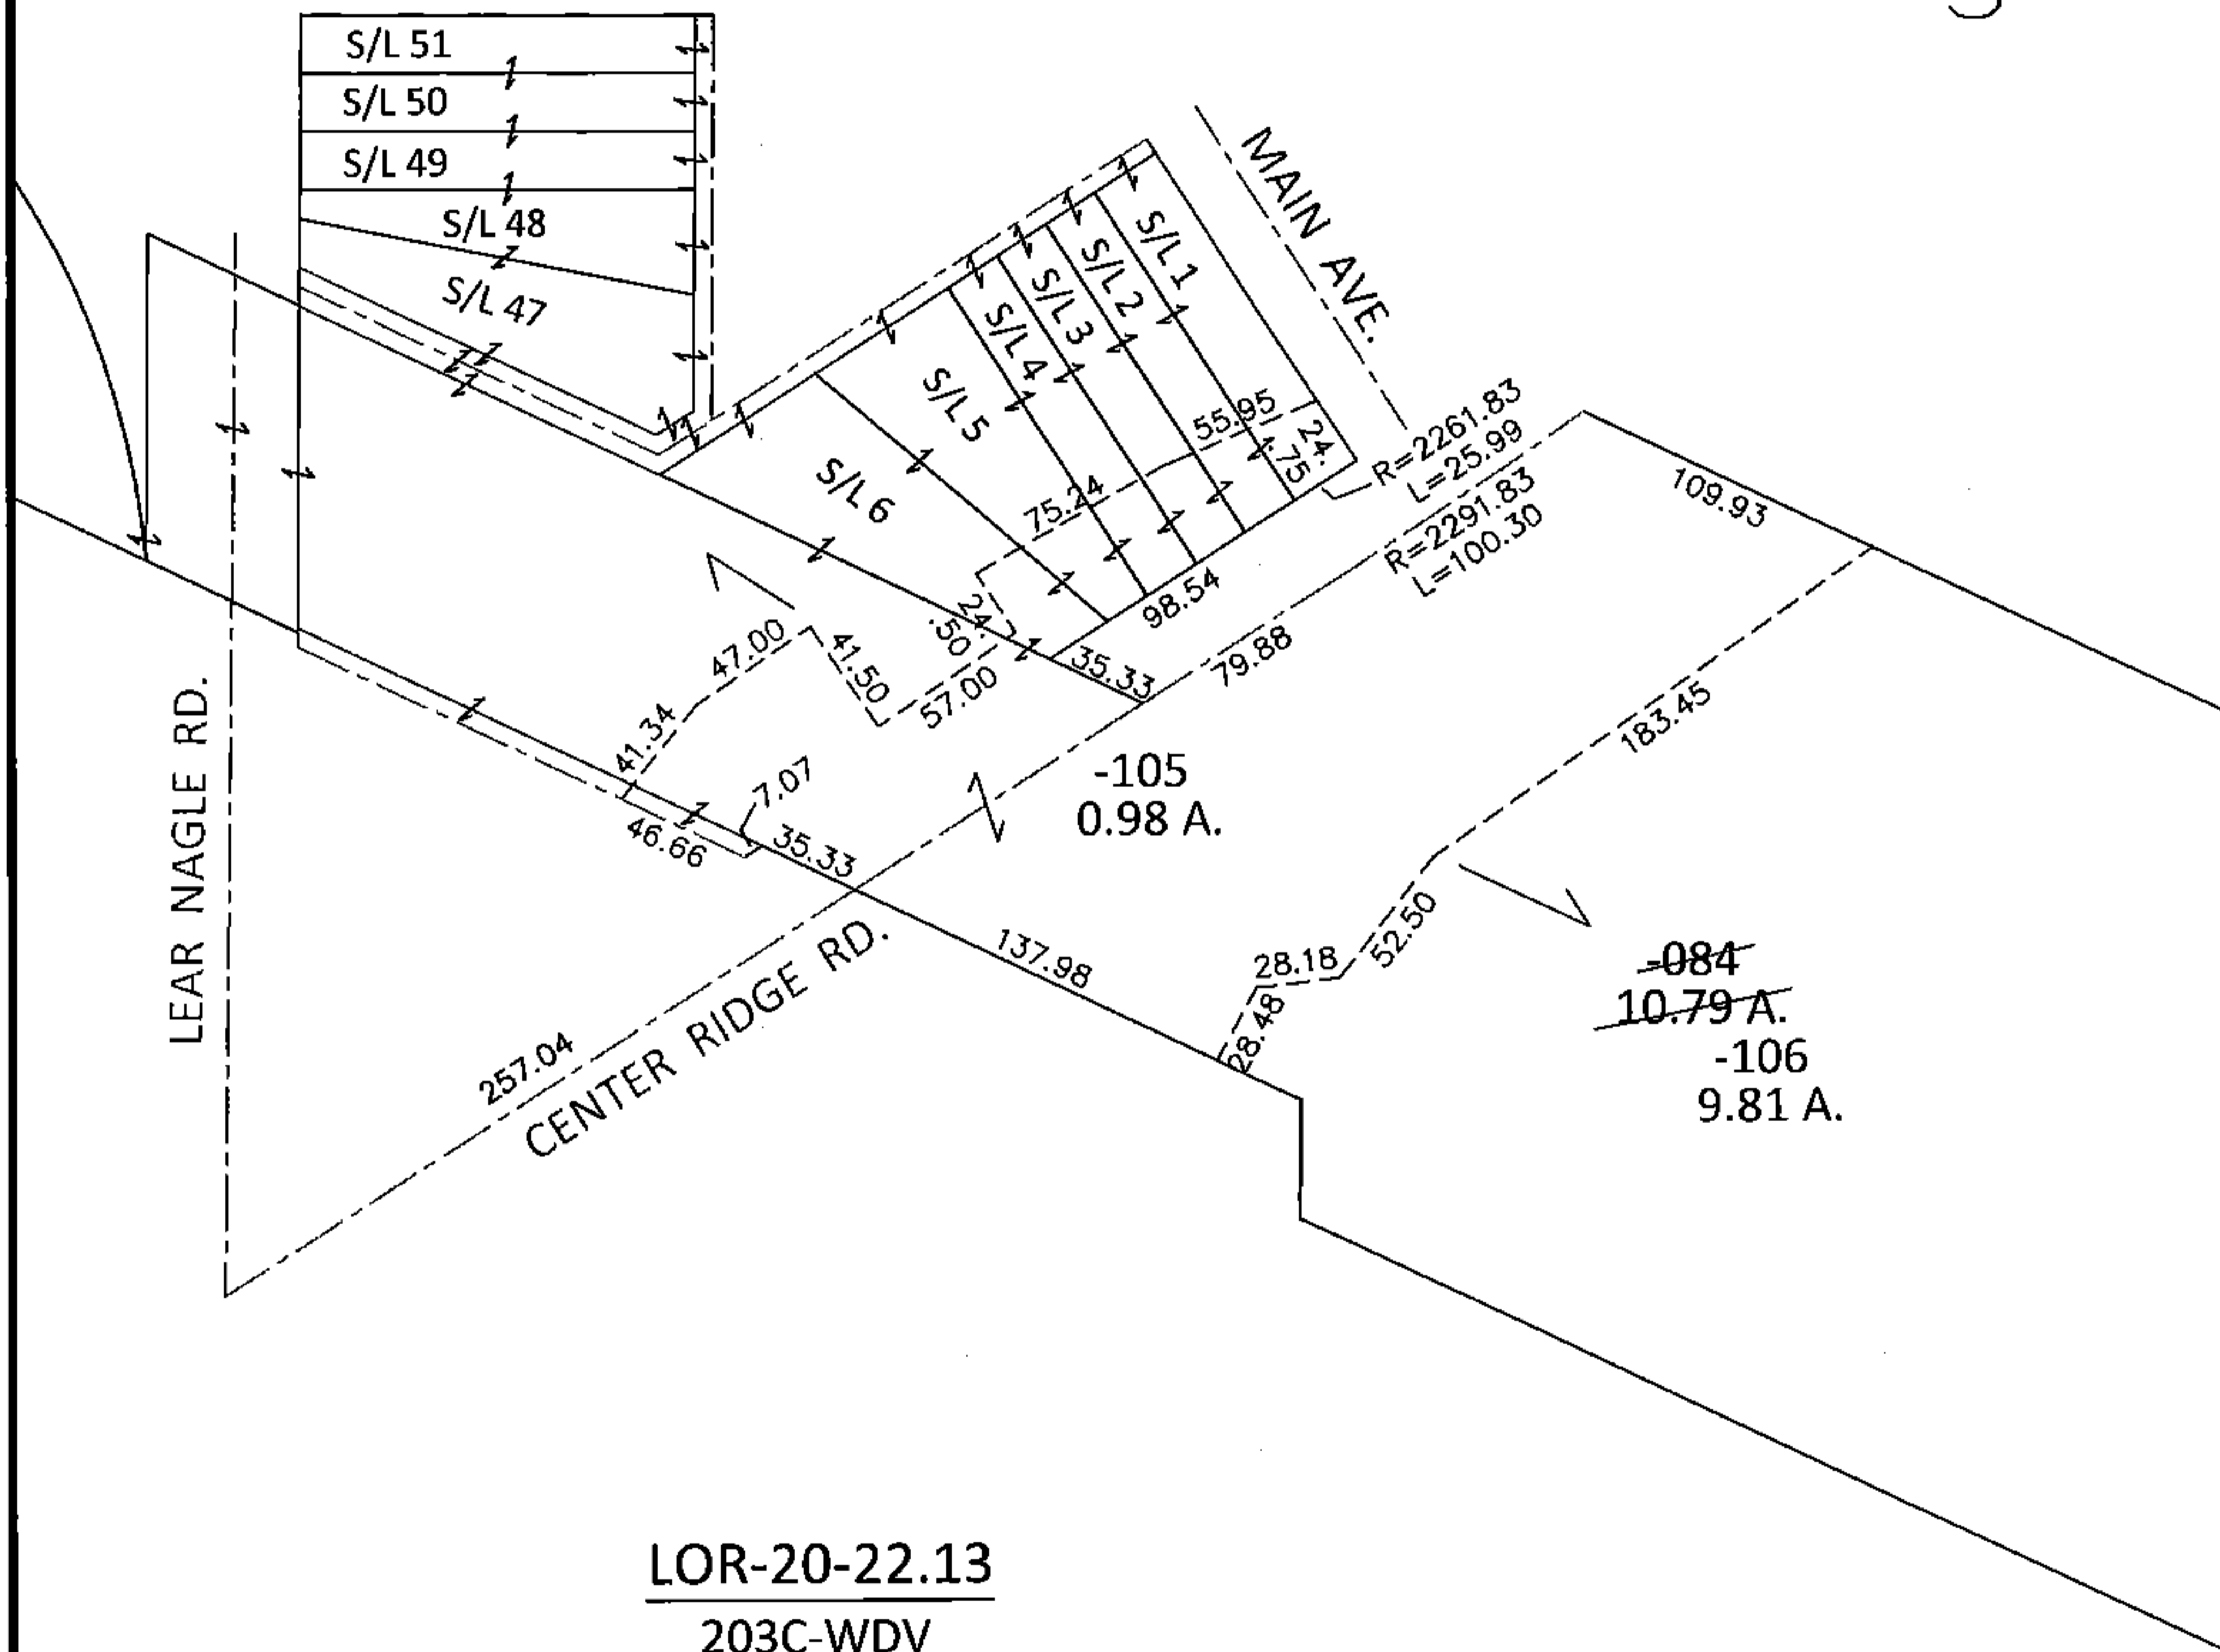


PARENT PARCEL: 07-00-008-115-084

CHILD PARCEL: 07-00-008-115-105, -106

STARTING POINT: INTERSECTION OF C/L OF LEAR NAGLE RD. AND C/L OF CENTER RIDGE RD.

14-00642

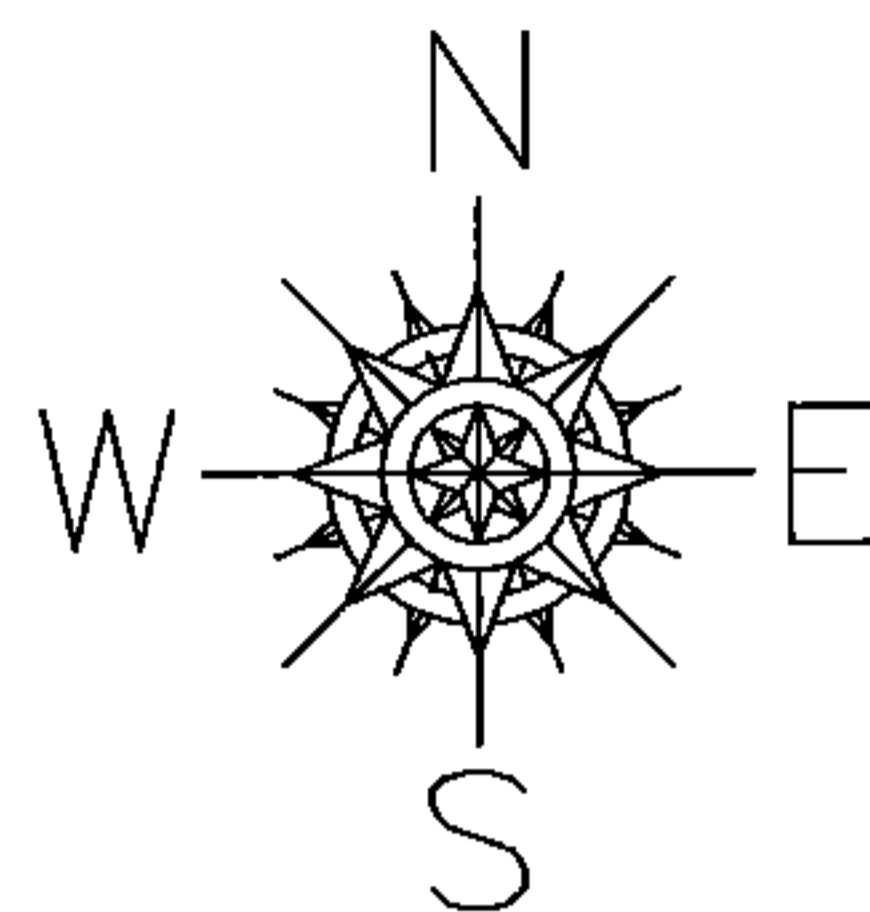

**SPLITS/DEEDS PROCESSED**

LORAIN COUNTY TAX MAP DEPARTMENT  
226 MIDDLE AVE. ELYRIA, OHIO

SURVEYED BY: WILLIAM D. THOMAS  
 CLOSURE: .01:10,000  
 MAP PAGE(S): 7-00-008-C  
 APPROVED BY: RRM DATE: 3-16-15  
 SCALE: 1"= 100 PRIOR INST.: DV 246/82