
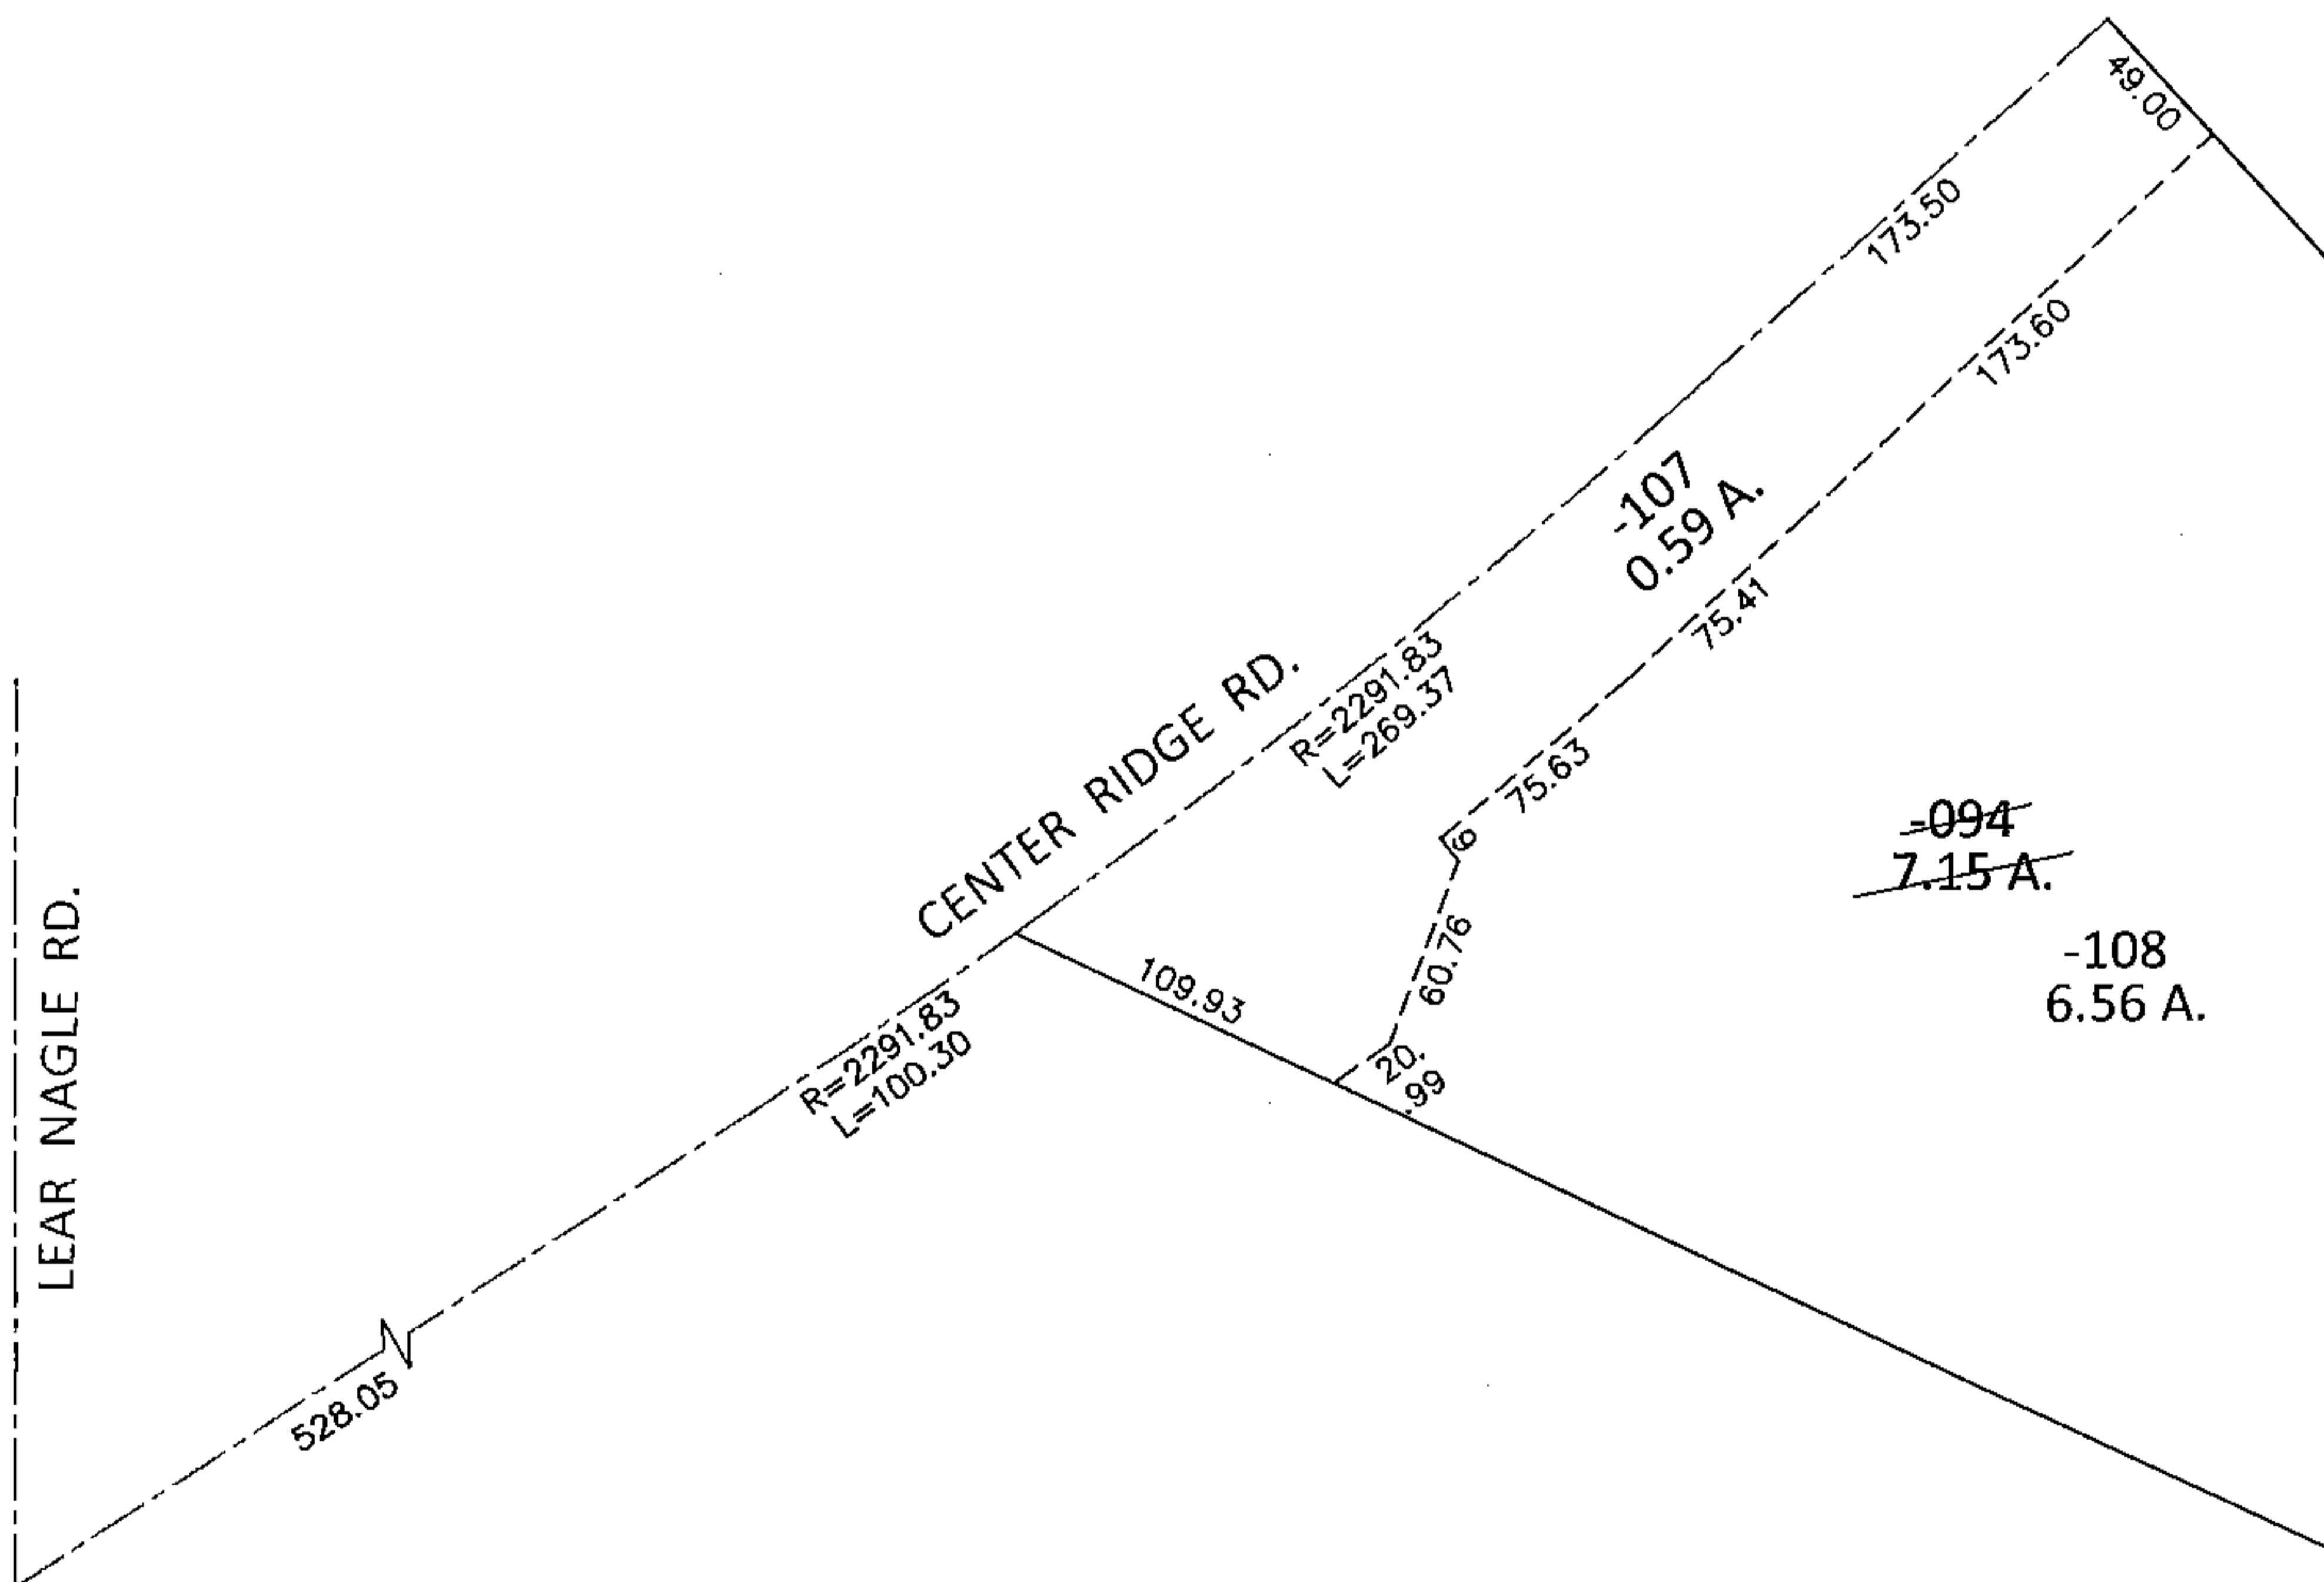


PARENT PARCEL: 07-00-008-115-094


CHILD PARCEL: 07-00-008-115-107, -108

STARTING POINT: INTERSECTION OF C/L OF LEAR NAGLE RD. AND C/L OF CENTER RIDGE RD.

14-00643

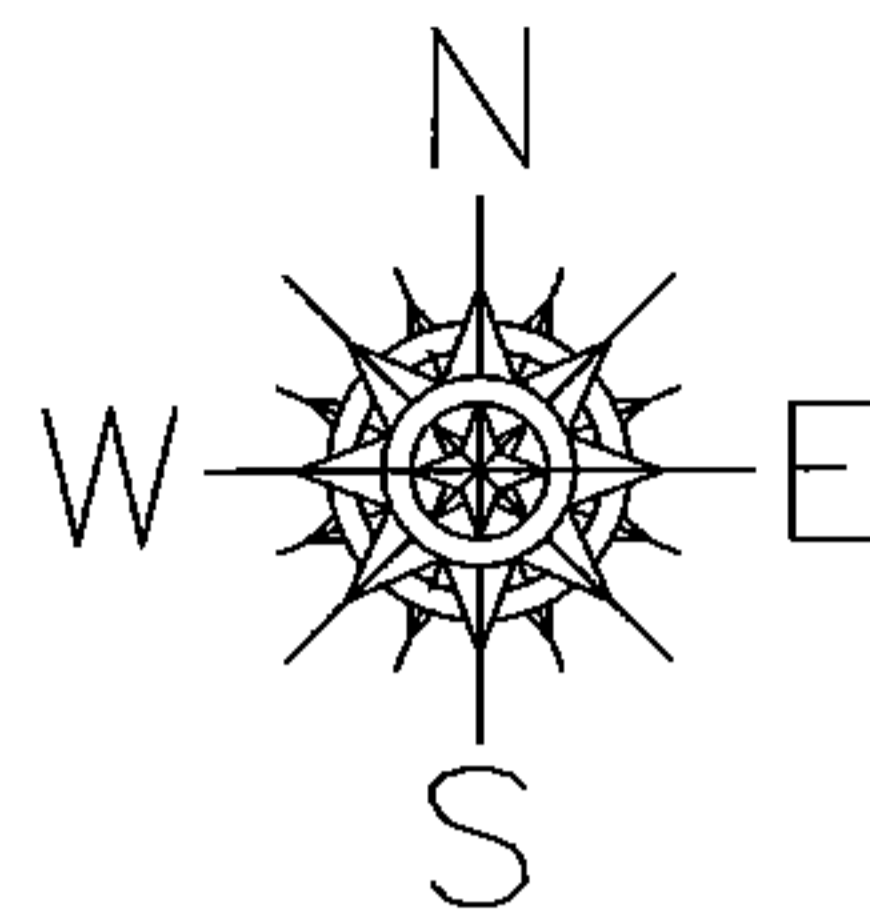

LOR-20-22.13  
204-WDV

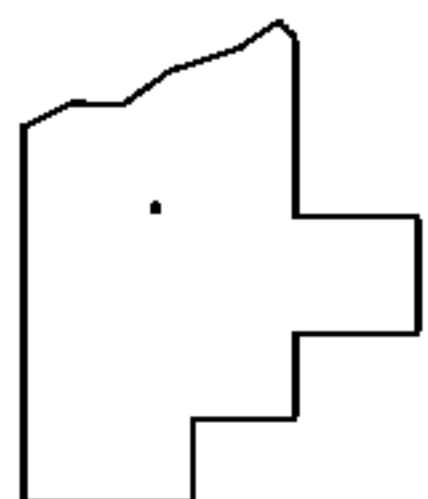

SPLITS/DEEDS PROCESSED

LORAIN COUNTY TAX MAP DEPARTMENT  
226 MIDDLE AVE. ELYRIA, OHIO

SURVEYED BY: WILLIAM D. THOMAS

CLOSURE: .01:10,000

MAP PAGE(S): 7-00-008-D

APPROVED BY: RRM DATE: 3-16-15

SCALE: 1"= 100 PRIOR INST.: 20090279656