


PARENT PARCEL: 07-00-021-117-004


CHILD PARCEL: 07-00-021-117-091, -092

STARTING POINT: INTERSECTION OF C/L OF CENTER RIDGE RD. AND C/L OF AVON BELDEN RD.


14-00652

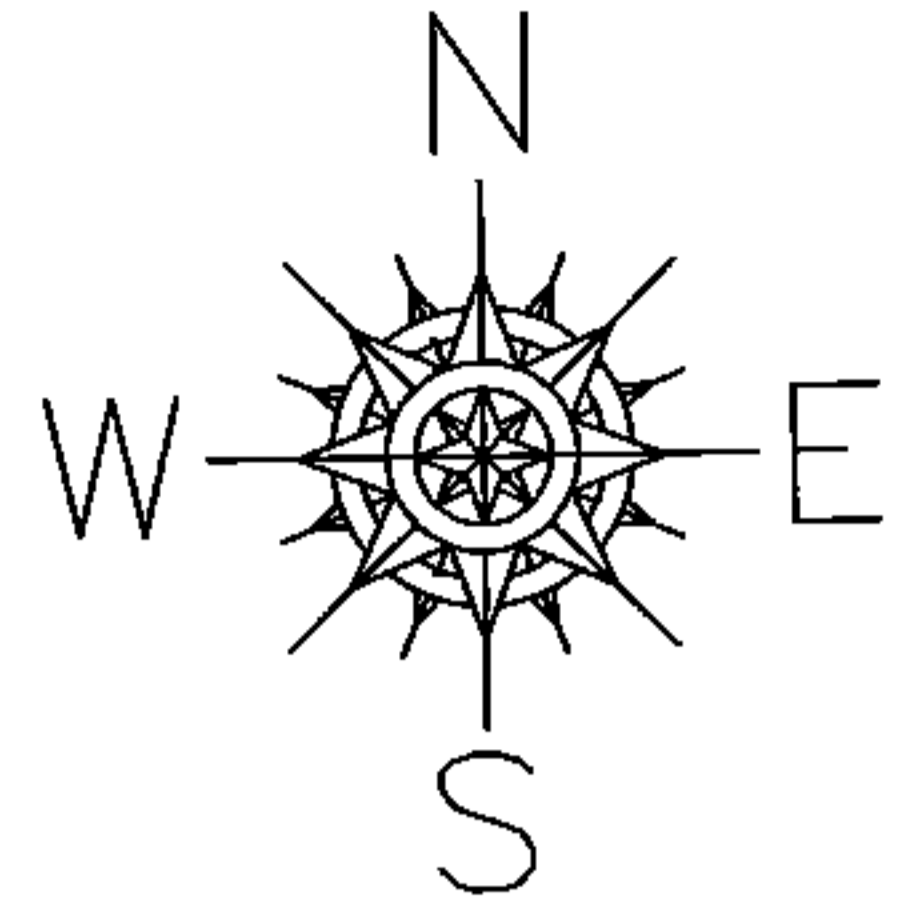

CENTER RIDGE RD.

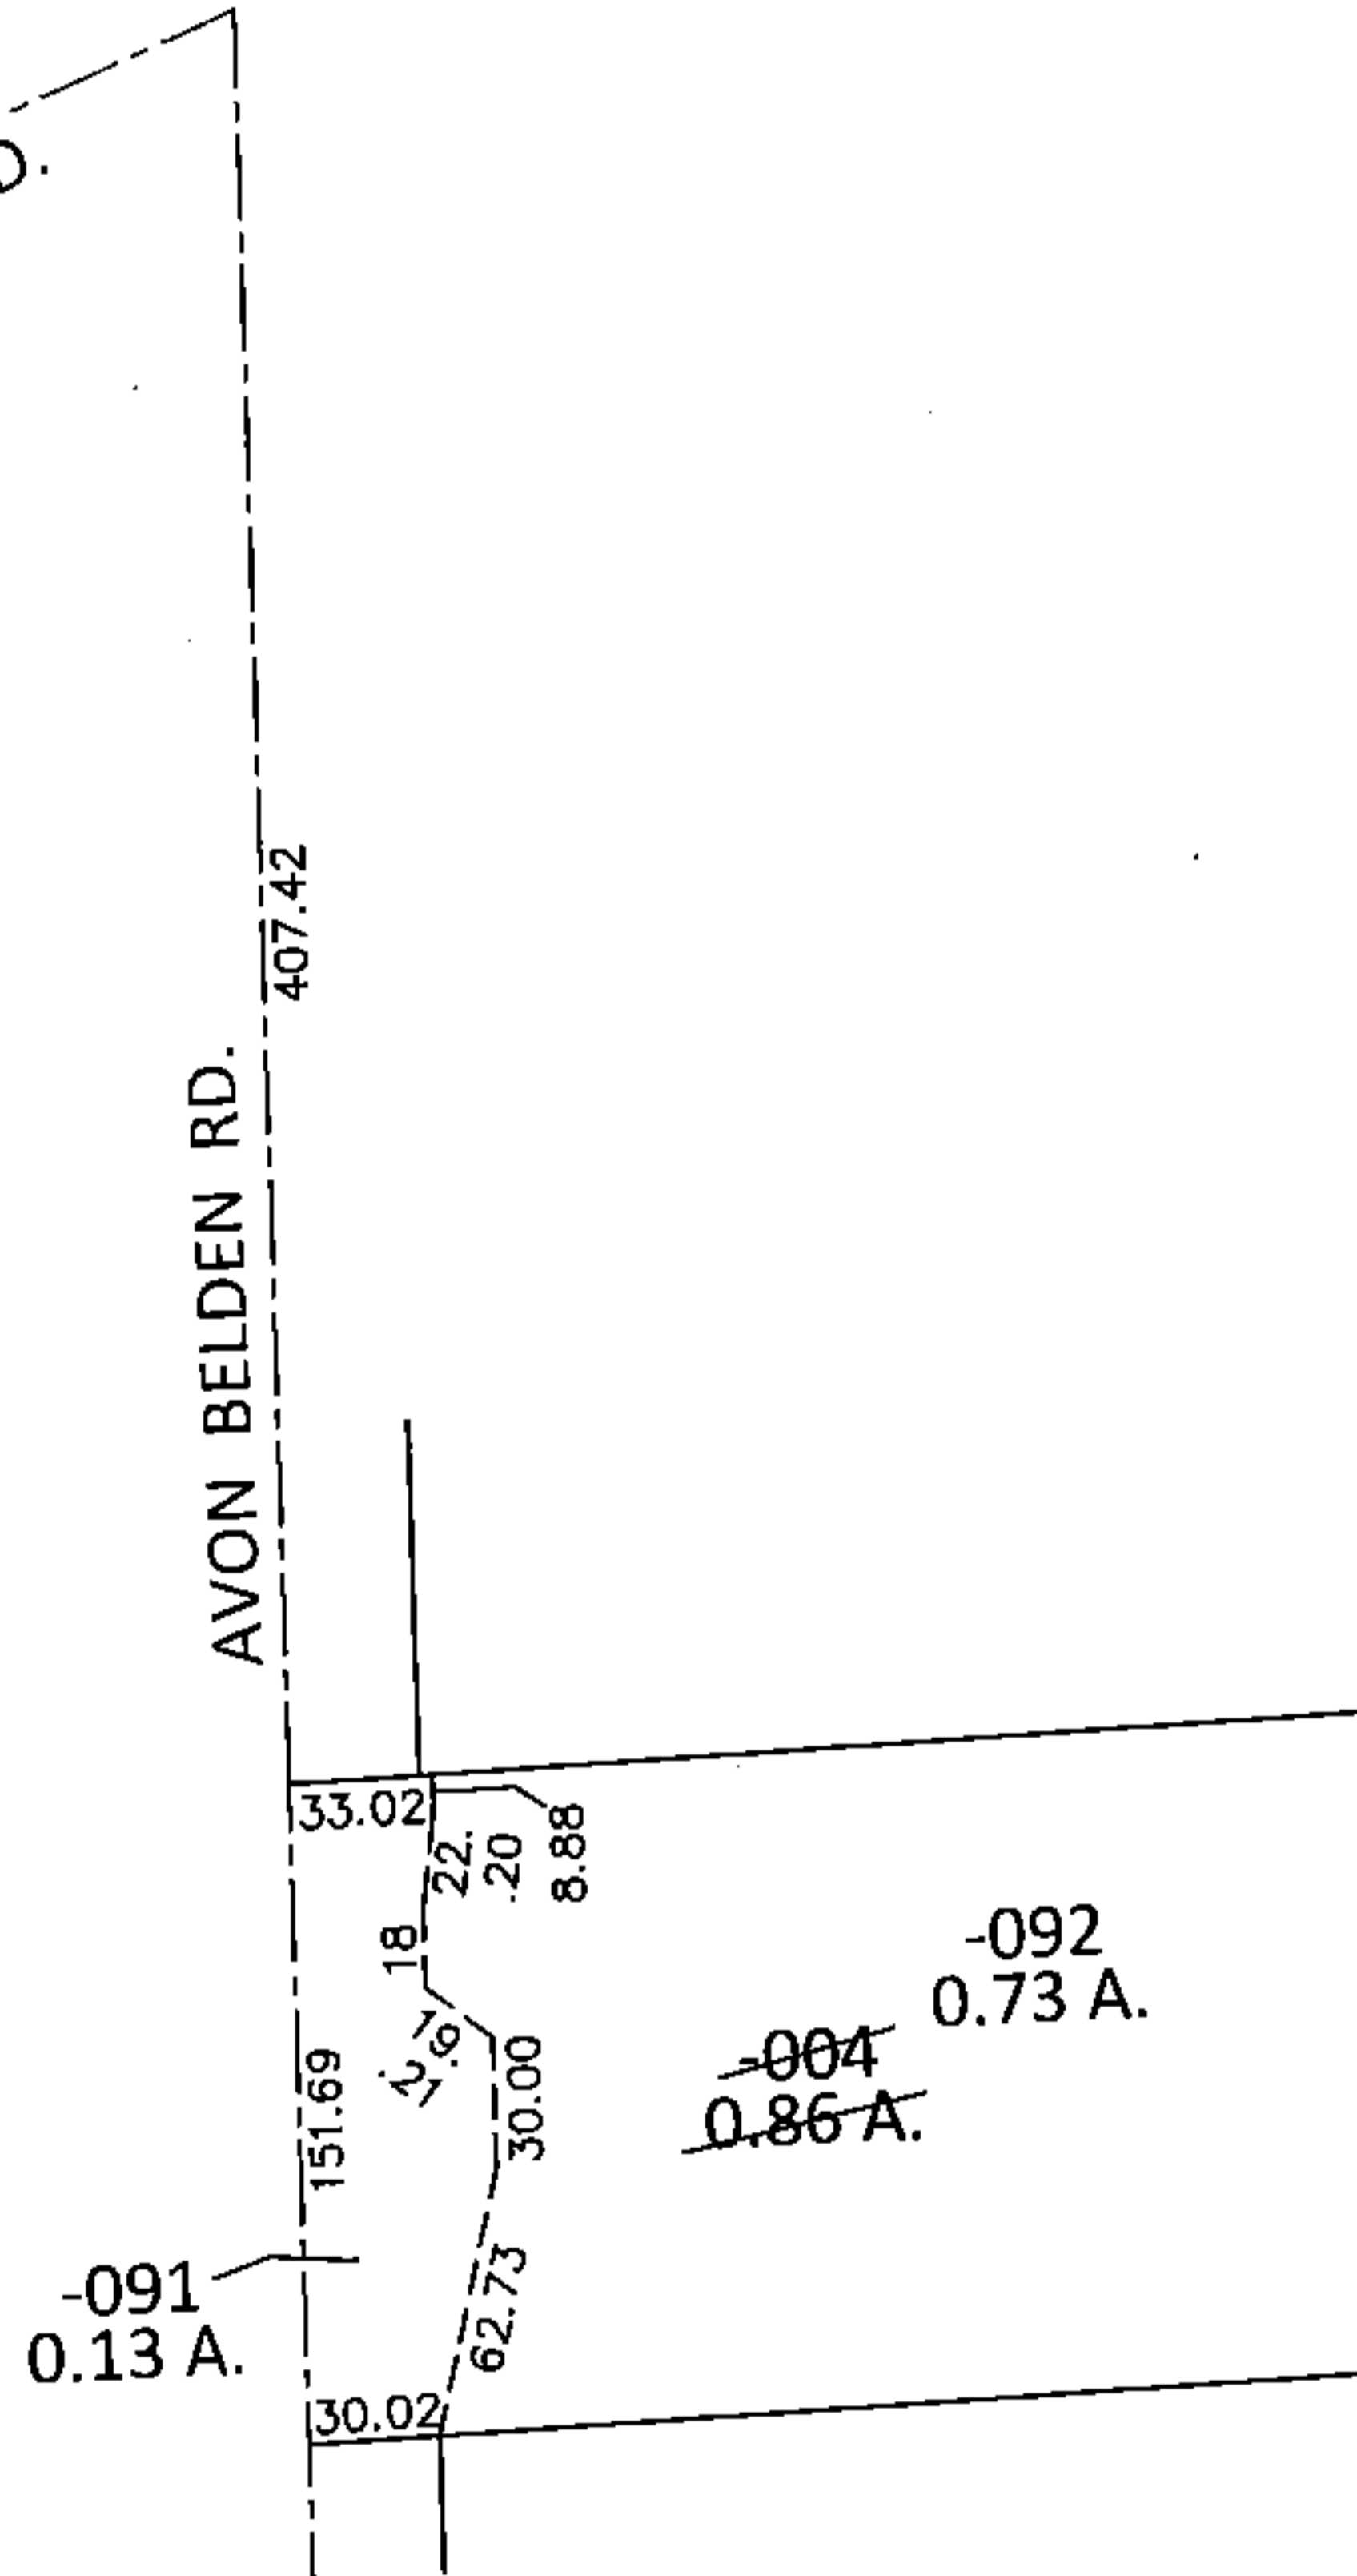

LOR-20-22.13
243-WDV

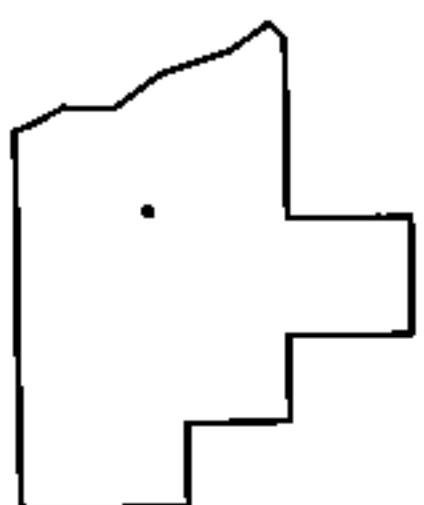

SPLITS/DEEDS PROCESSED

LORAIN COUNTY TAX MAP DEPARTMENT
226 MIDDLE AVE. ELYRIA, OHIO

SURVEYED BY:	WILLIAM D. THOMAS
CLOSURE:	.01:10,000
MAP PAGE(S):	7-00-021-C
APPROVED BY:	RRM DATE: 3-18-15
SCALE:	1"= 100 PRIOR INST.: DV 524/70