
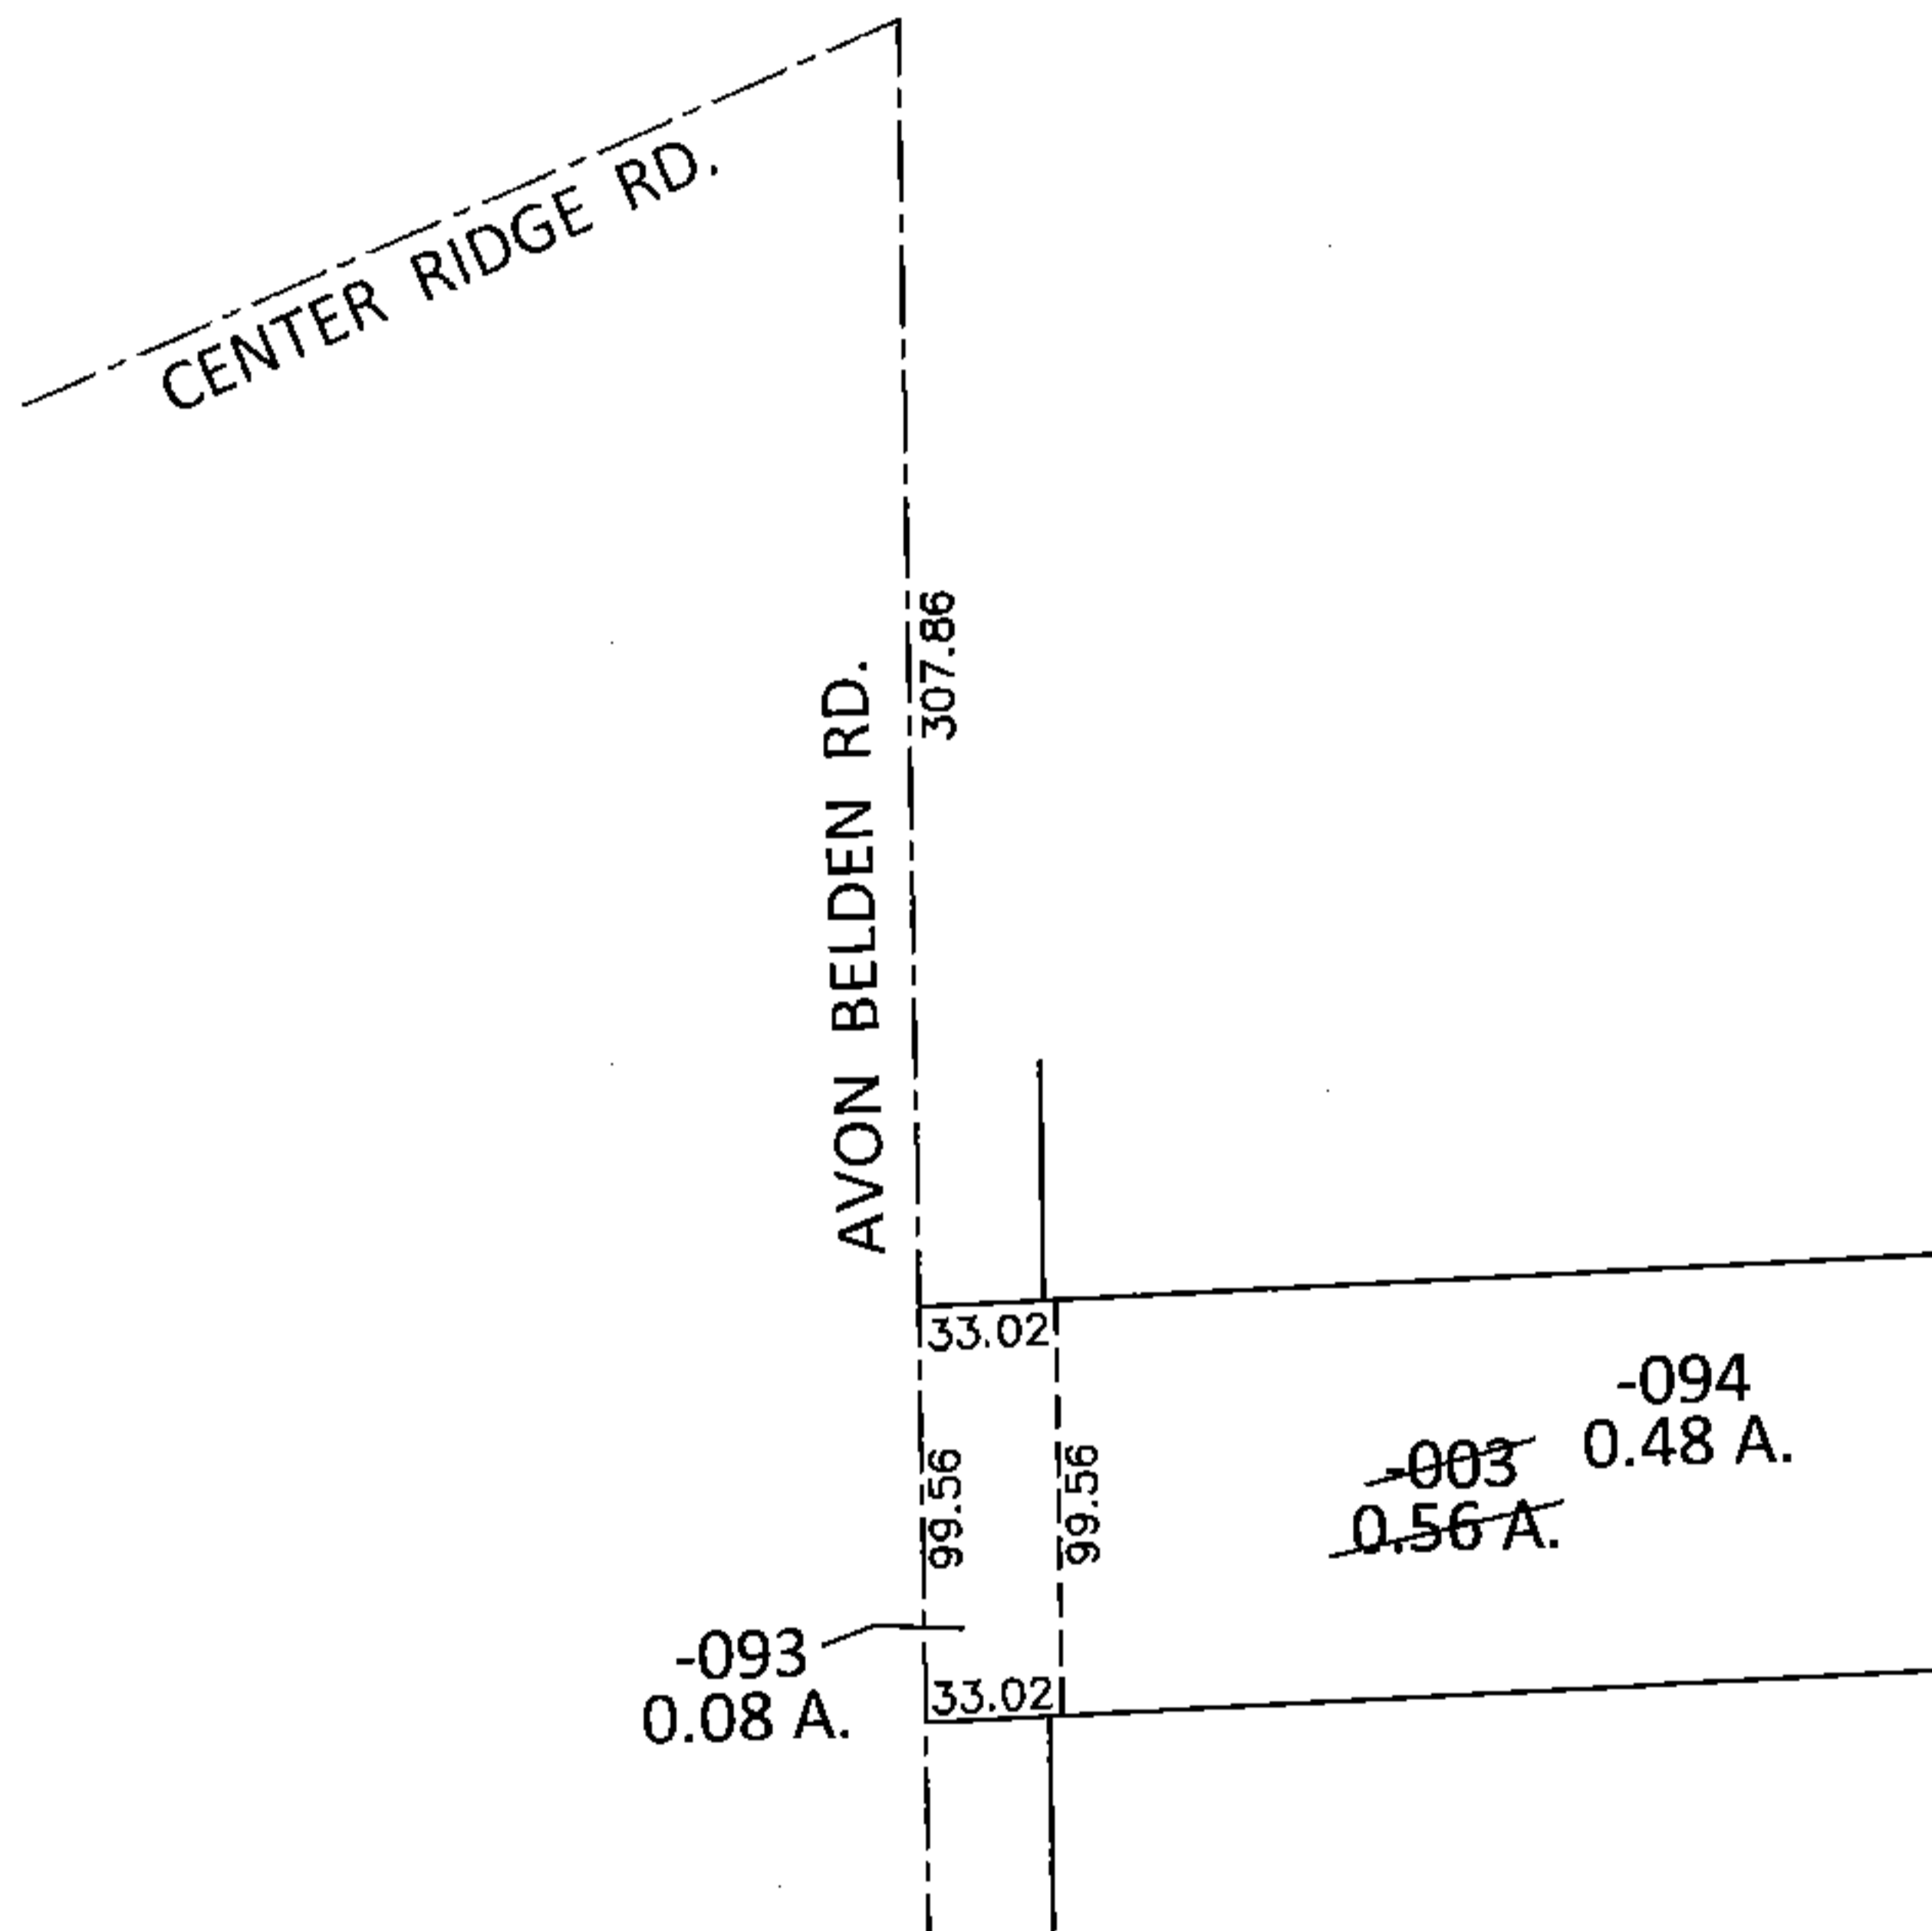


PARENT PARCEL: 07-00-021-117-003

CHILD PARCEL: 07-00-021-117-093, -094


STARTING POINT: INTERSECTION OF C/L OF CENTER RIDGE RD. AND C/L OF AVON BELDEN RD.

14-00653

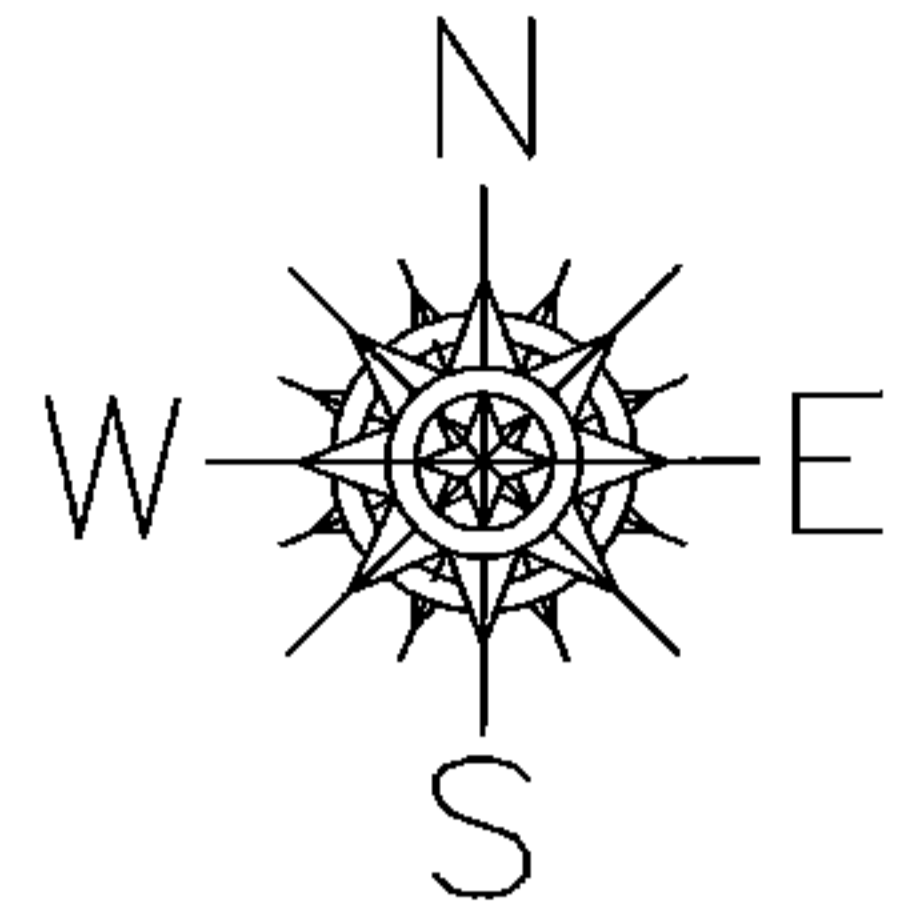

LOR-20-22.13

244-WDV

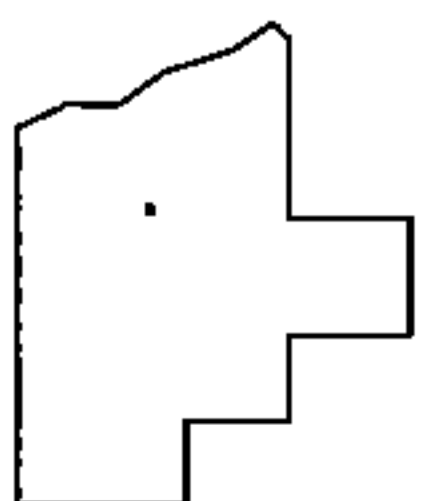

SPLITS/DEEDS PROCESSED

LORAIN COUNTY TAX MAP DEPARTMENT
226 MIDDLE AVE. ELYRIA, OHIO

SURVEYED BY: WILLIAM D. THOMAS

CLOSURE: .01:10,000

MAP PAGE(S): 7-00-021-C

APPROVED BY: RRM DATE: 3-18-15

SCALE: 1"= 100 PRIOR INST.: 20020860864