


PARENT PARCEL: 07-00-021-117-064

CHILD PARCEL: 07-00-021-117-097, -098

STARTING POINT: INTERSECTION OF C/L OF CENTER RIDGE RD. AND C/L OF AVON BELDEN RD.

14-00656

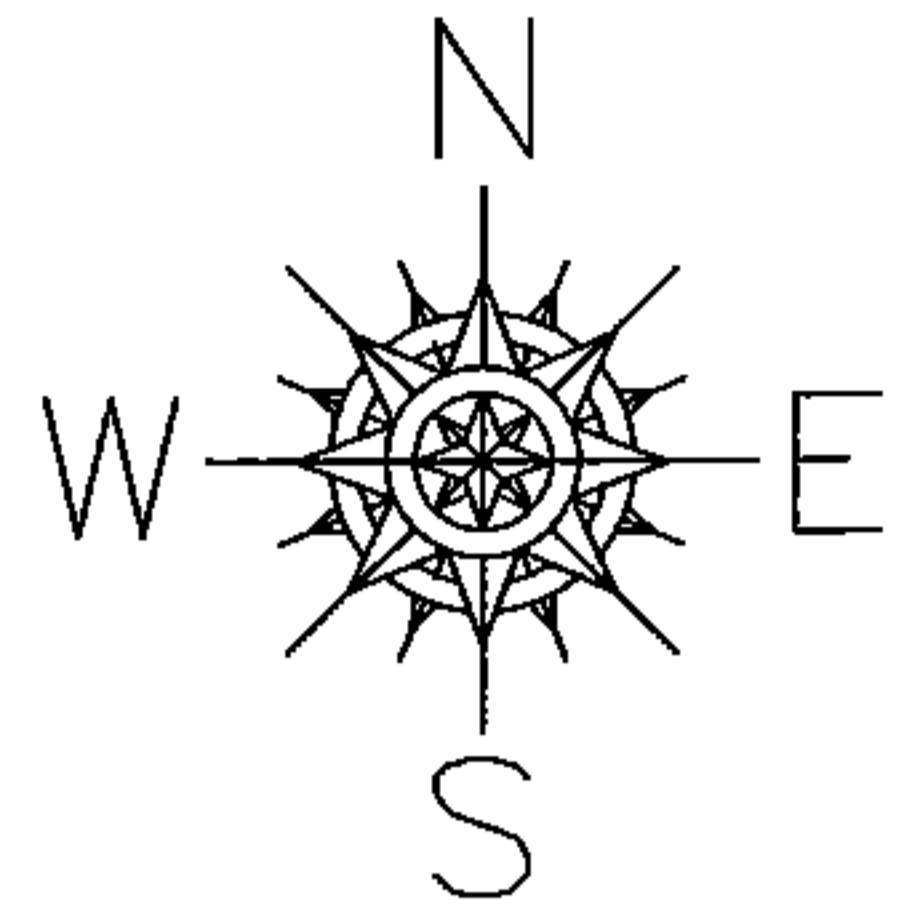

CENTER RIDGE RD.

AVON BELDEN RD.

204.58

LOR-20-22.13
252-WDV

33.01


91.28

~~-097~~
0.07 A.

91.16

33.02

~~-064~~ ~~0.49 A.~~
-098
0.42 A.

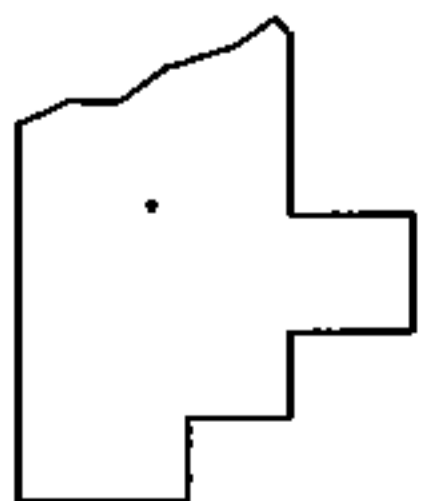

SPLITS/DEEDS PROCESSED

LORAIN COUNTY TAX MAP DEPARTMENT
226 MIDDLE AVE. ELYRIA, OHIO

SURVEYED BY: WILLIAM D. THOMAS

CLOSURE: .00:10,000

MAP PAGE(S): 7-00-021-C

APPROVED BY: RRM DATE: 3-19-15

SCALE: 1"= 50' PRIOR INST.: 20010738606