


PARENT PARCEL: 07-00-021-118-005

CHILD PARCEL: 07-00-021-118-046, -047



STARTING POINT: INTERSECTION OF C/L OF CENTER RIDGE RD. AND C/L OF ROOT RD.

14-00658

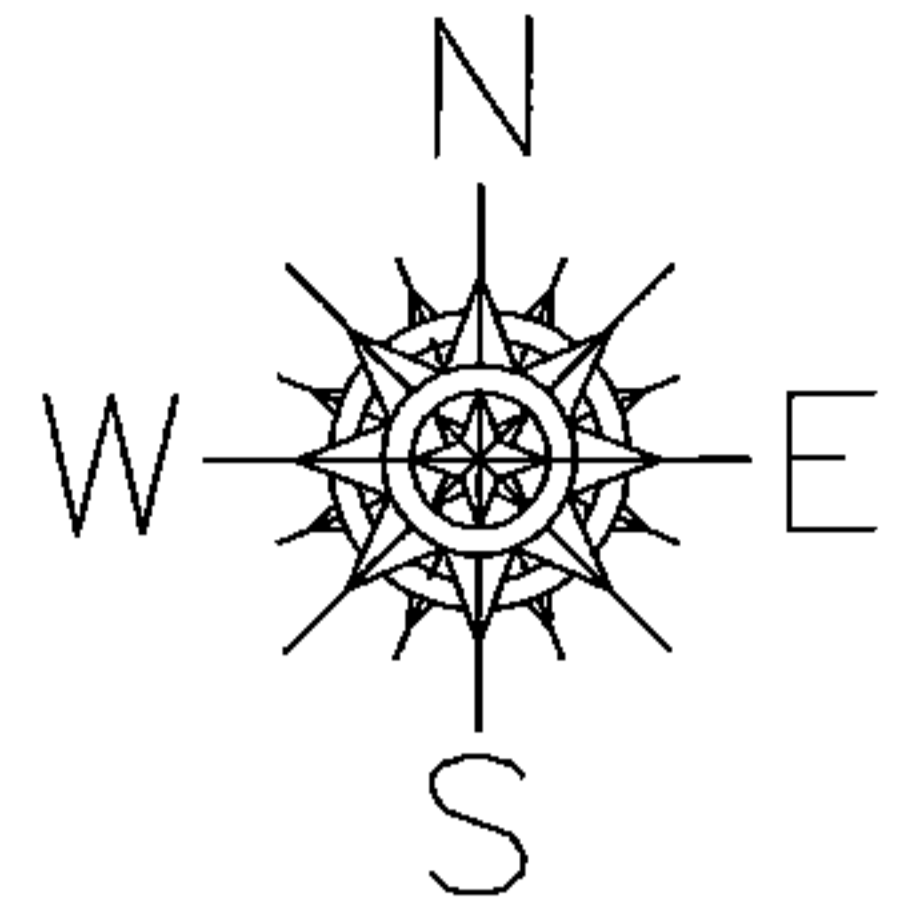

CENTER RIDGE RD.

LOR-20-22.13
263-WDV

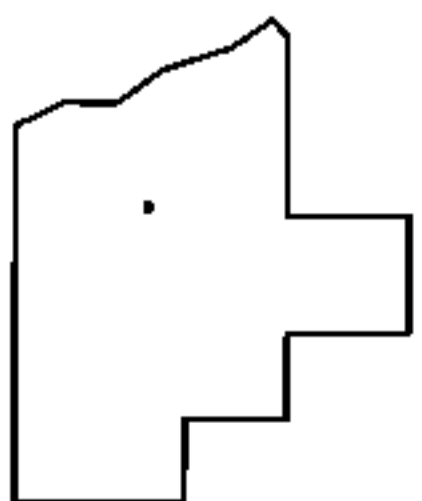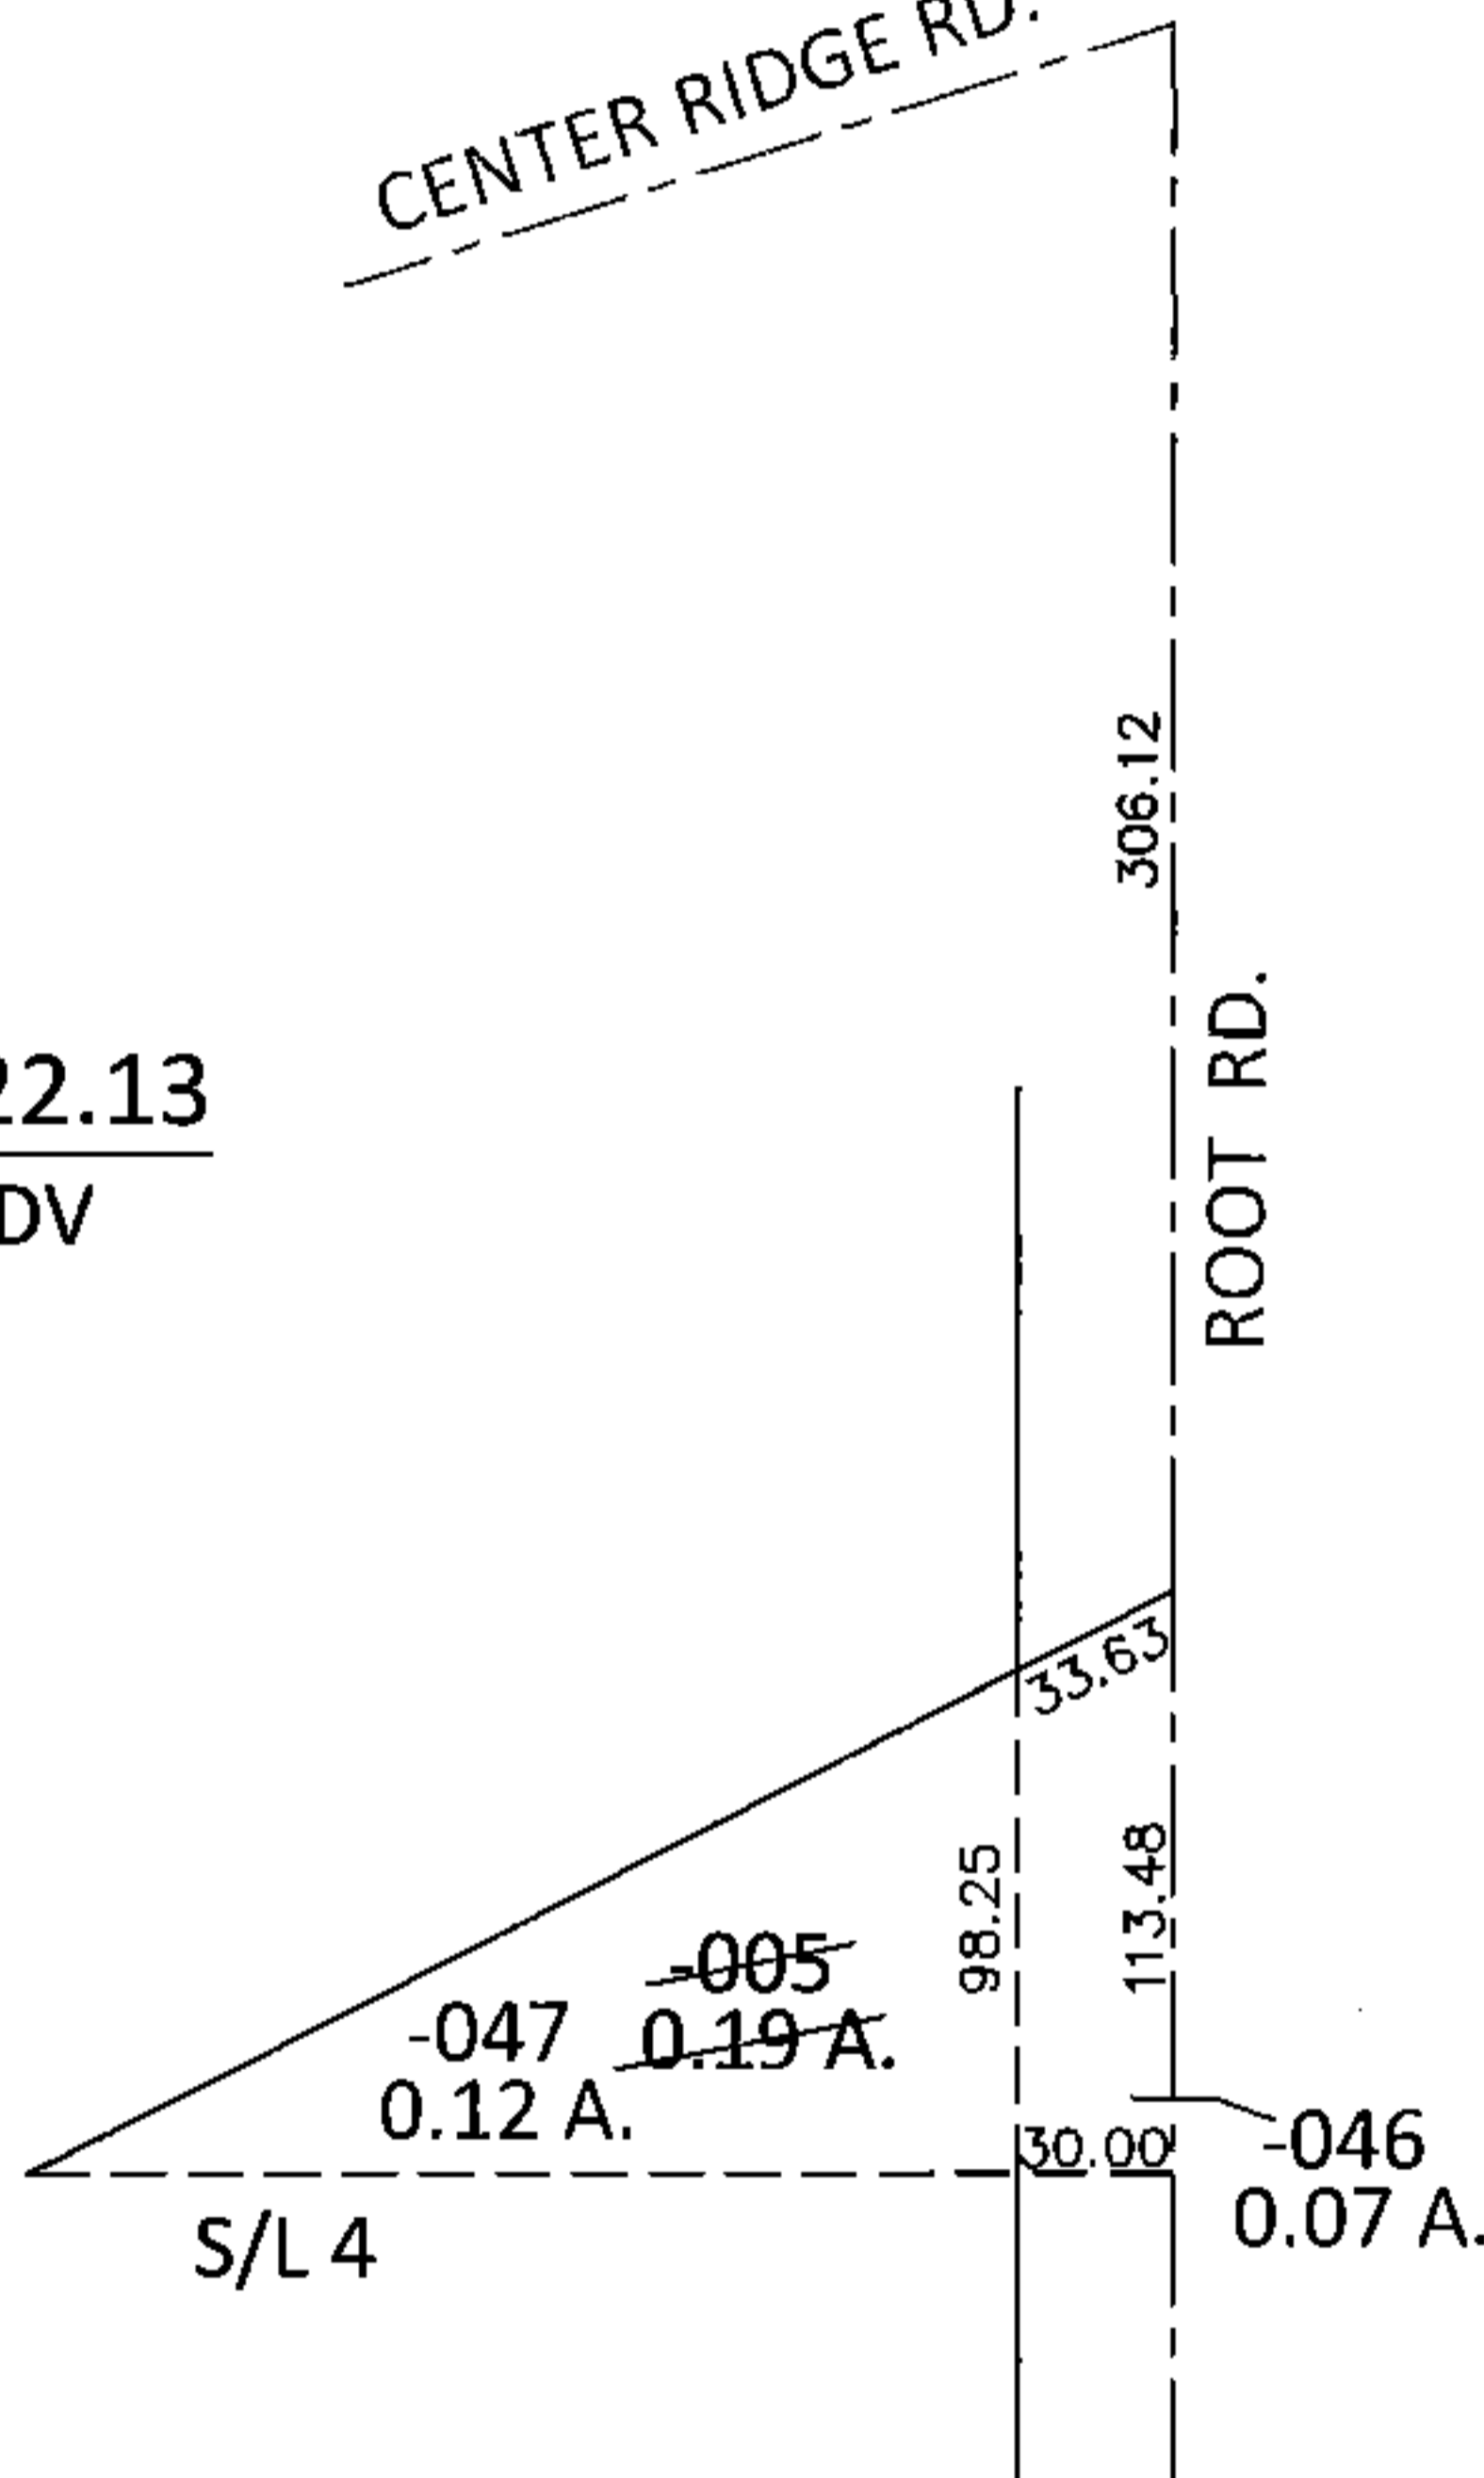

SPLITS/DEEDS PROCESSED

LORAIN COUNTY TAX MAP DEPARTMENT
226 MIDDLE AVE. ELYRIA, OHIO

SURVEYED BY: WILLIAM D. THOMAS

CLOSURE: .00:10,000

MAP PAGE(S): 7-00-021-D

APPROVED BY: RRM DATE: 10-16-14

SCALE: 1"= 100 PRIOR INST.: OR 158/536