
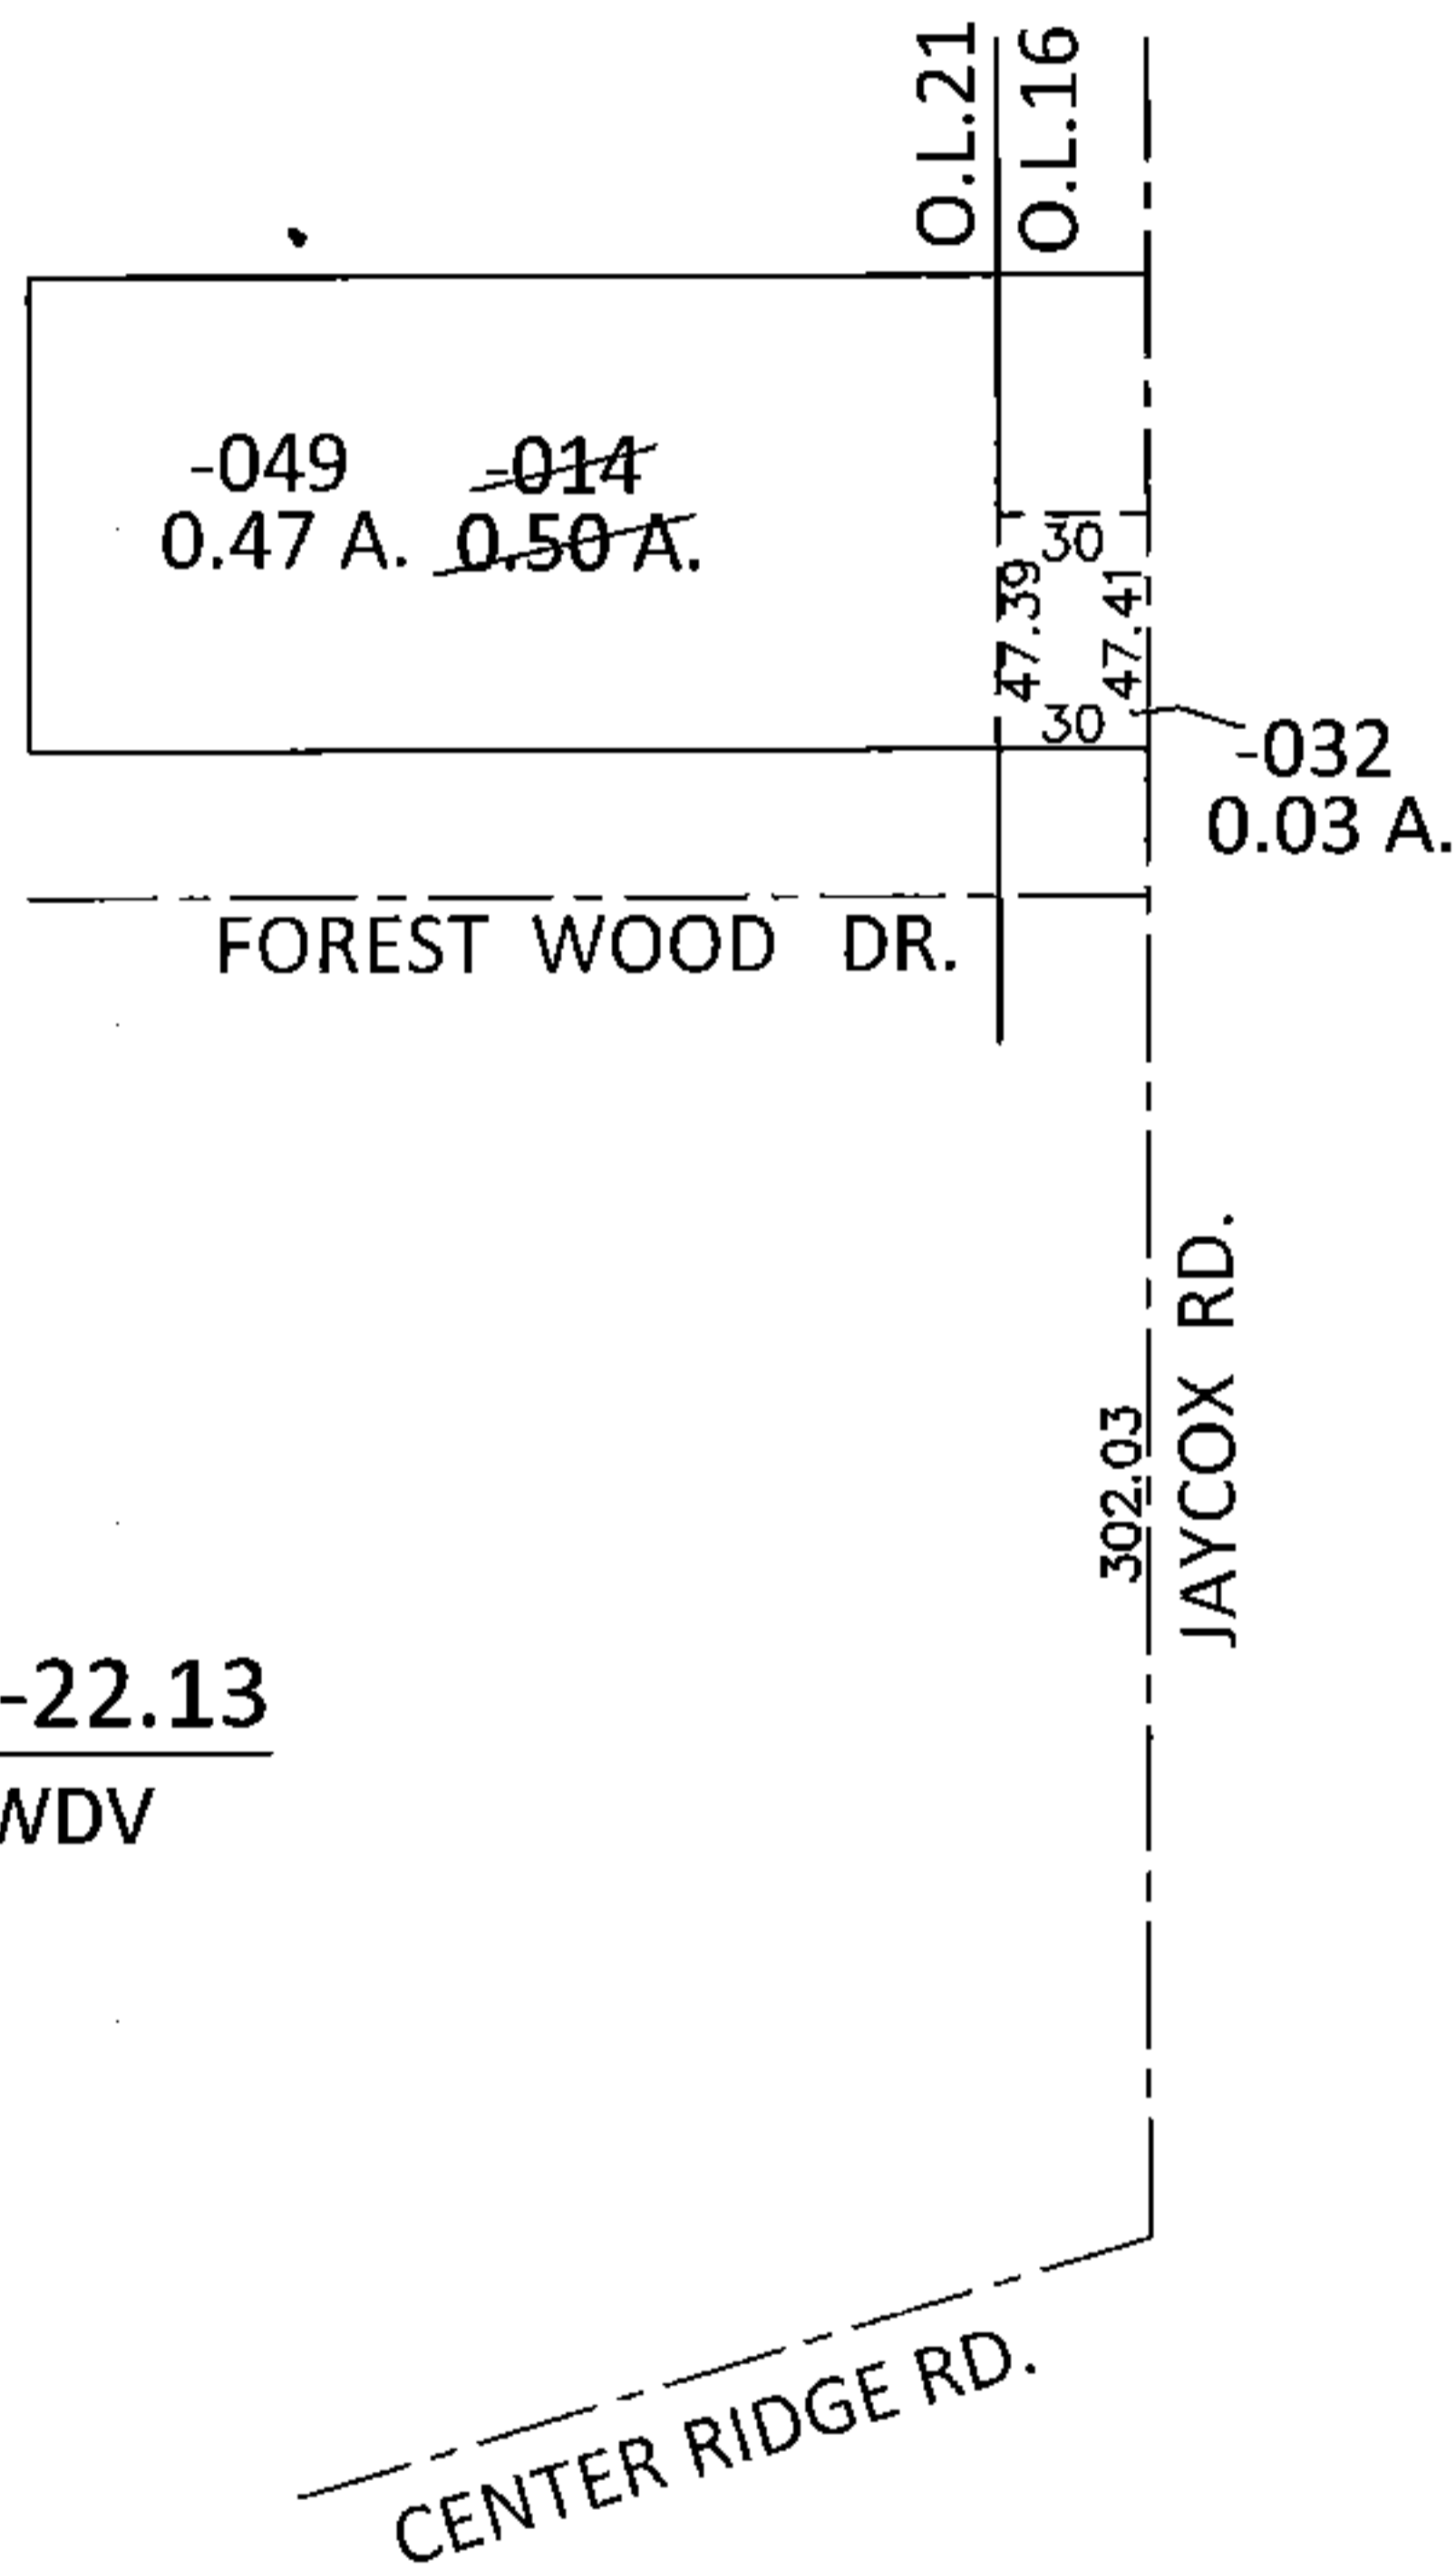


PARENT PARCEL: 07-00-021-116-014


CHILD PARCEL: 07-00-016-101-032, 07-00-021-116-049

STARTING POINT: INTERSECTION OF C/L OF CENTER RIDGE RD. AND C/L OF JAYCOX RD.

14-00662

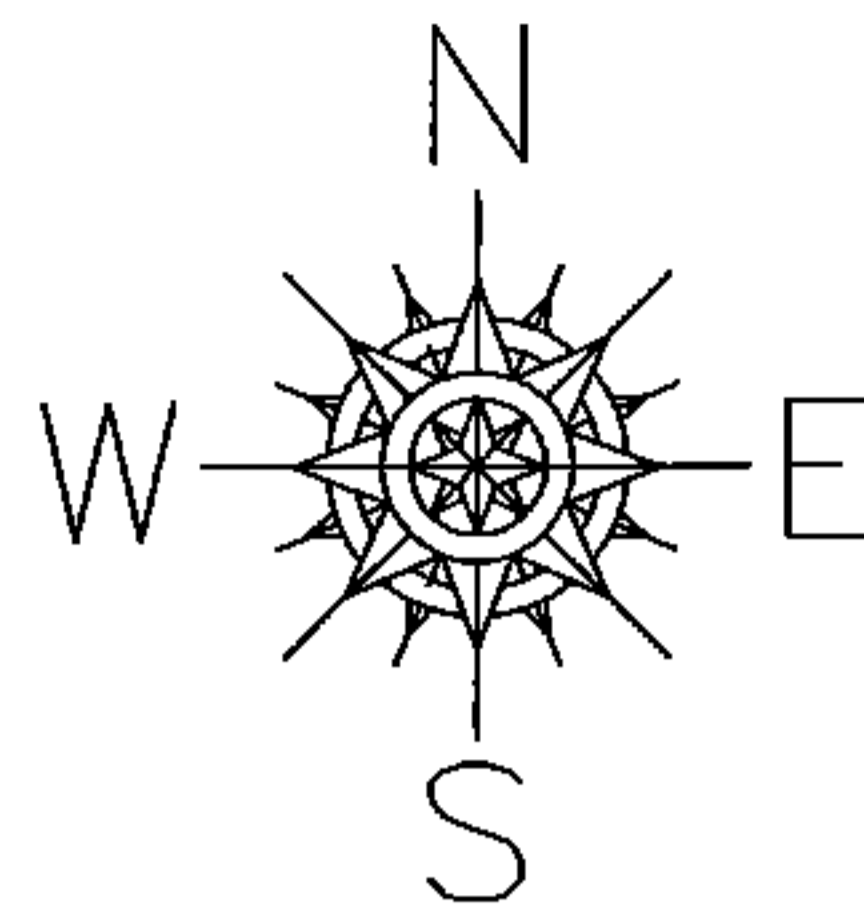

LOR-20-22.13
271-WDV

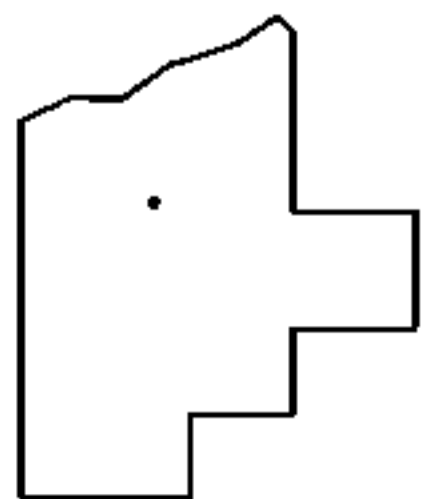

SPLITS/DEEDS PROCESSED

LORAIN COUNTY TAX MAP DEPARTMENT
226 MIDDLE AVE. ELYRIA, OHIO

SURVEYED BY: WILLIAM D. THOMAS

CLOSURE: .00:10,000

MAP PAGE(S): 7-00-021-B

APPROVED BY: RRM DATE: 10-22-14

SCALE: 1"= 100 PRIOR INST.: OR 598/563