




PARENT PARCEL: 07-00-016-101-010

CHILD PARCEL: 07-00-016-101-030, -031

STARTING POINT: INTERSECTION OF C/L OF JAYCOX RD. AND C/L OF SINTA RUN

14-00663

LOR-20-22.13
272-WDV

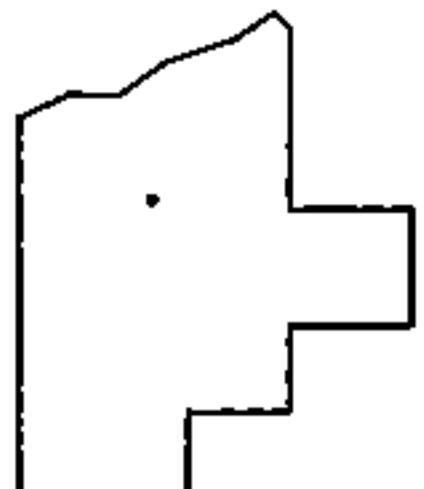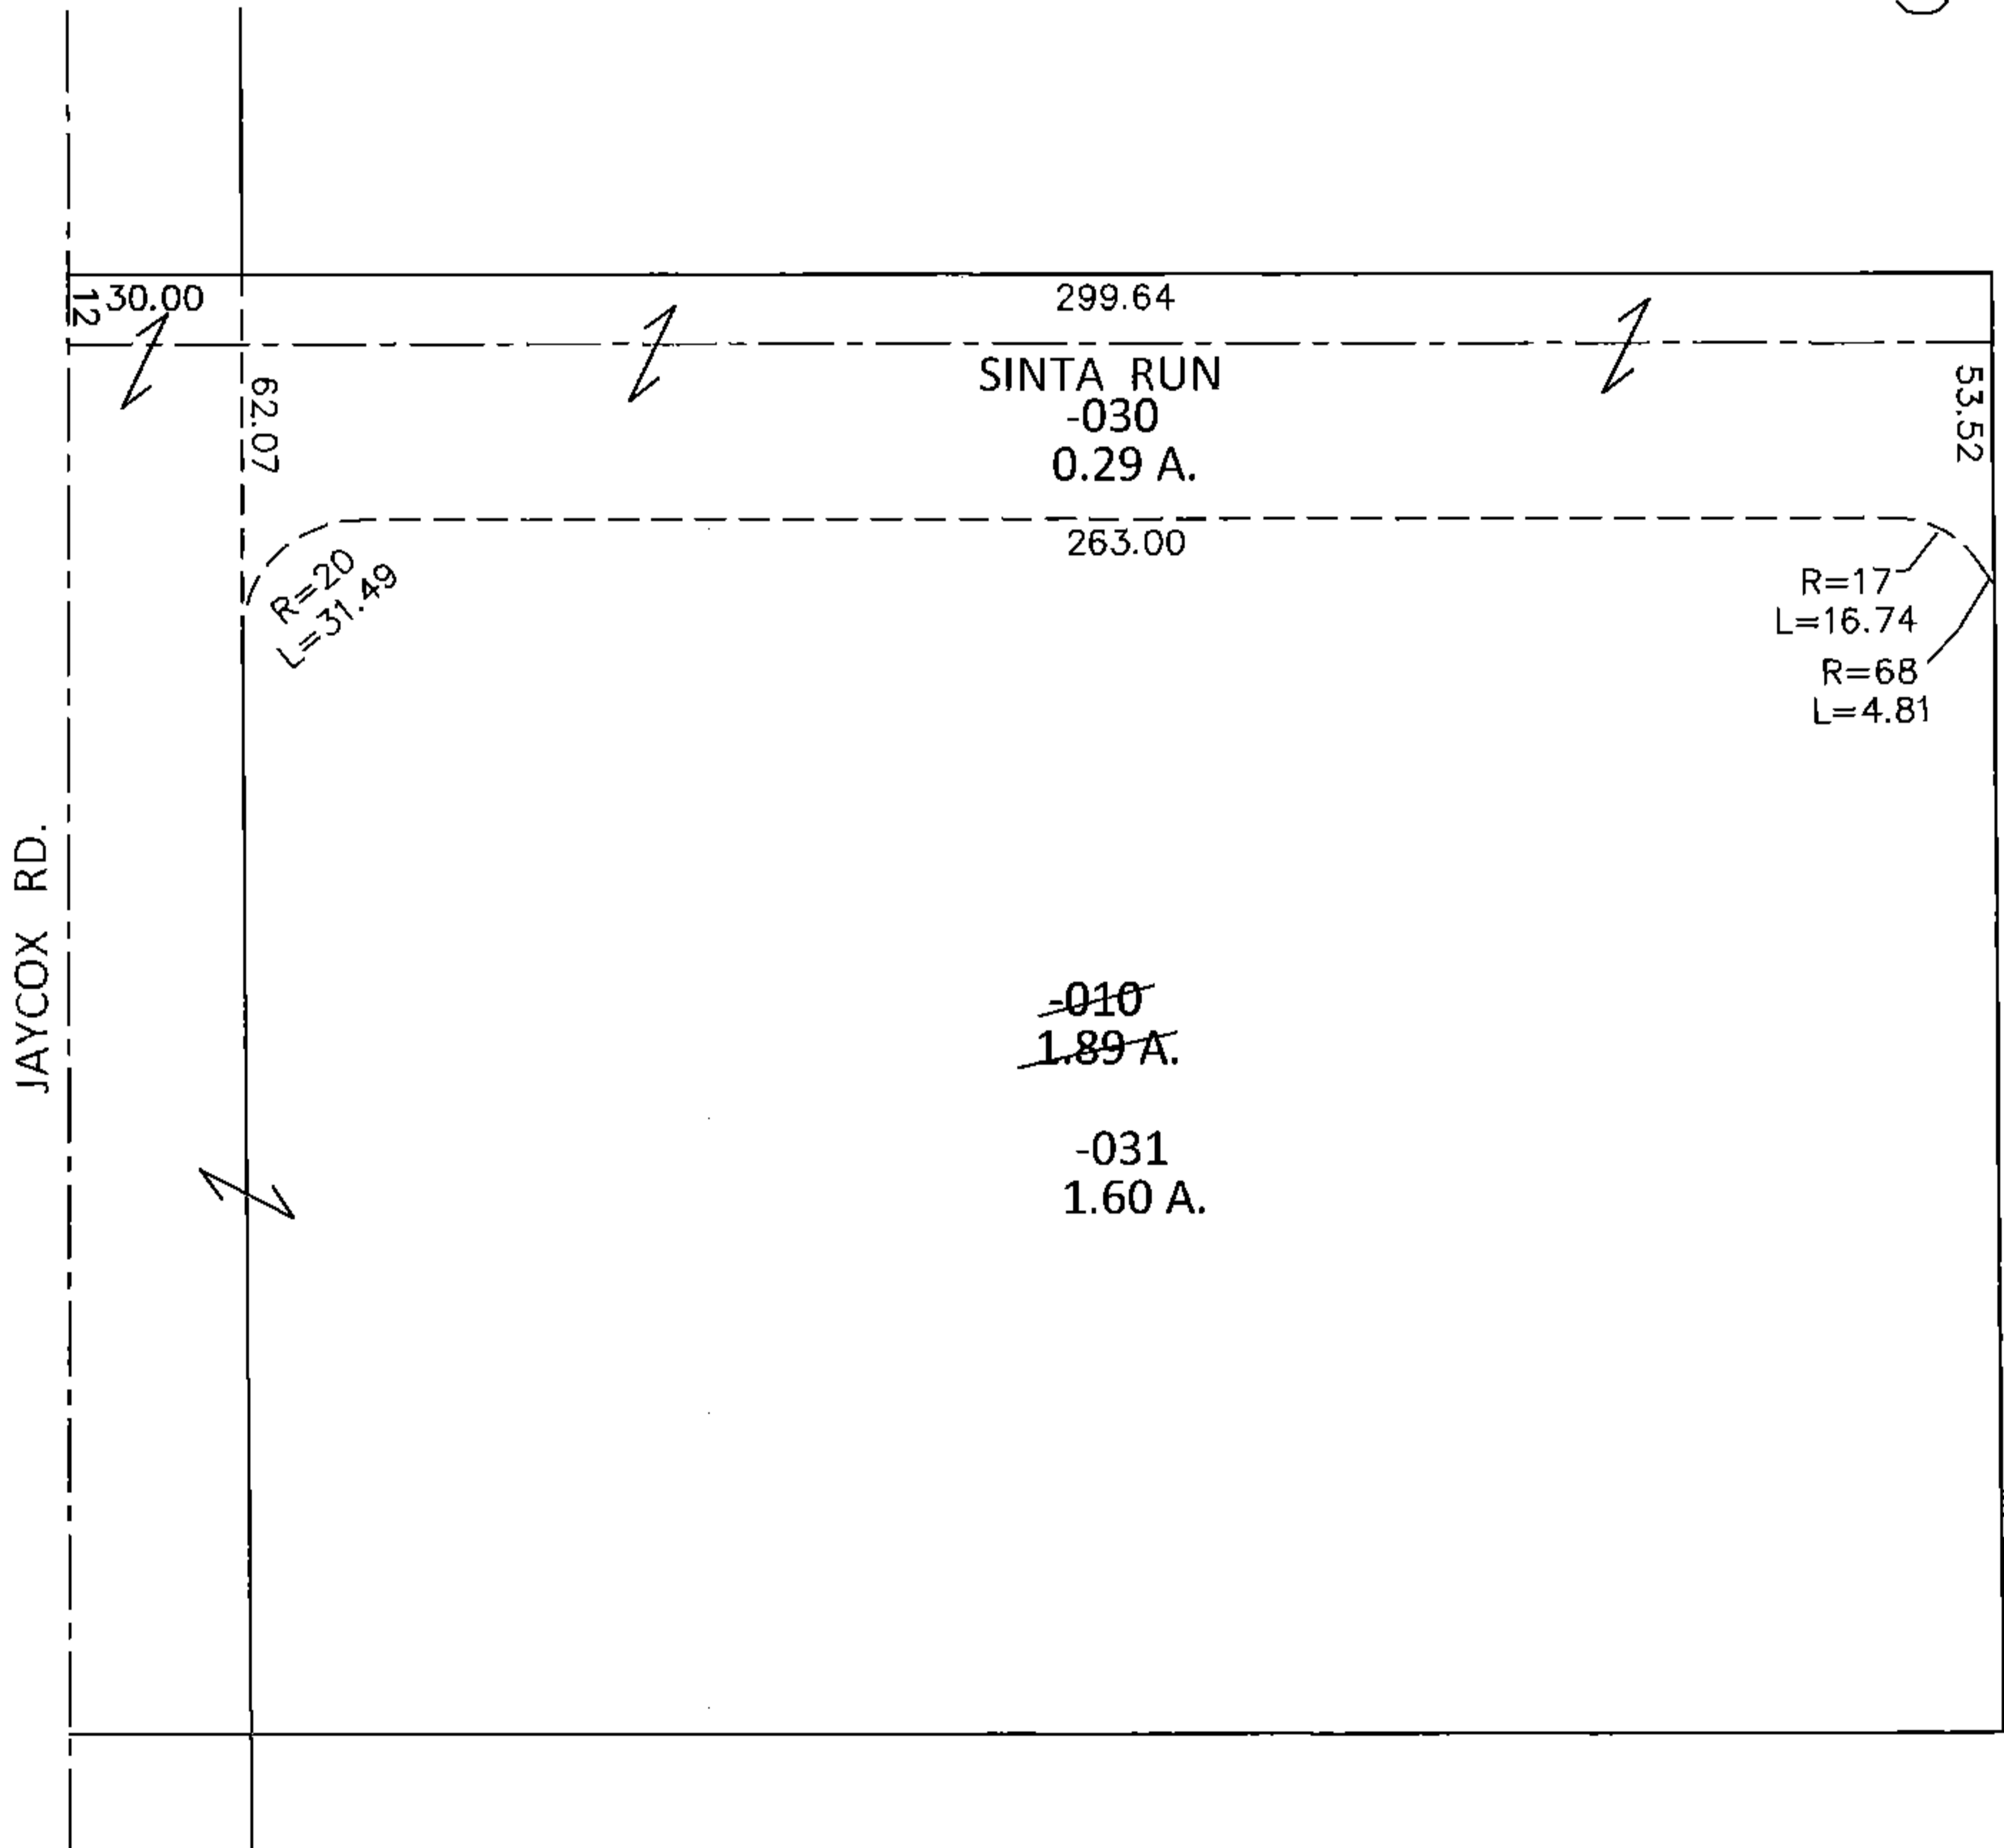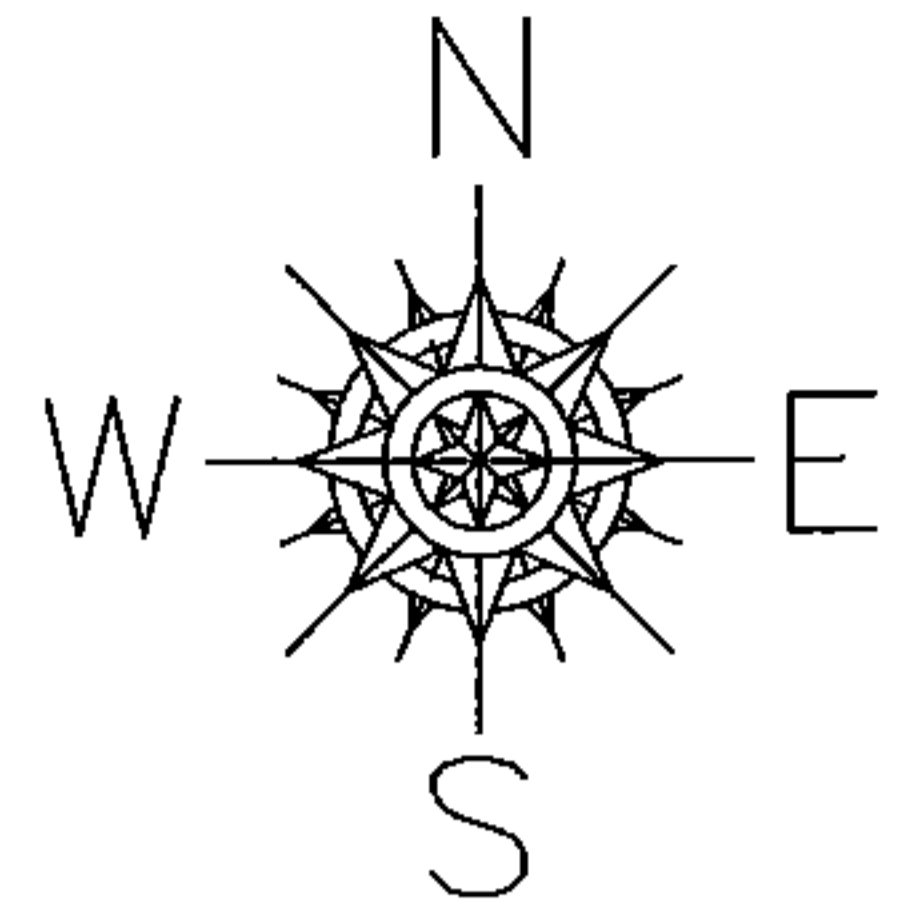

SPLITS/DEEDS PROCESSED

LORAIN COUNTY TAX MAP DEPARTMENT
226 MIDDLE AVE. ELYRIA, OHIO

SURVEYED BY: WILLIAM D. THOMAS

CLOSURE: .01:10,000

MAP PAGE(S): 7-00-016-A

APPROVED BY: RRM DATE: 10-21-14

SCALE: 1"= 50' PRIOR INST.: 20050094892