


PARENT PARCEL: 07-00-016-101-015

CHILD PARCEL: 07-00-016-101-048, -049



STARTING POINT: INTERSECTION OF C/L SINTA RUN AND C/L OF JAYCOX RD.

14-00664

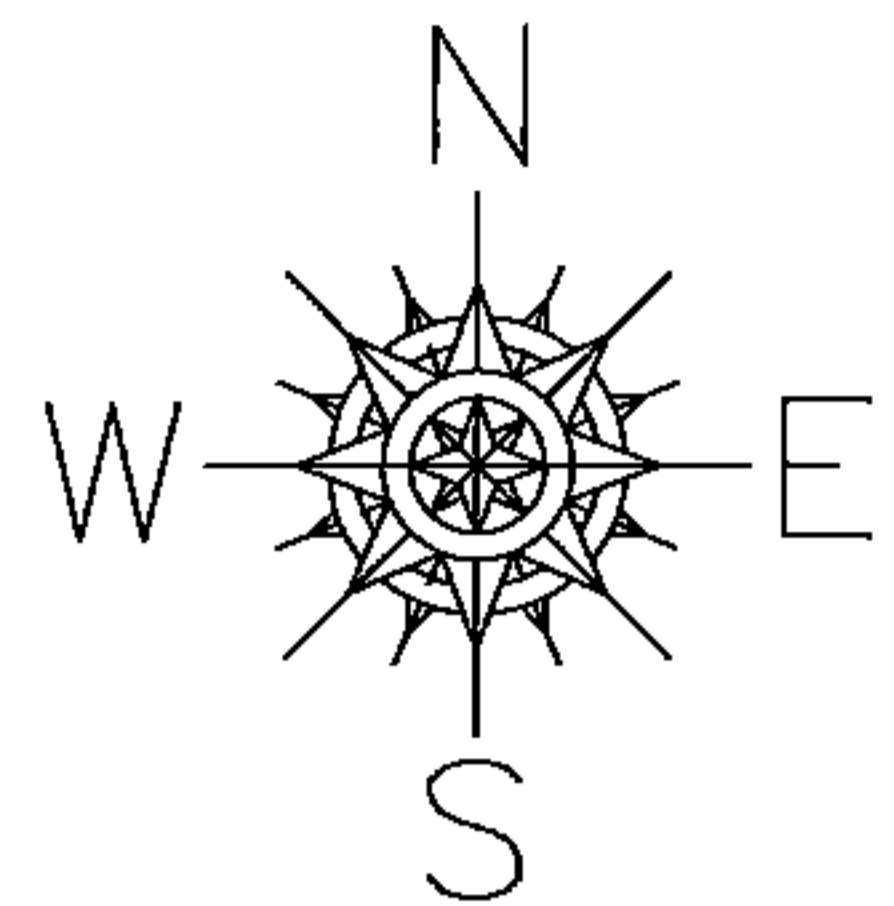

LOR-20-22.13

273-WDV

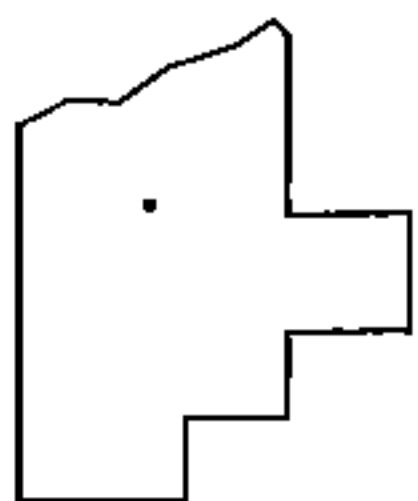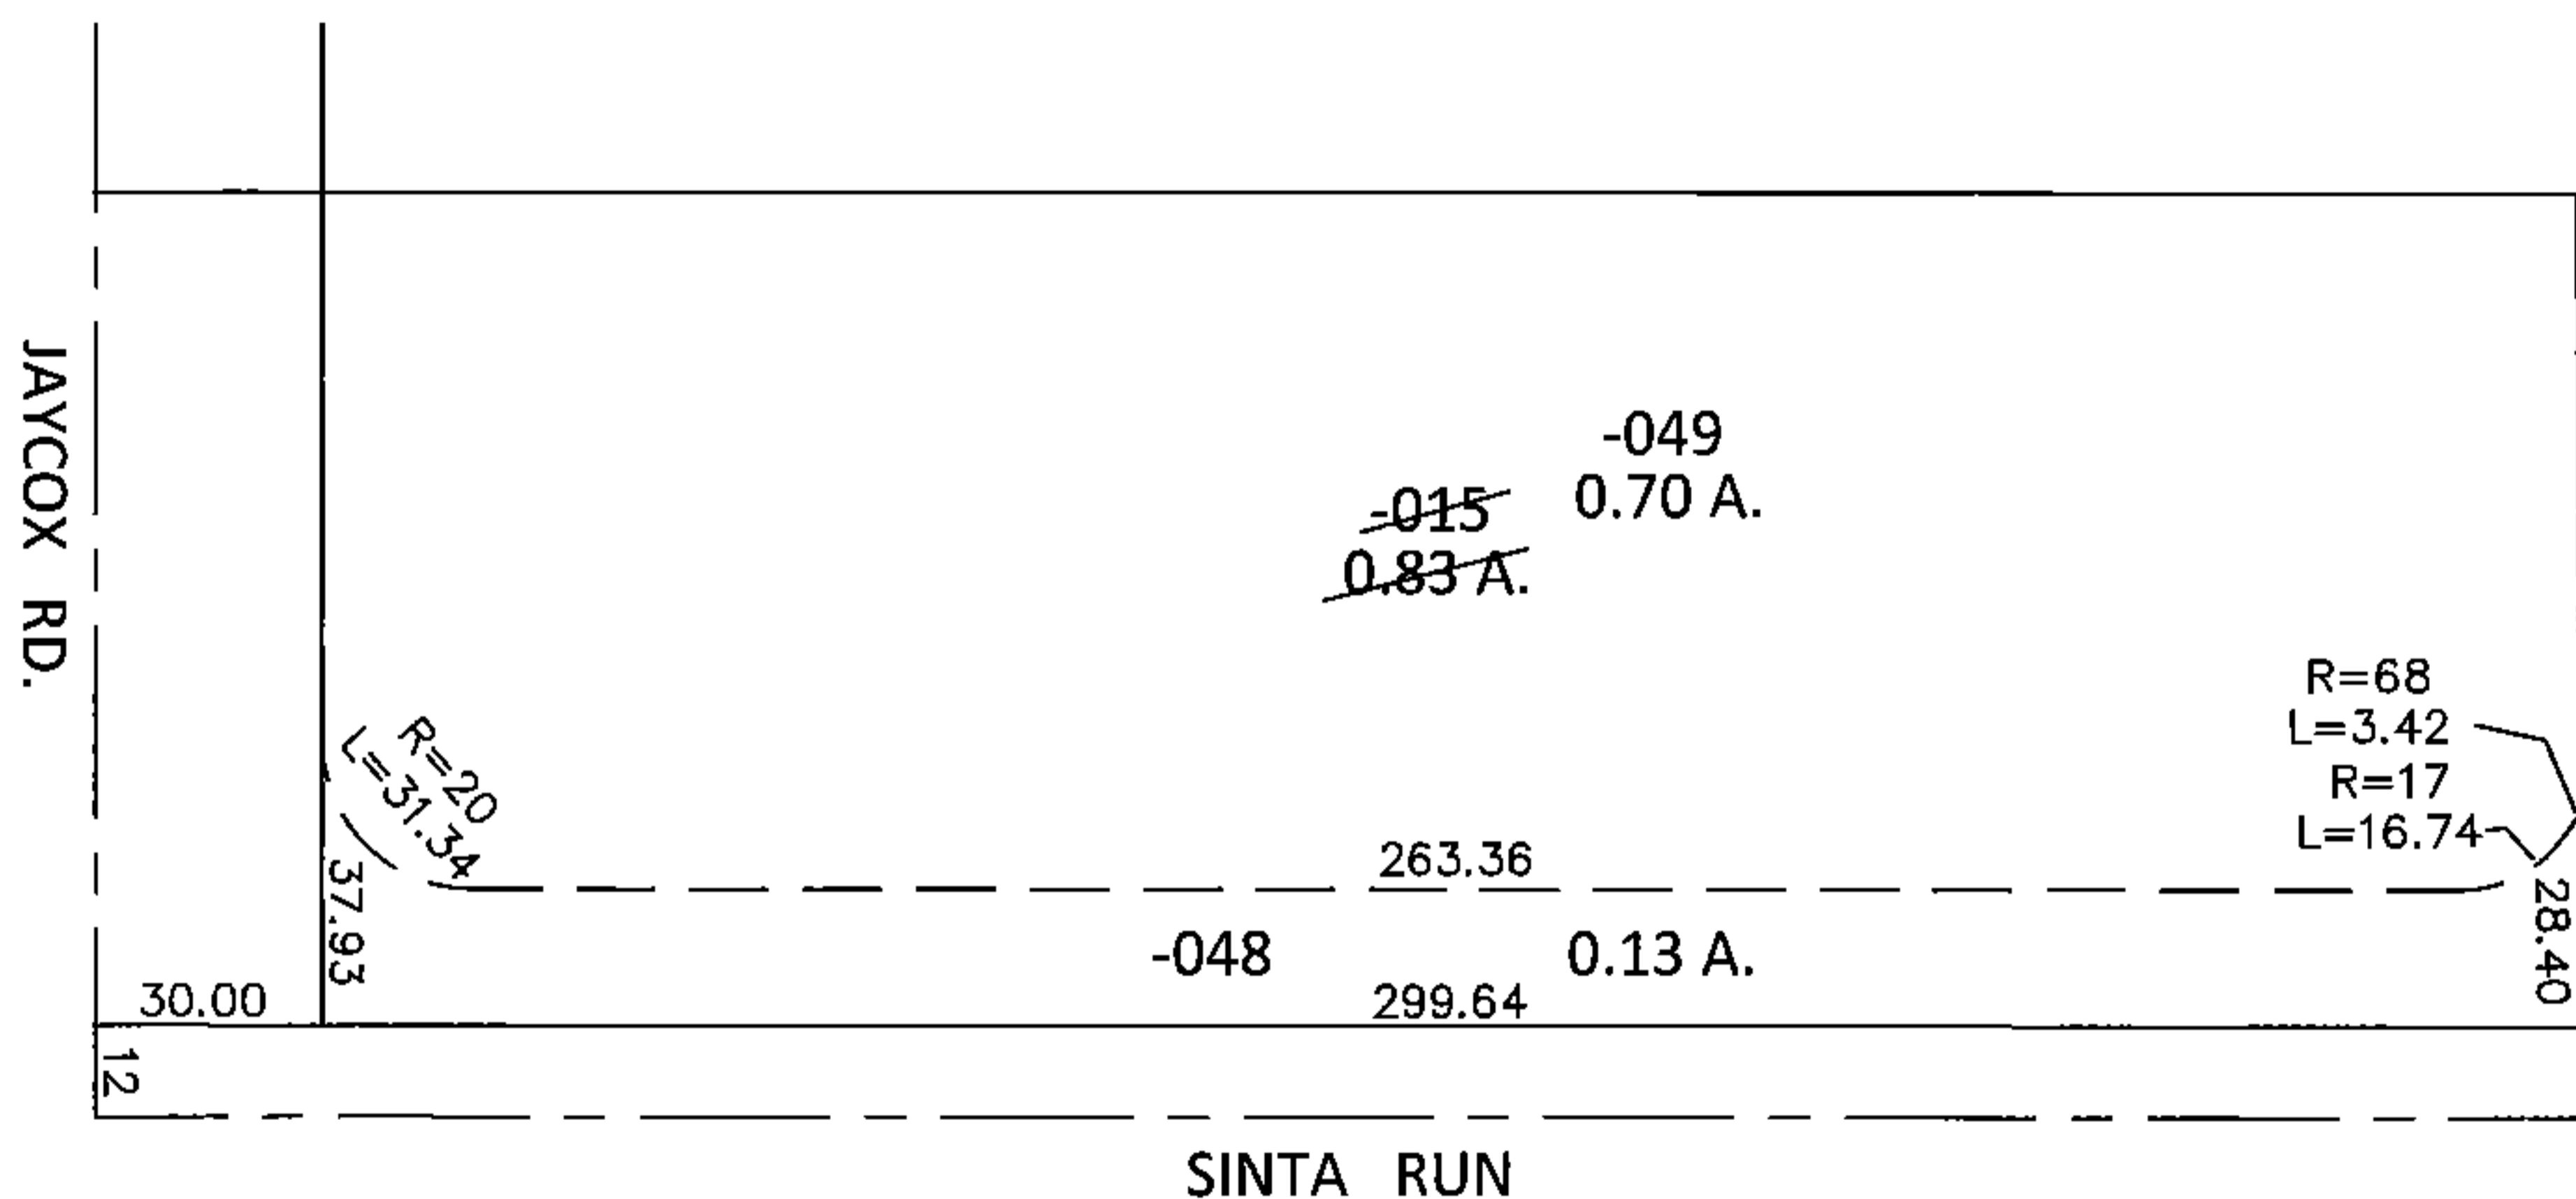

SPLITS/DEEDS PROCESSED

LORAIN COUNTY TAX MAP DEPARTMENT  
226 MIDDLE AVE. ELYRIA, OHIO

SURVEYED BY: WILLIAM D. THOMAS

CLOSURE: .01:10,000

MAP PAGE(S): 7-00-016-A

APPROVED BY: RRM DATE: 3-25-15

SCALE: 1"= 50' PRIOR INST.: 20060183264