


PARENT PARCEL: 07-00-016-103-006

CHILD PARCEL: 07-00-016-103-022, -023

STARTING POINT: INTERSECTION OF C/L OF CENTER RIDGE RD. AND C/L OF WALLACE BLVD.

14-00665


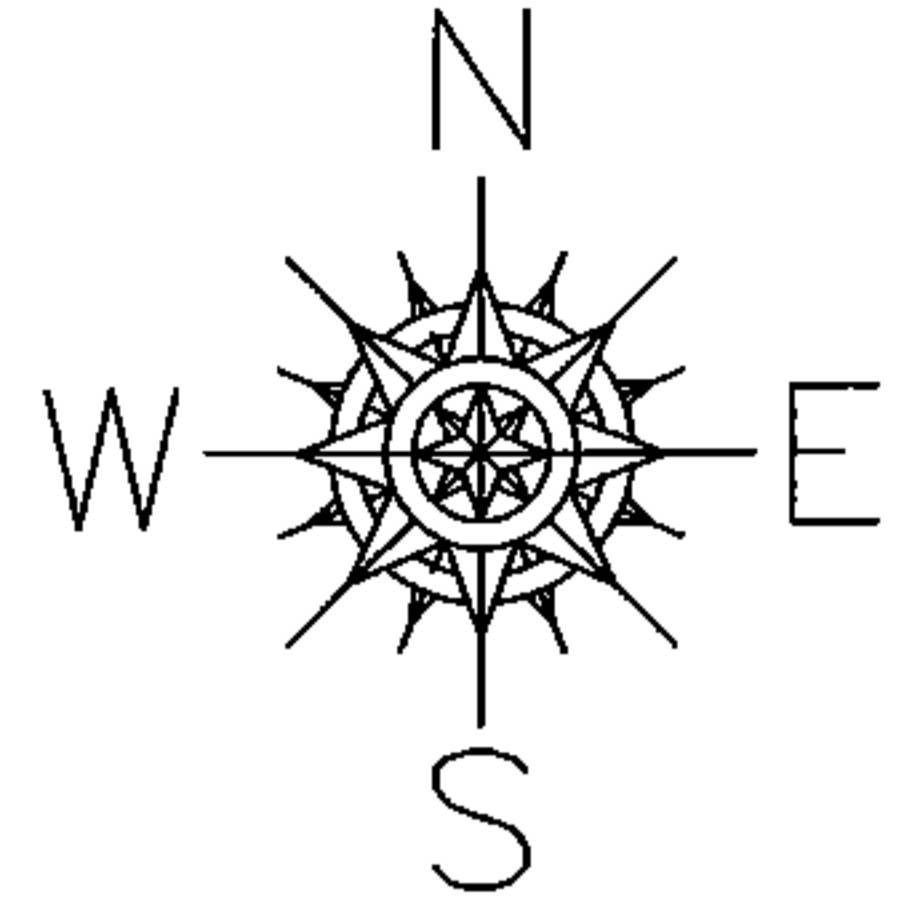


~~07-00-016-103-006~~
~~60 X 133~~

07-00-016-103-022
0.01 A.

07-00-016-103-023
60 X 129

LOR-20-22.13
276-WDV

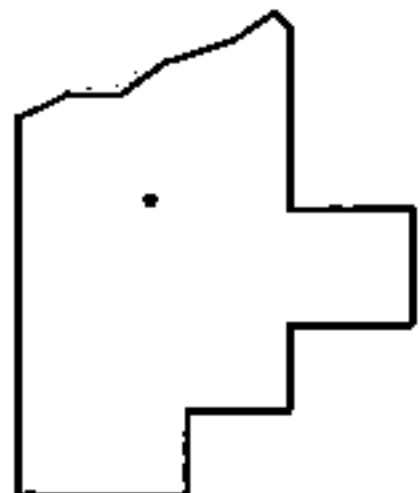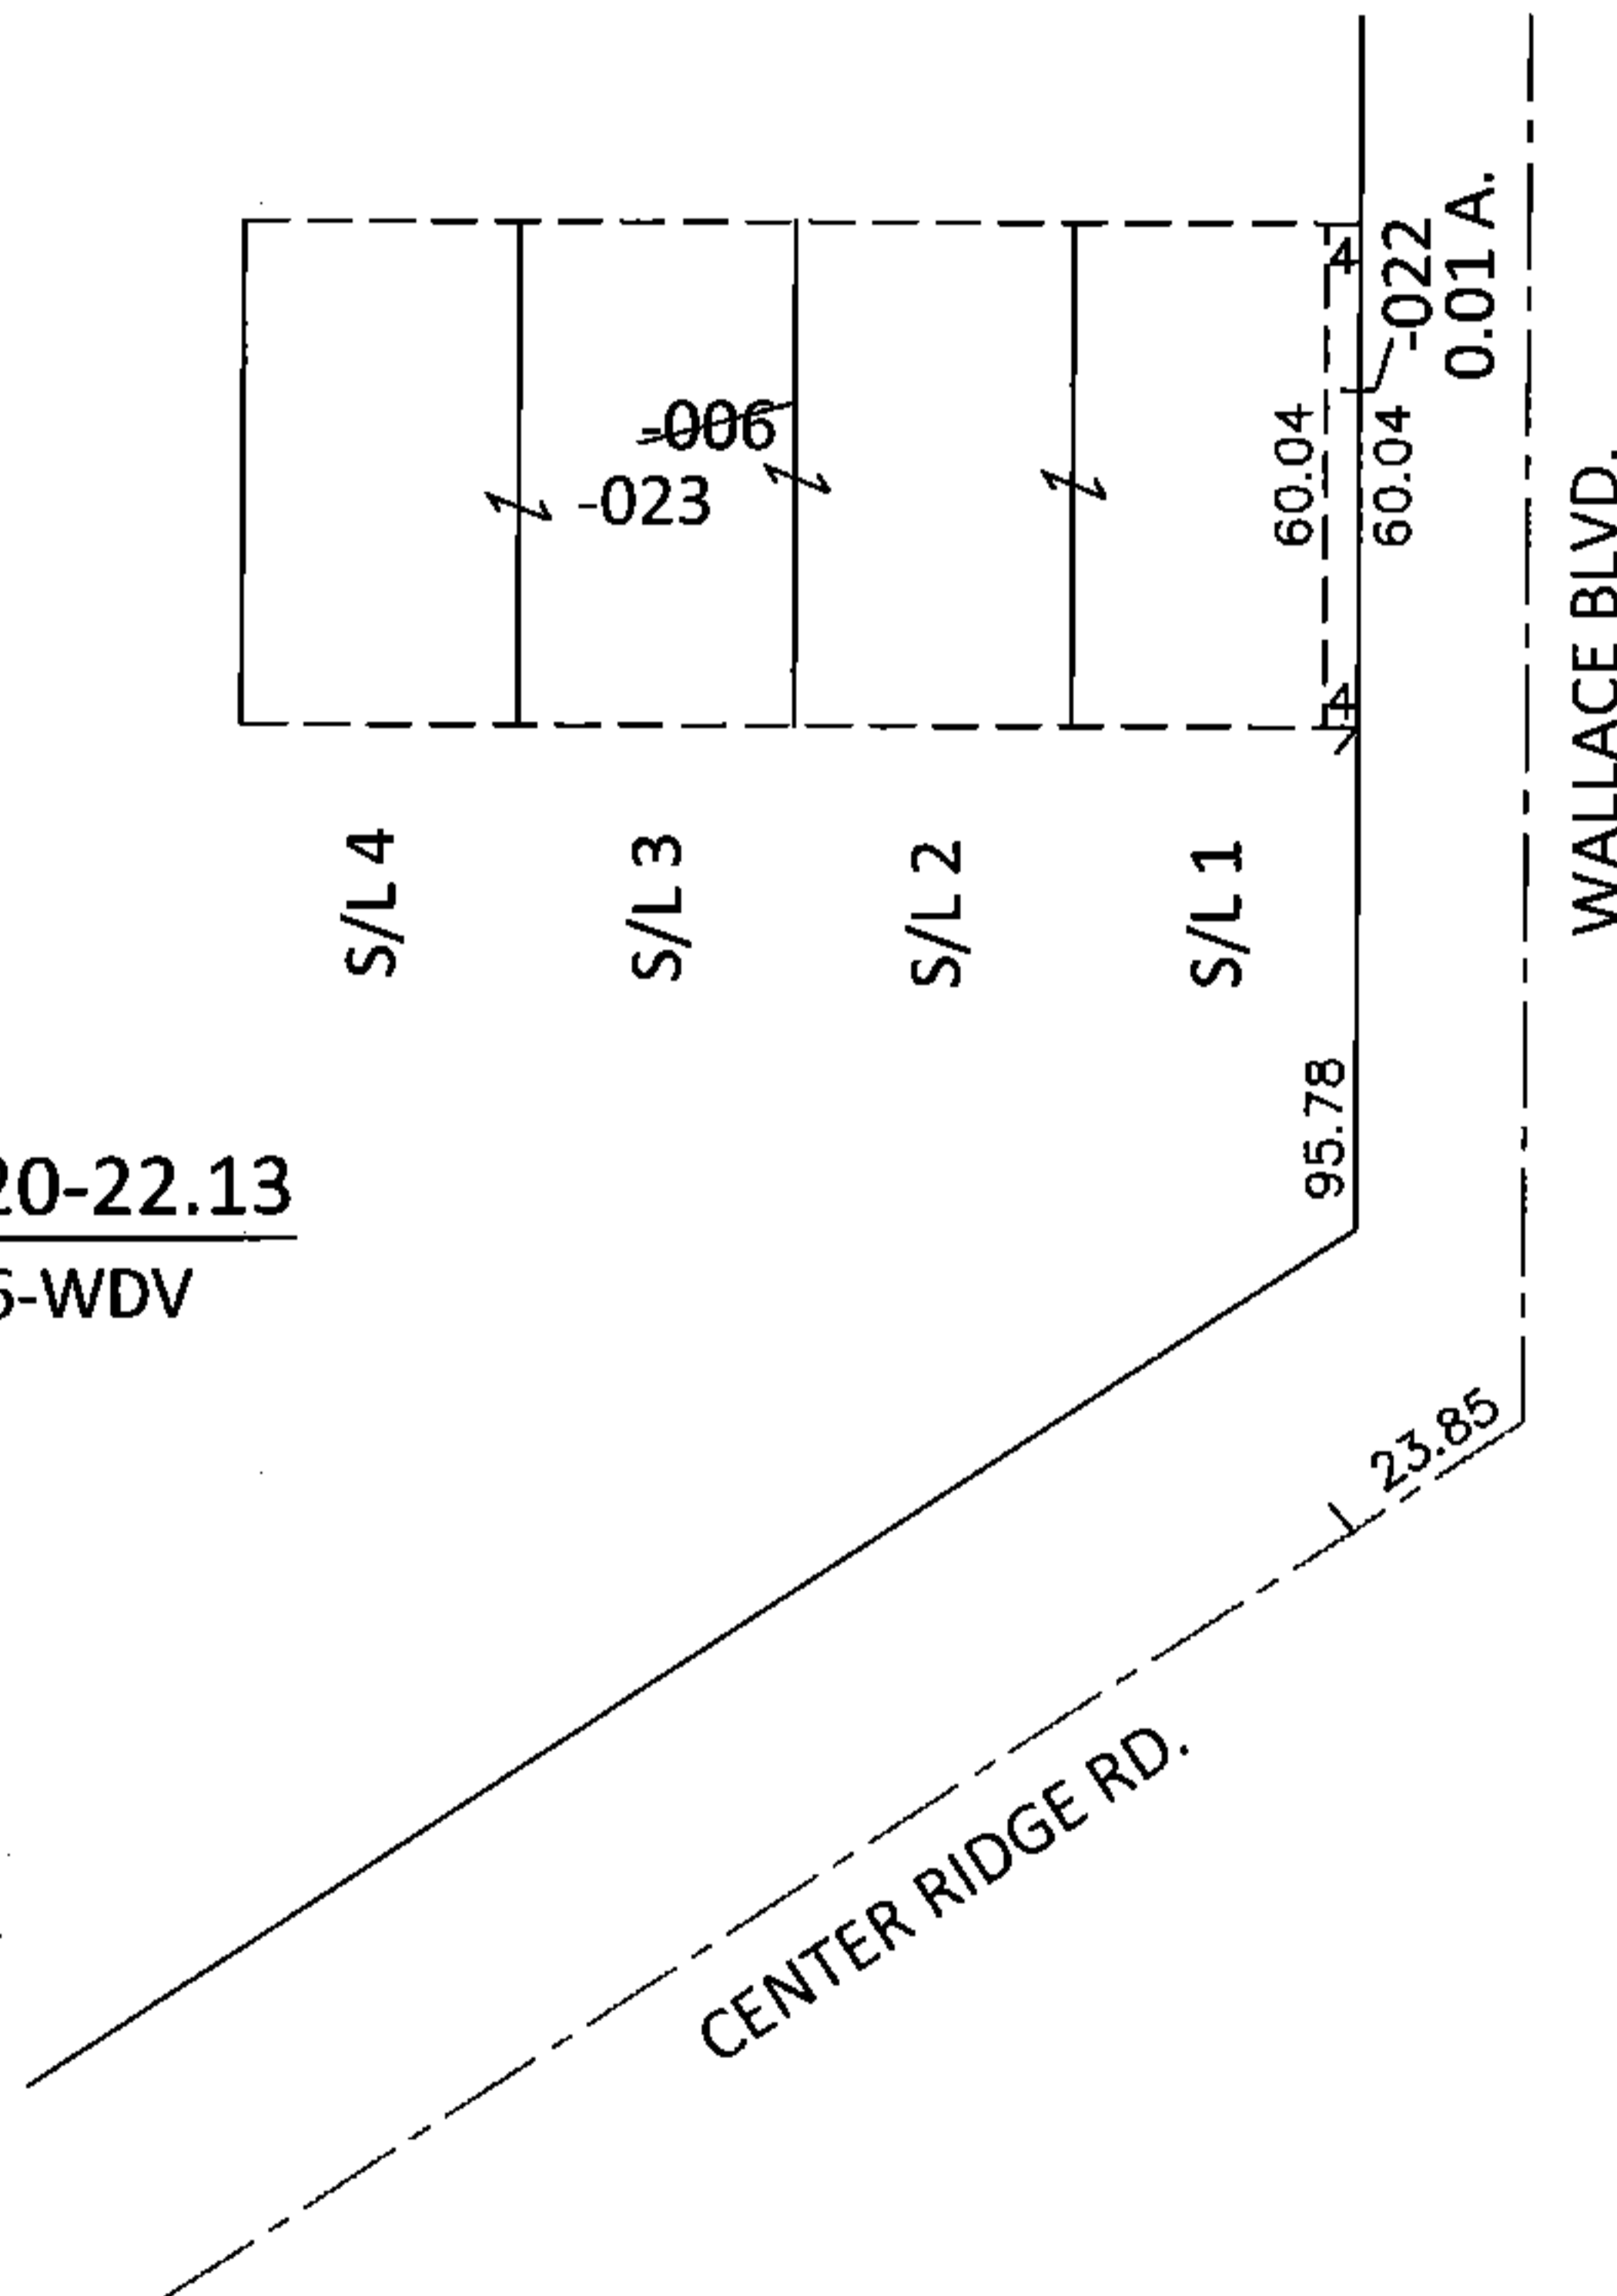

SPLITS/DEEDS PROCESSED

LORAIN COUNTY TAX MAP DEPARTMENT
226 MIDDLE AVE. ELYRIA, OHIO

SURVEYED BY: WILLIAM D. THOMAS

CLOSURE: .01:10,000

MAP PAGE(S): 7-00-016-B

APPROVED BY: RRM DATE: 2-24-15

SCALE: 1"= 50' PRIOR INST.: 20040025479