
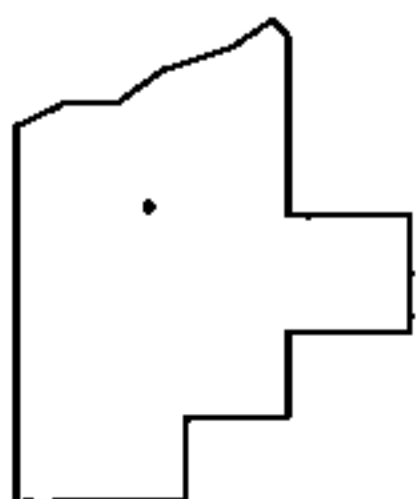
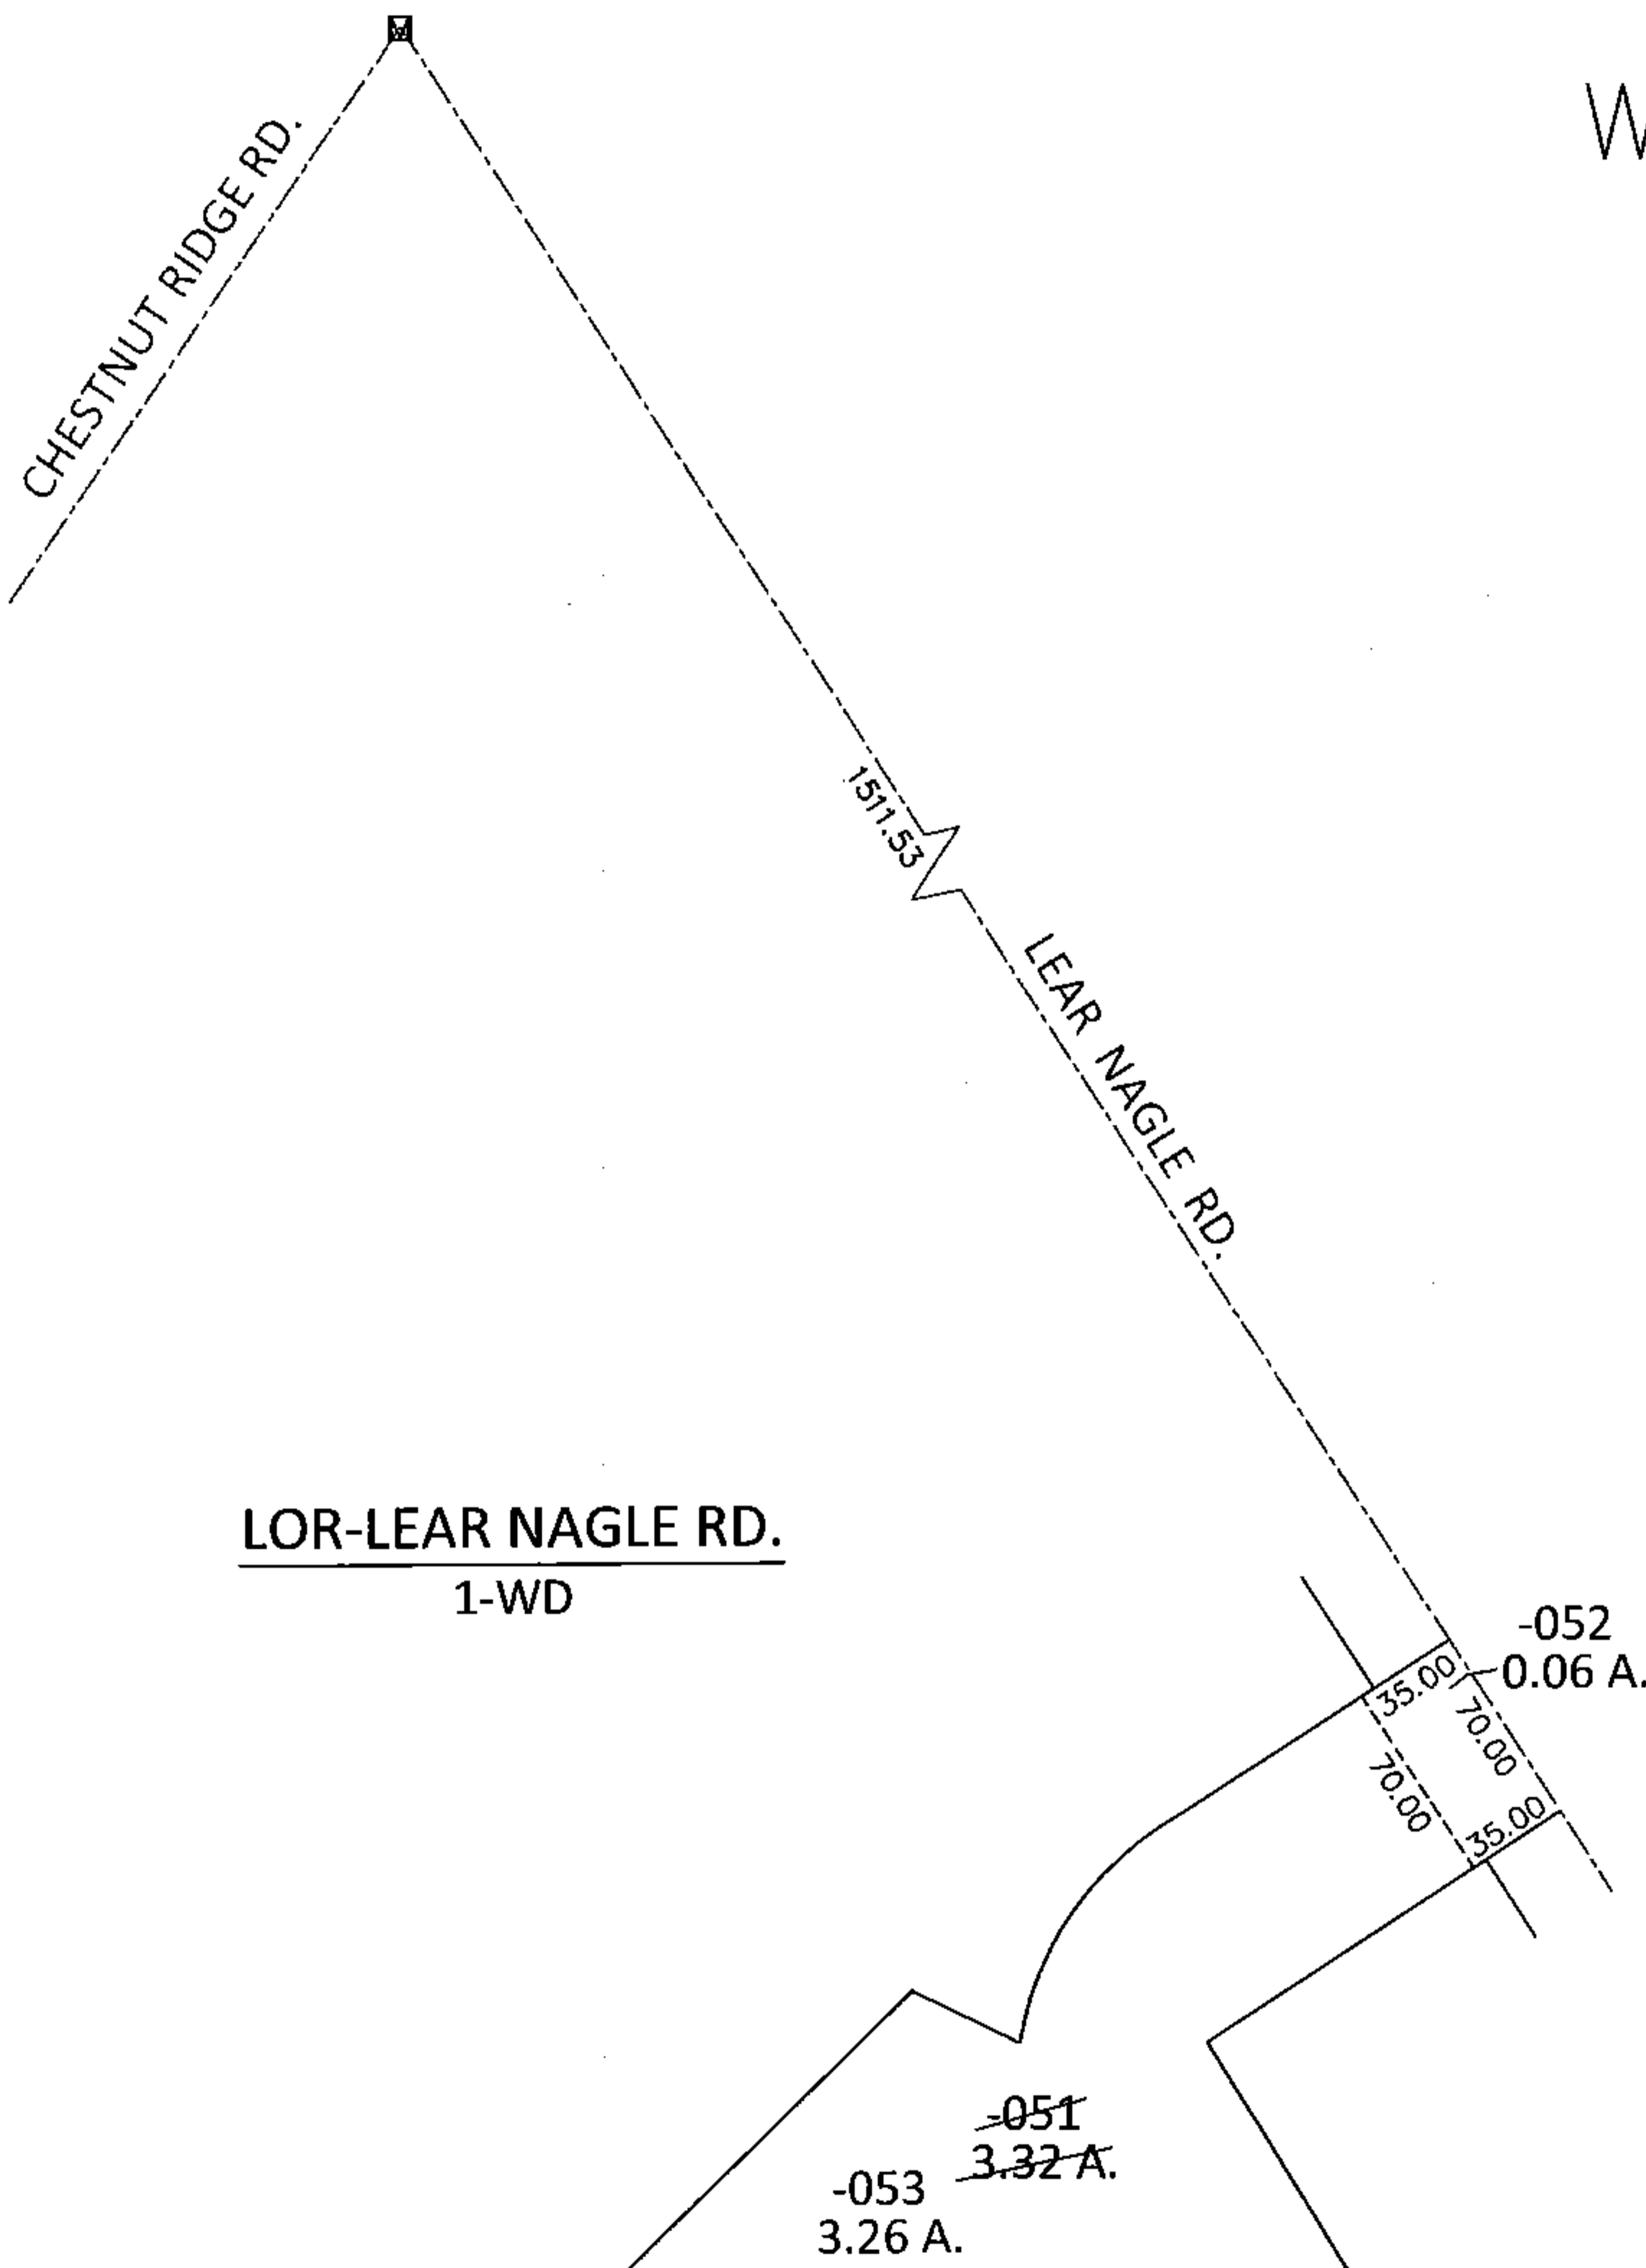


PARENT PARCEL: 07-00-004-109-051

CHILD PARCEL: 07-00-004-109-052, -053

14-00673

STARTING POINT: AT A MON BOX AT THE INTERSECTION OF C/L OF CHESTNUT RIDGE RD. AND C/L OF LEAR NAGLE RD.

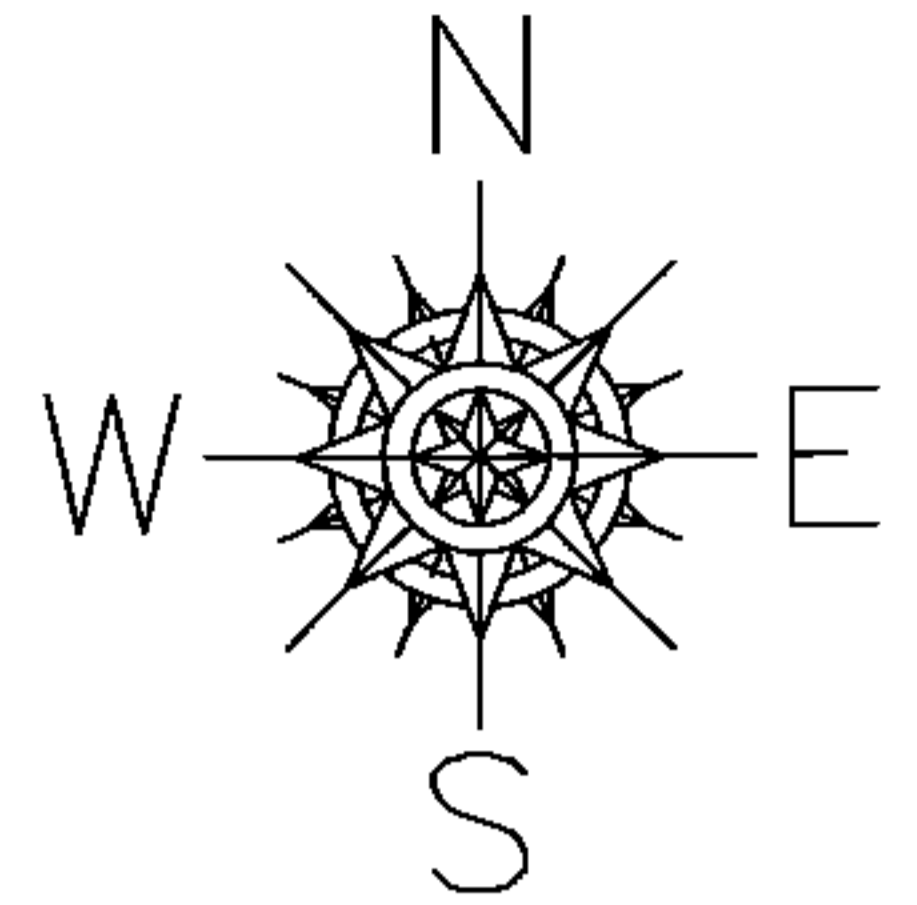

**SPLITS/DEEDS PROCESSED**

LORAIN COUNTY TAX MAP DEPARTMENT  
226 MIDDLE AVE. ELYRIA, OHIO

SURVEYED BY: ROBERT G. HOY

CLOSURE: .00:10,000

MAP PAGE(S): 7-00-004-C

APPROVED BY: RRM DATE: 9-9-14

SCALE: 1"= 100 PRIOR INST.: 20090301710