


PARENT PARCEL: 07-00-004-109-025

CHILD PARCEL: 07-00-004-109-054, -055

14-00674

STARTING POINT: AT A MON BOX AT THE INTERSECTION OF C/L OF CHESTNUT RIDGE RD. AND C/L OF LEAR NAGLE RD.

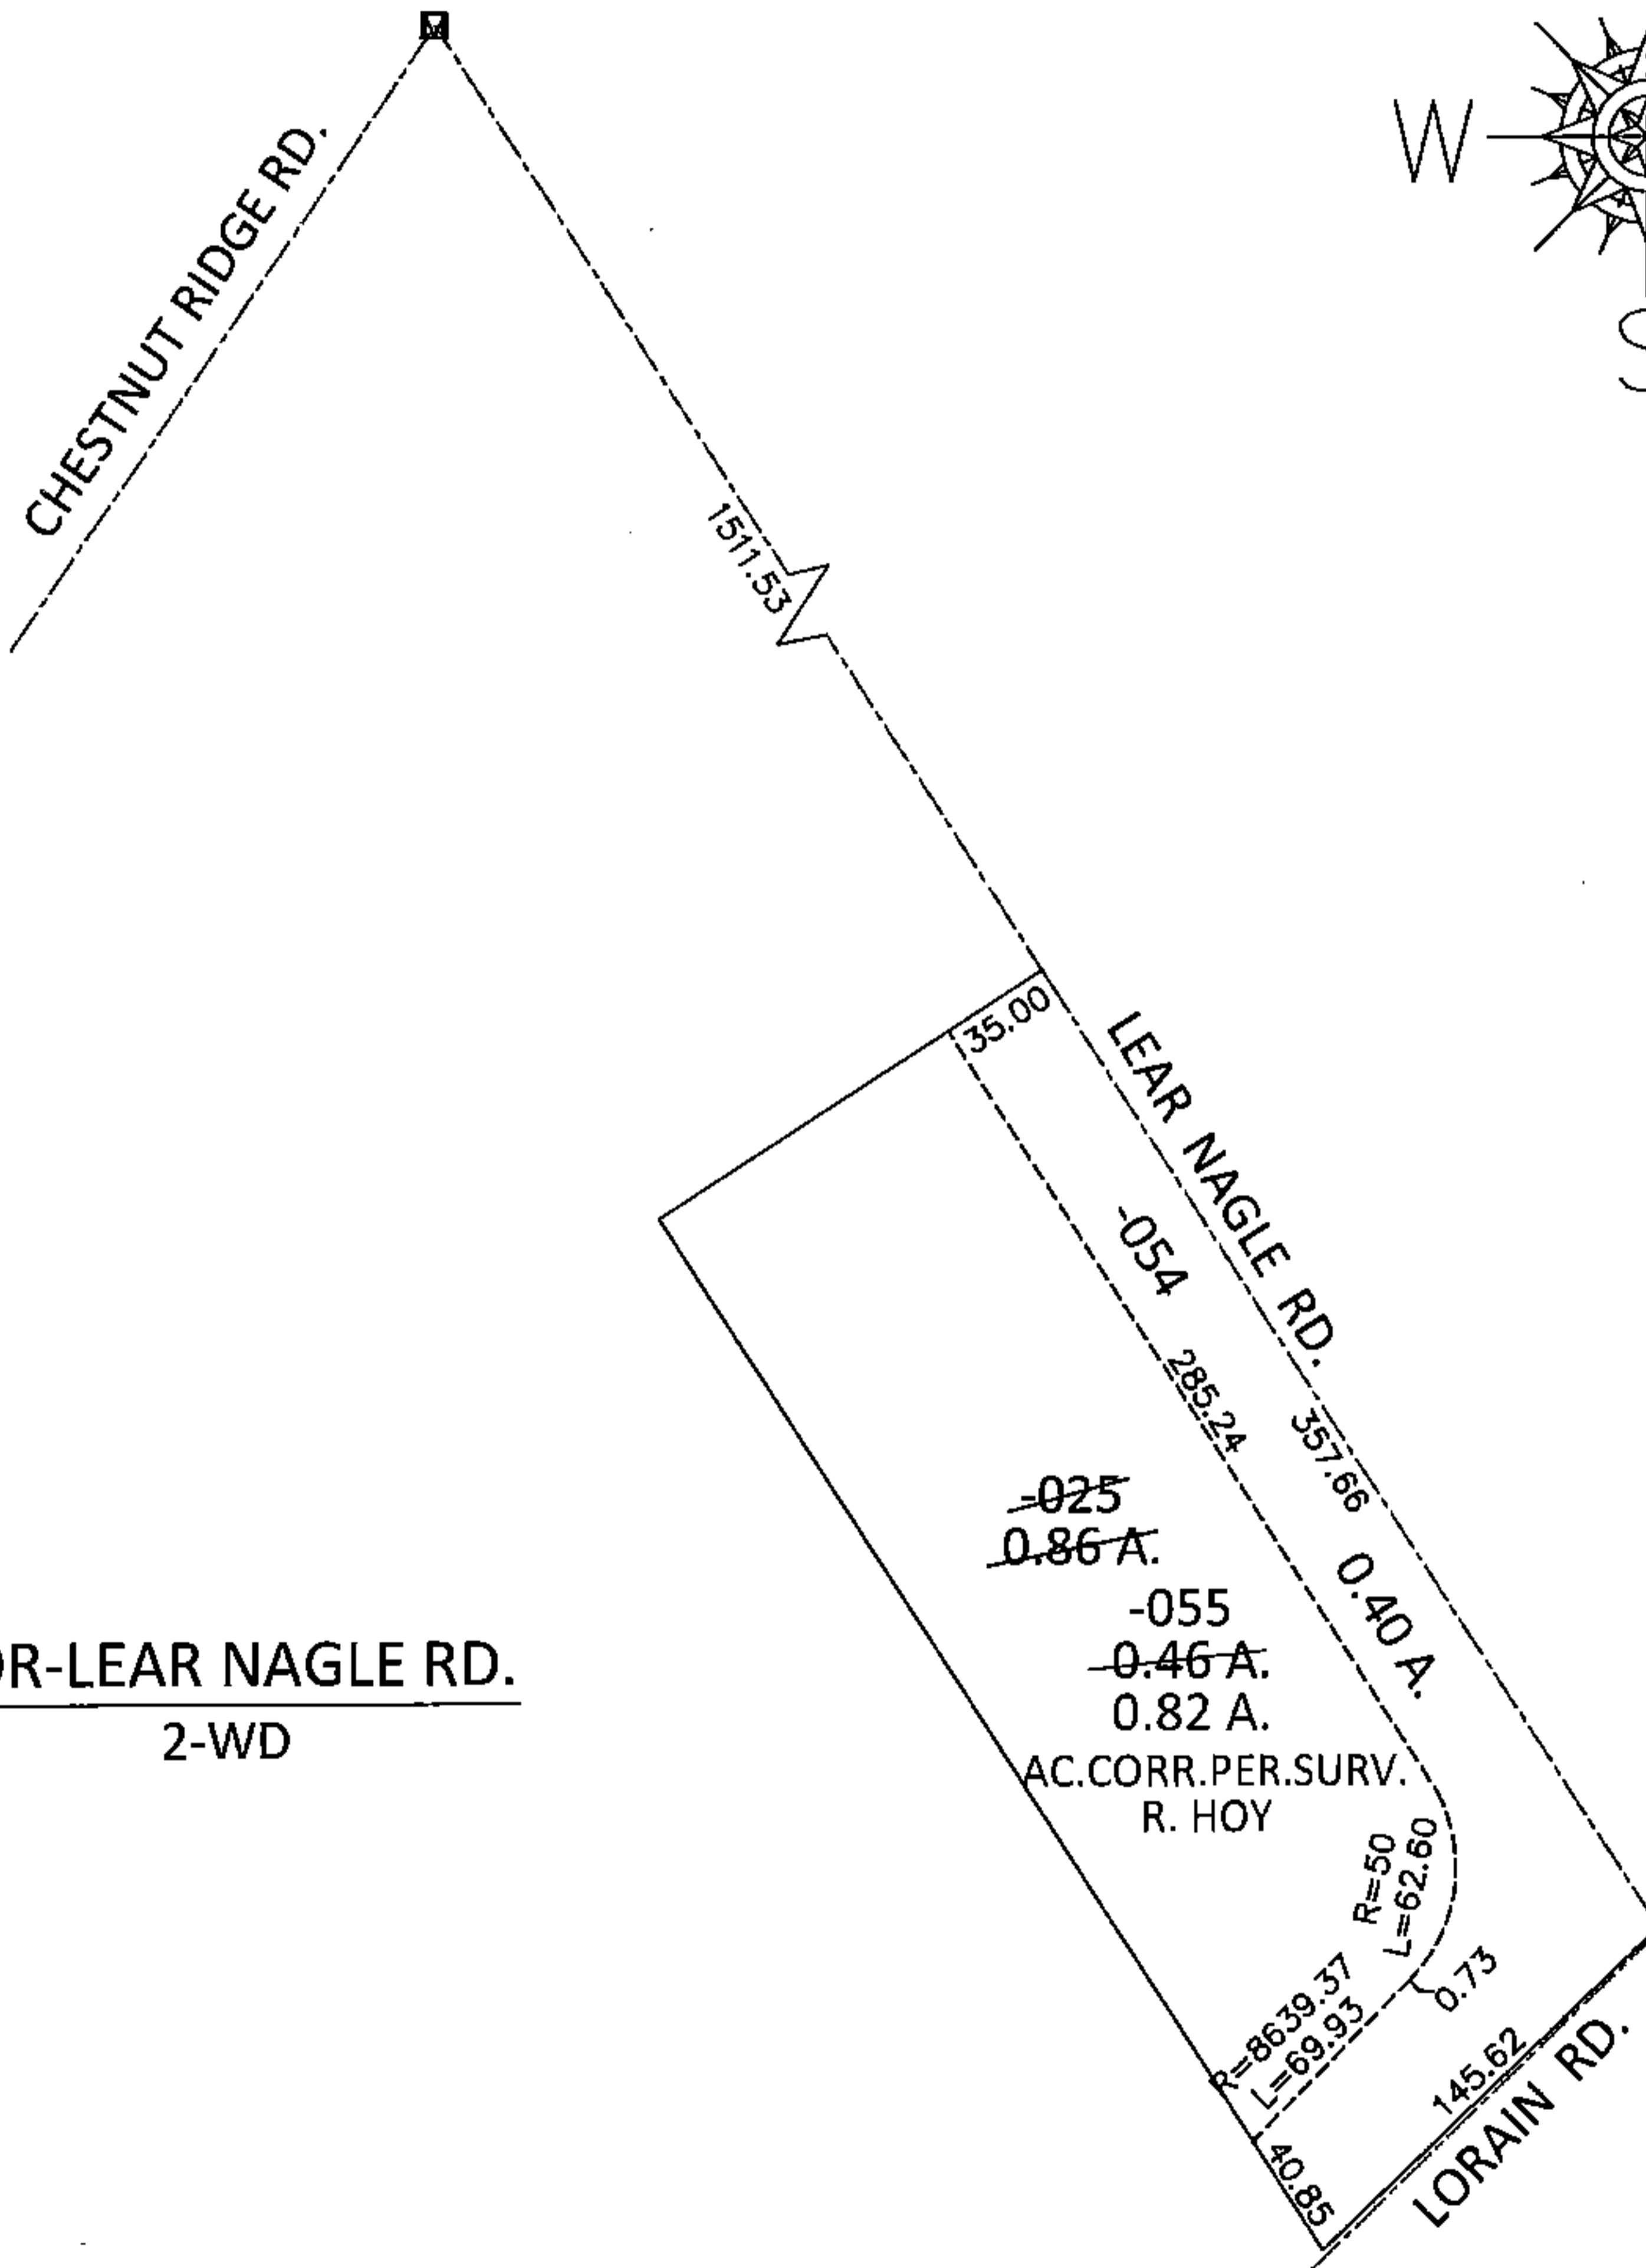

LOR-LEAR NAGLE RD.  
2-WD


~~-025~~  
~~0.86 A.~~

~~-055~~  
~~0.46 A.~~  
0.82 A.

AC. CORR. PER. SURV.  
R. HOY

R=50  
L=62.60  
R=86.39  
L=69.93

145.62  
LORAIN RD.

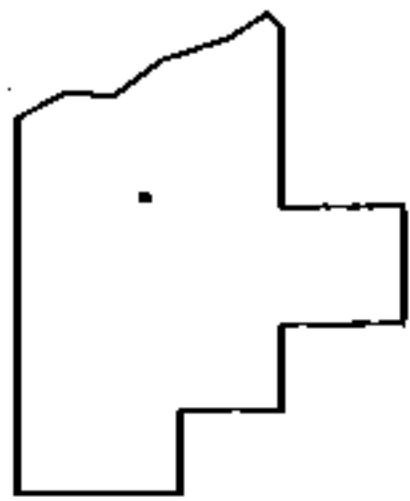

SPLITS/DEEDS PROCESSED

LORAIN COUNTY TAX MAP DEPARTMENT  
226 MIDDLE AVE. ELYRIA, OHIO

SURVEYED BY: ROBERT G. HOY

CLOSURE: .00:10,000

MAP PAGE(S): 7-00-004-C

APPROVED BY: RRM DATE: 9-9-14

SCALE: 1"= 100 PRIOR INST.: 20020832290