


PARENT PARCEL: 07-00-004-108-092, -095


CHILD PARCEL: 07-00-004-108-103 THRU -105

14-00677

STARTING POINT: AT A MON BOX AT THE INTERSECTION OF C/L OF CHESTNUT RIDGE RD. AND C/L OF LEAR NAGLE RD.

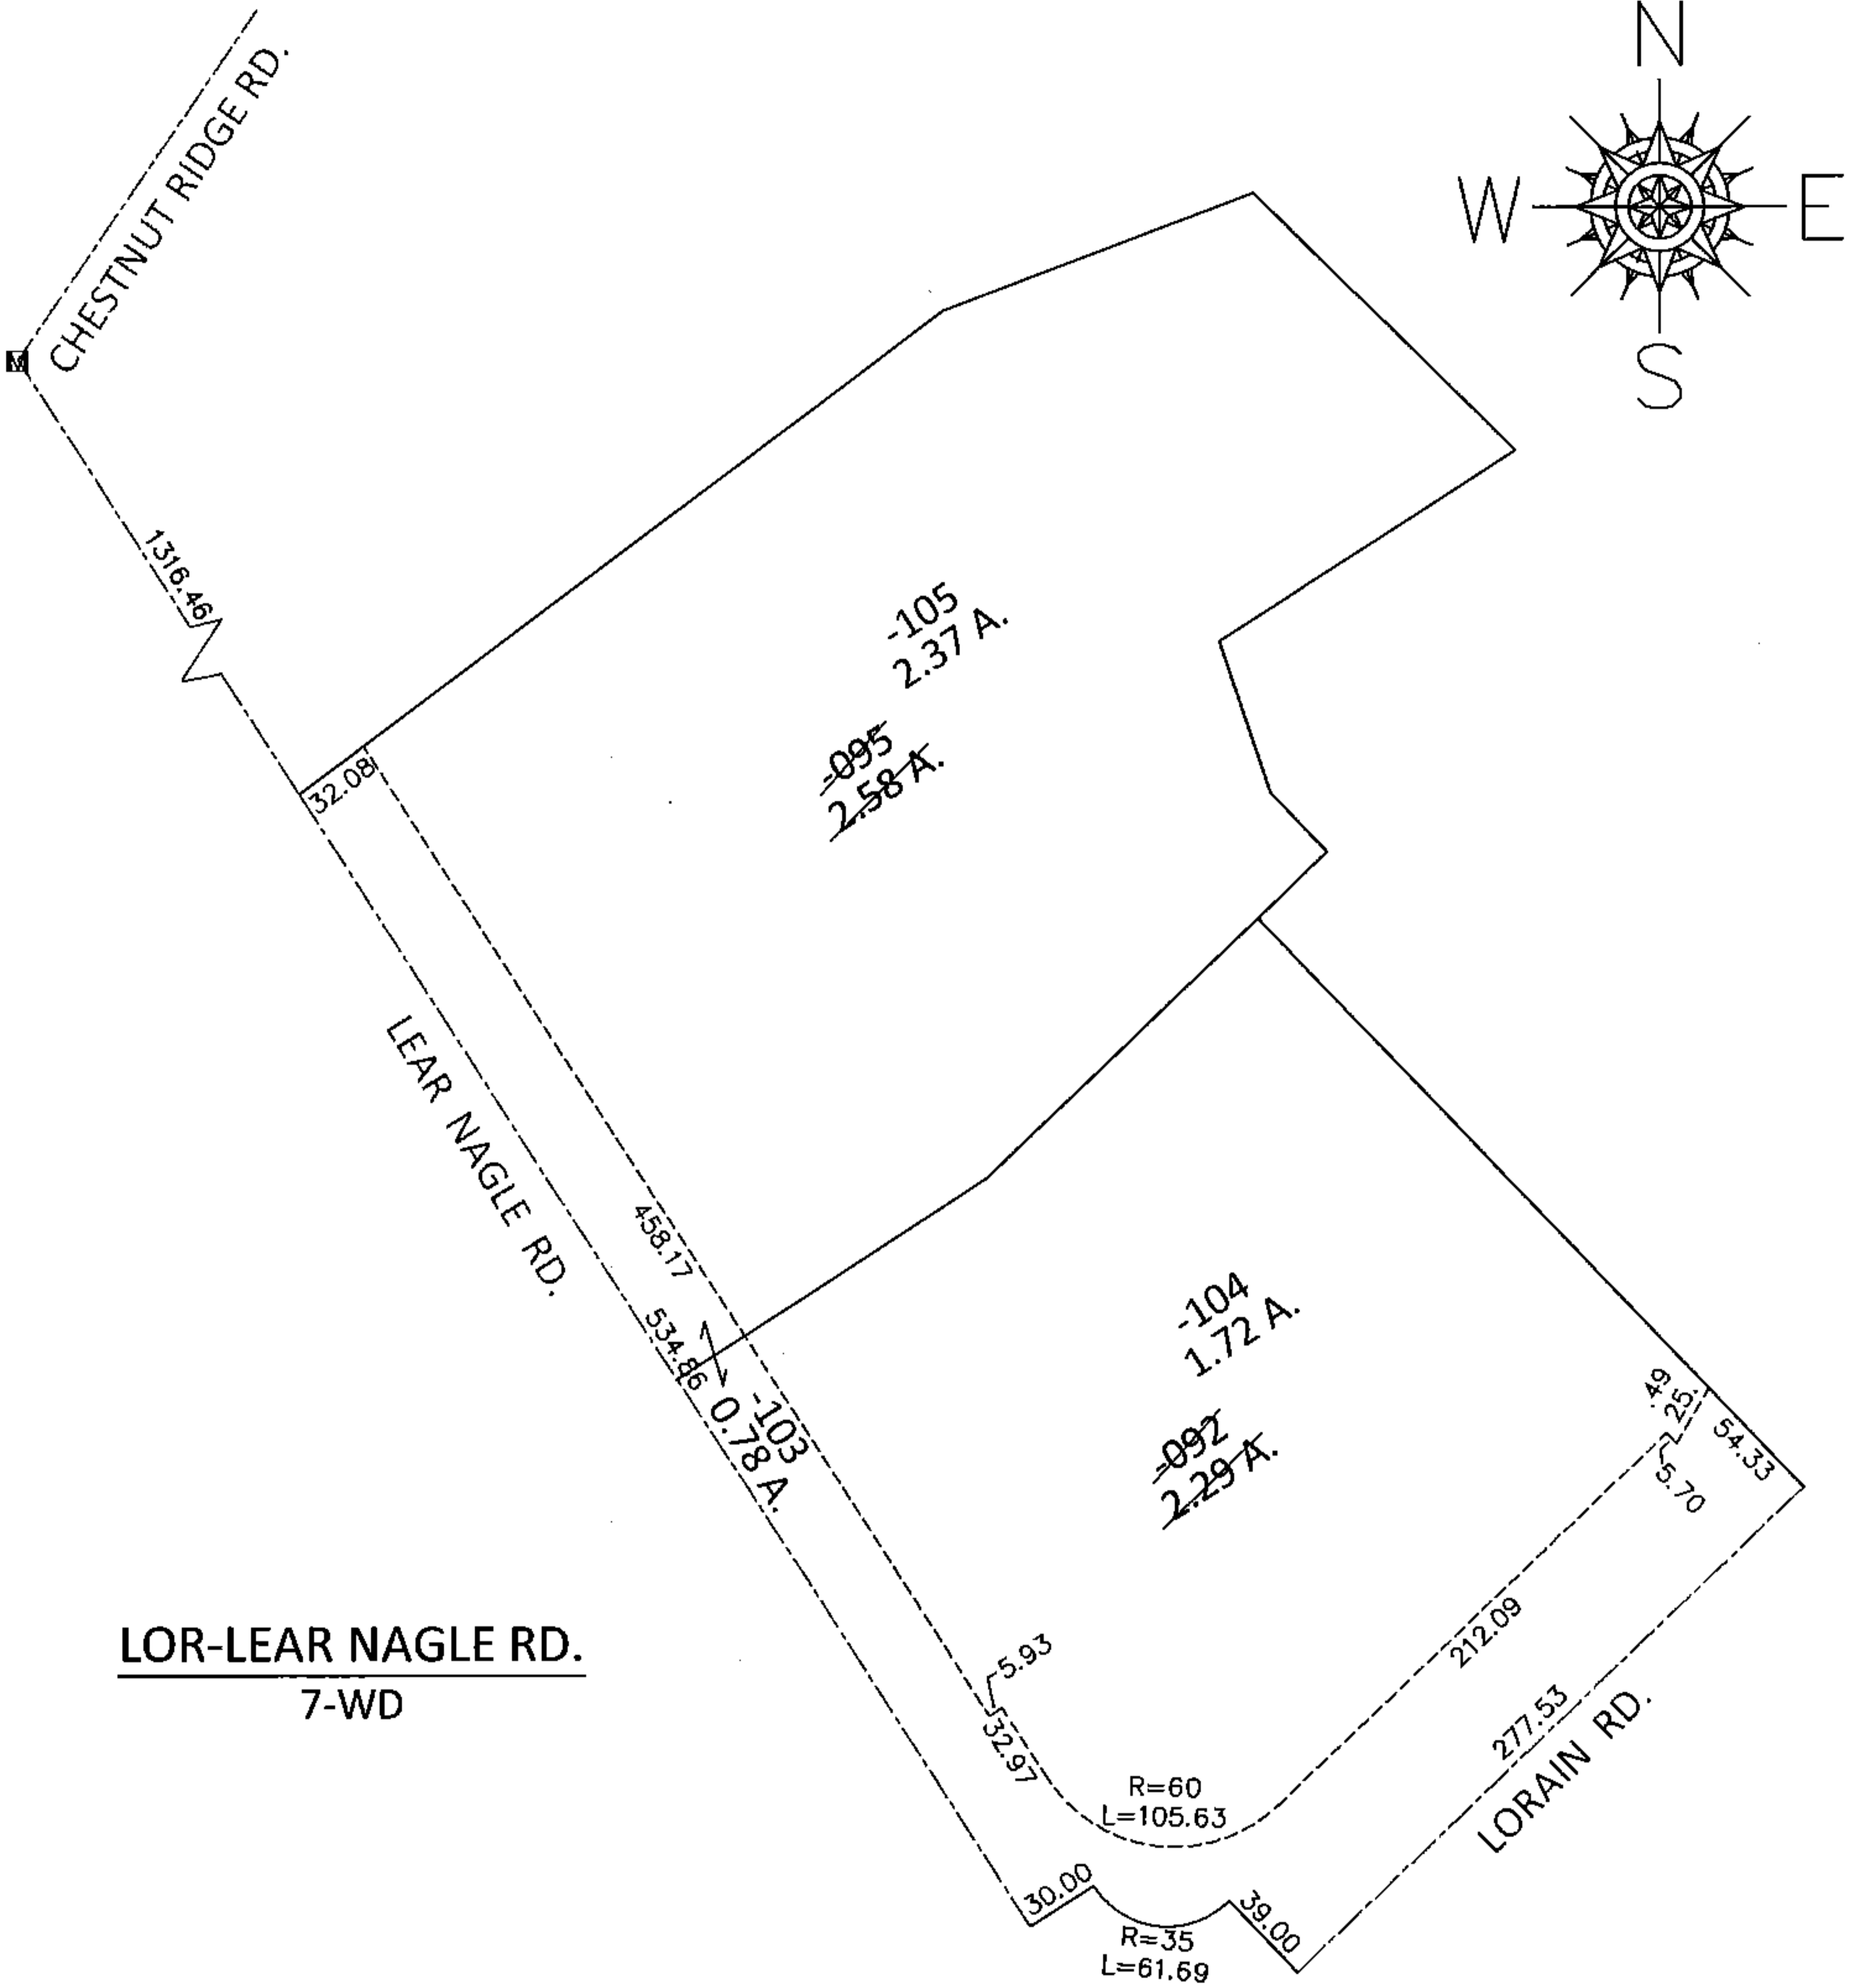

LOR-LEAR NAGLE RD.
7-WD

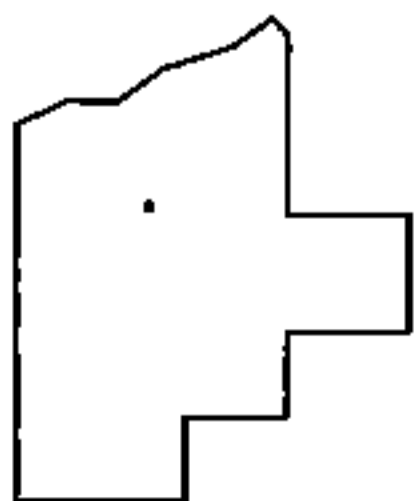

SPLITS/DEEDS PROCESSED

LORAIN COUNTY TAX MAP DEPARTMENT
226 MIDDLE AVE. ELYRIA, OHIO

SURVEYED BY: ROBERT G. HOY

CLOSURE: .00:10,000

MAP PAGE(S): 7-00-004-C

APPROVED BY: RRM DATE: 9-9-14

SCALE: 1"= 100 PRIOR INST.: 20030956862