


PARENT PARCEL: 07-00-004-108-081


CHILD PARCEL: 07-00-004-108-106 & -107

STARTING POINT: AT A MON BOX AT THE INTERSECTION OF C/L OF CHESTNUT RIDGE RD. AND C/L OF LEAR NAGLE RD.

14-00678

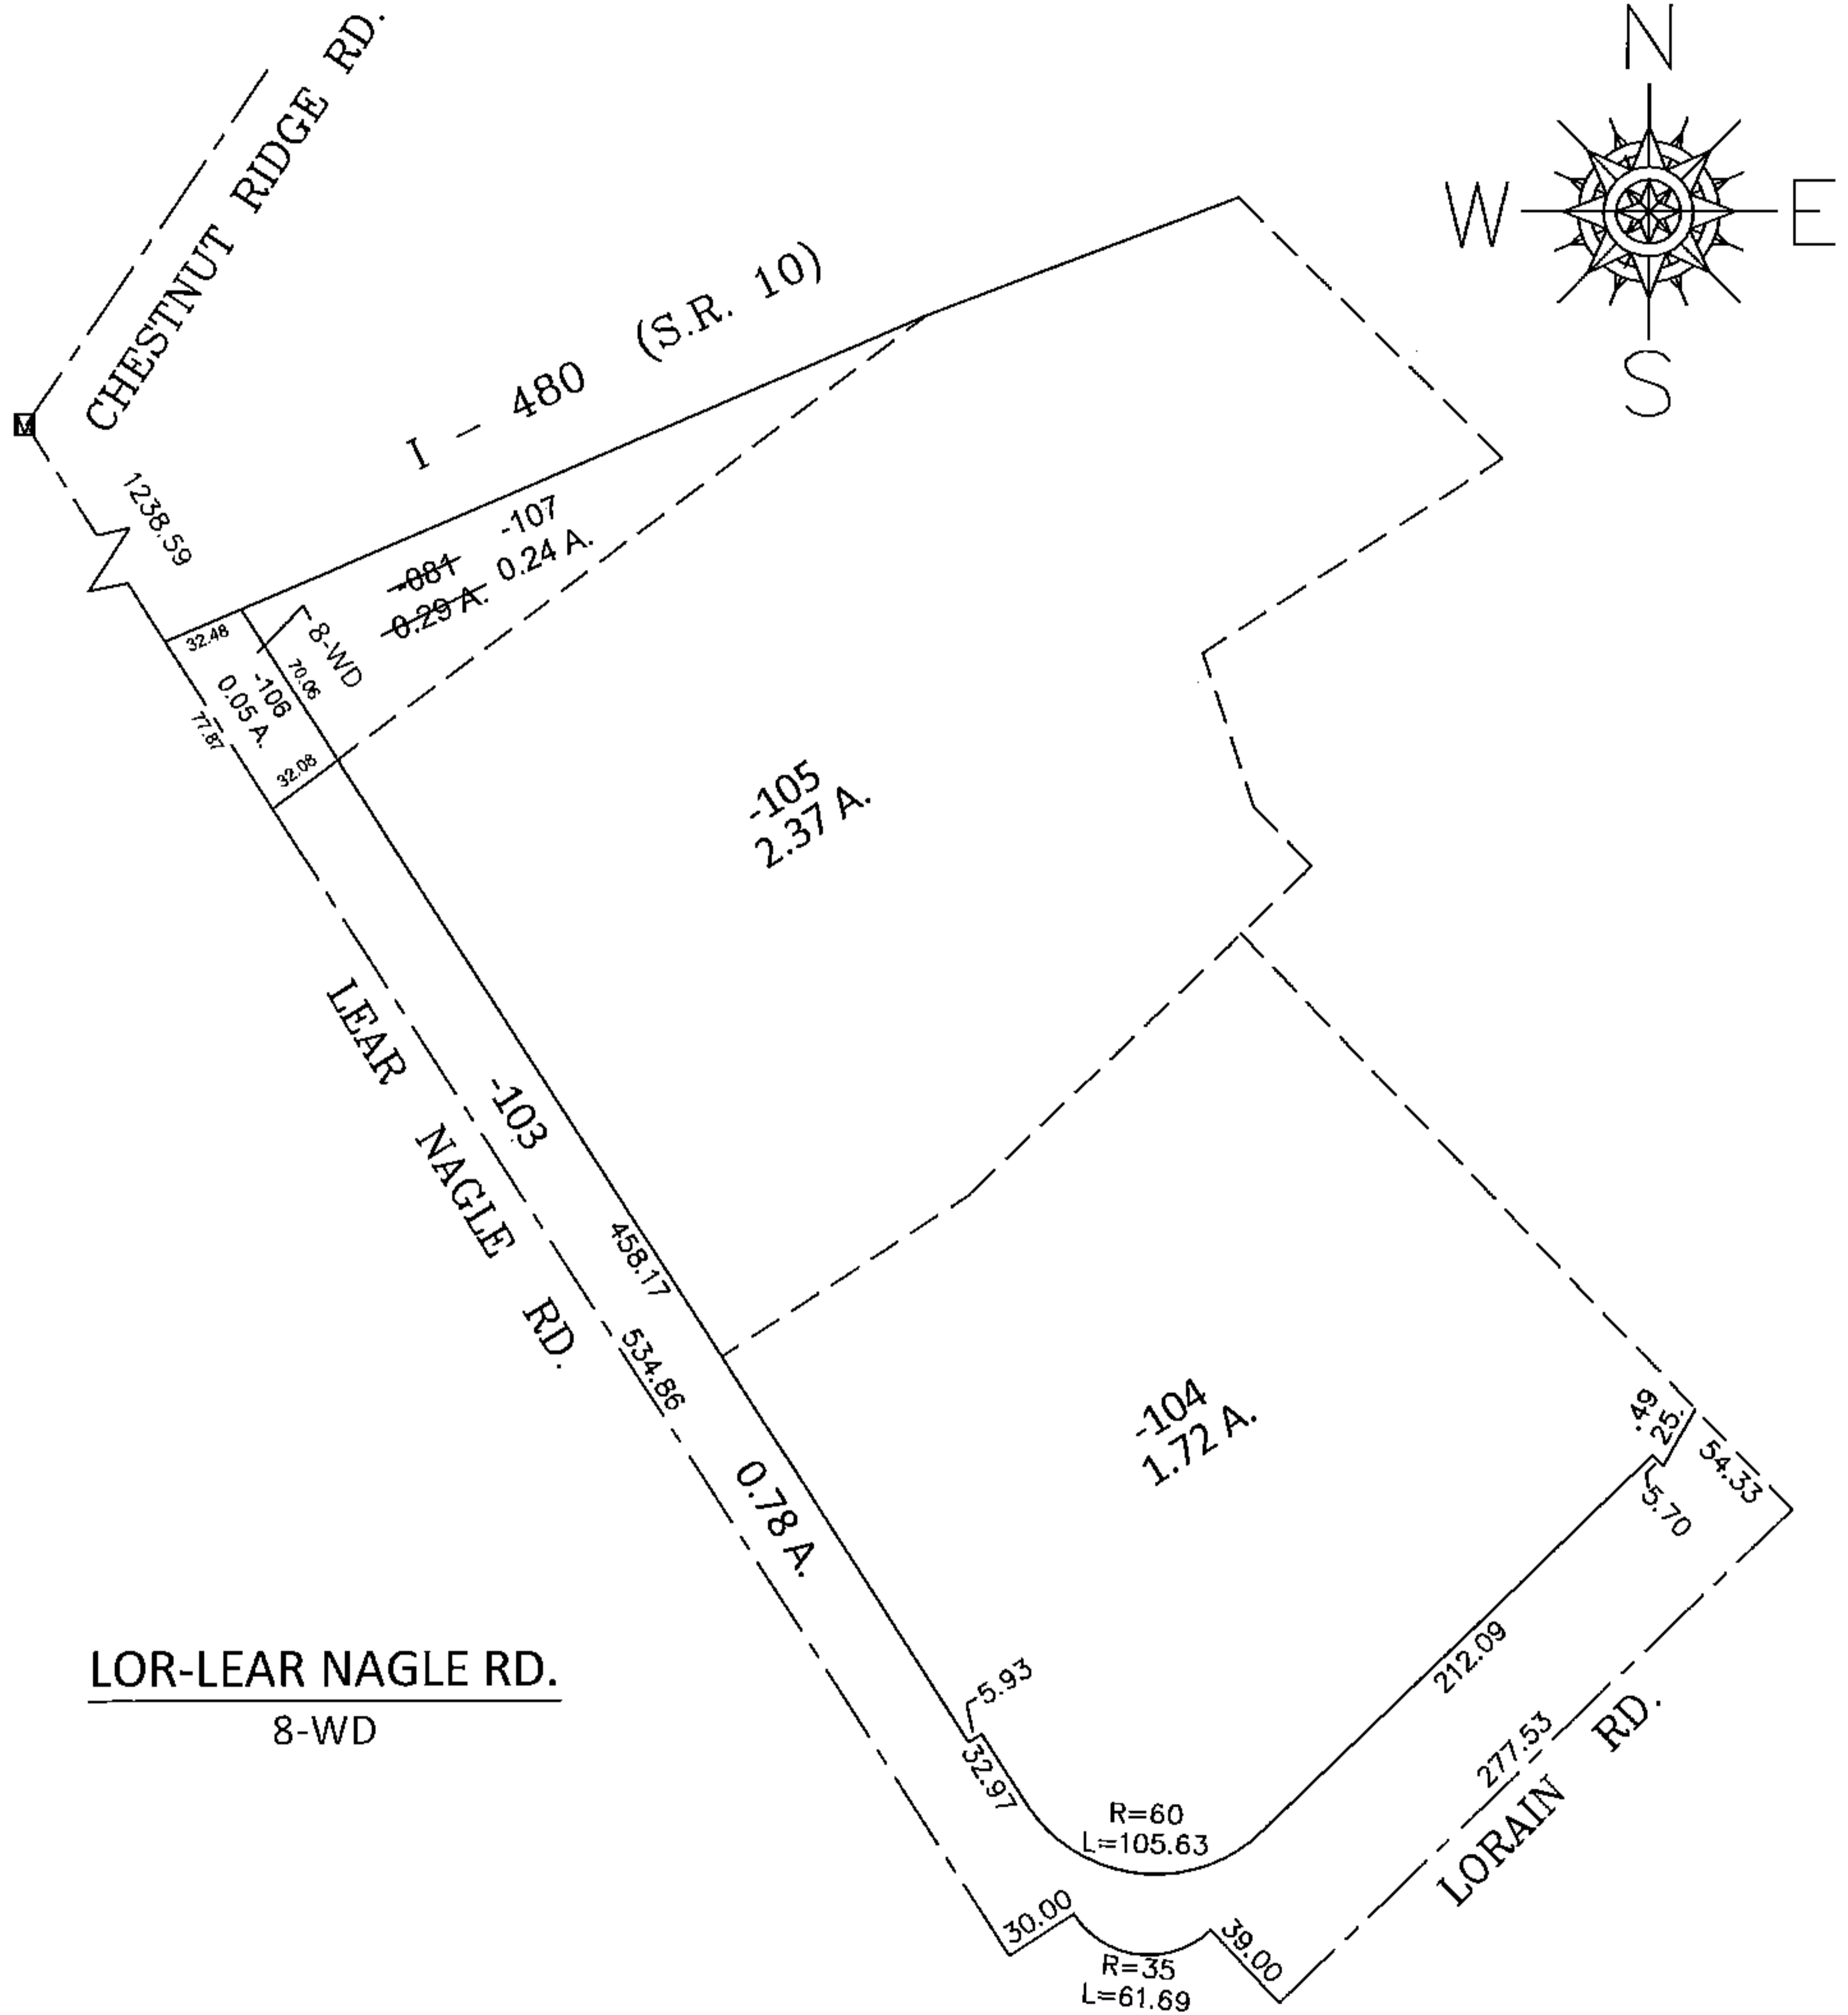

LOR-LEAR NAGLE RD.
8-WD

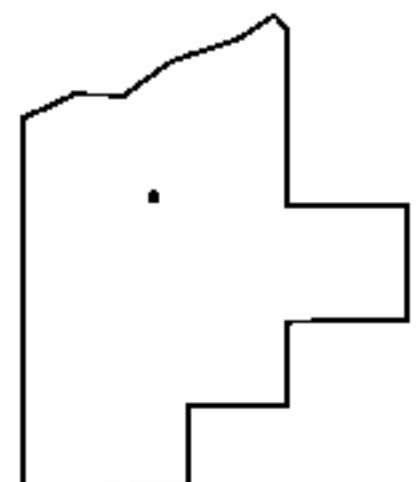

SPLITS/DEEDS PROCESSED

LORAIN COUNTY TAX MAP DEPARTMENT
226 MIDDLE AVE. ELYRIA, OHIO

SURVEYED BY: ROBERT G. HOY

CLOSURE: .00:10,000

MAP PAGE(S): 7-00-004-C

APPROVED BY: TJS DATE: 9-10-14

SCALE: 1"= 100 PRIOR INST.: 19980510646