
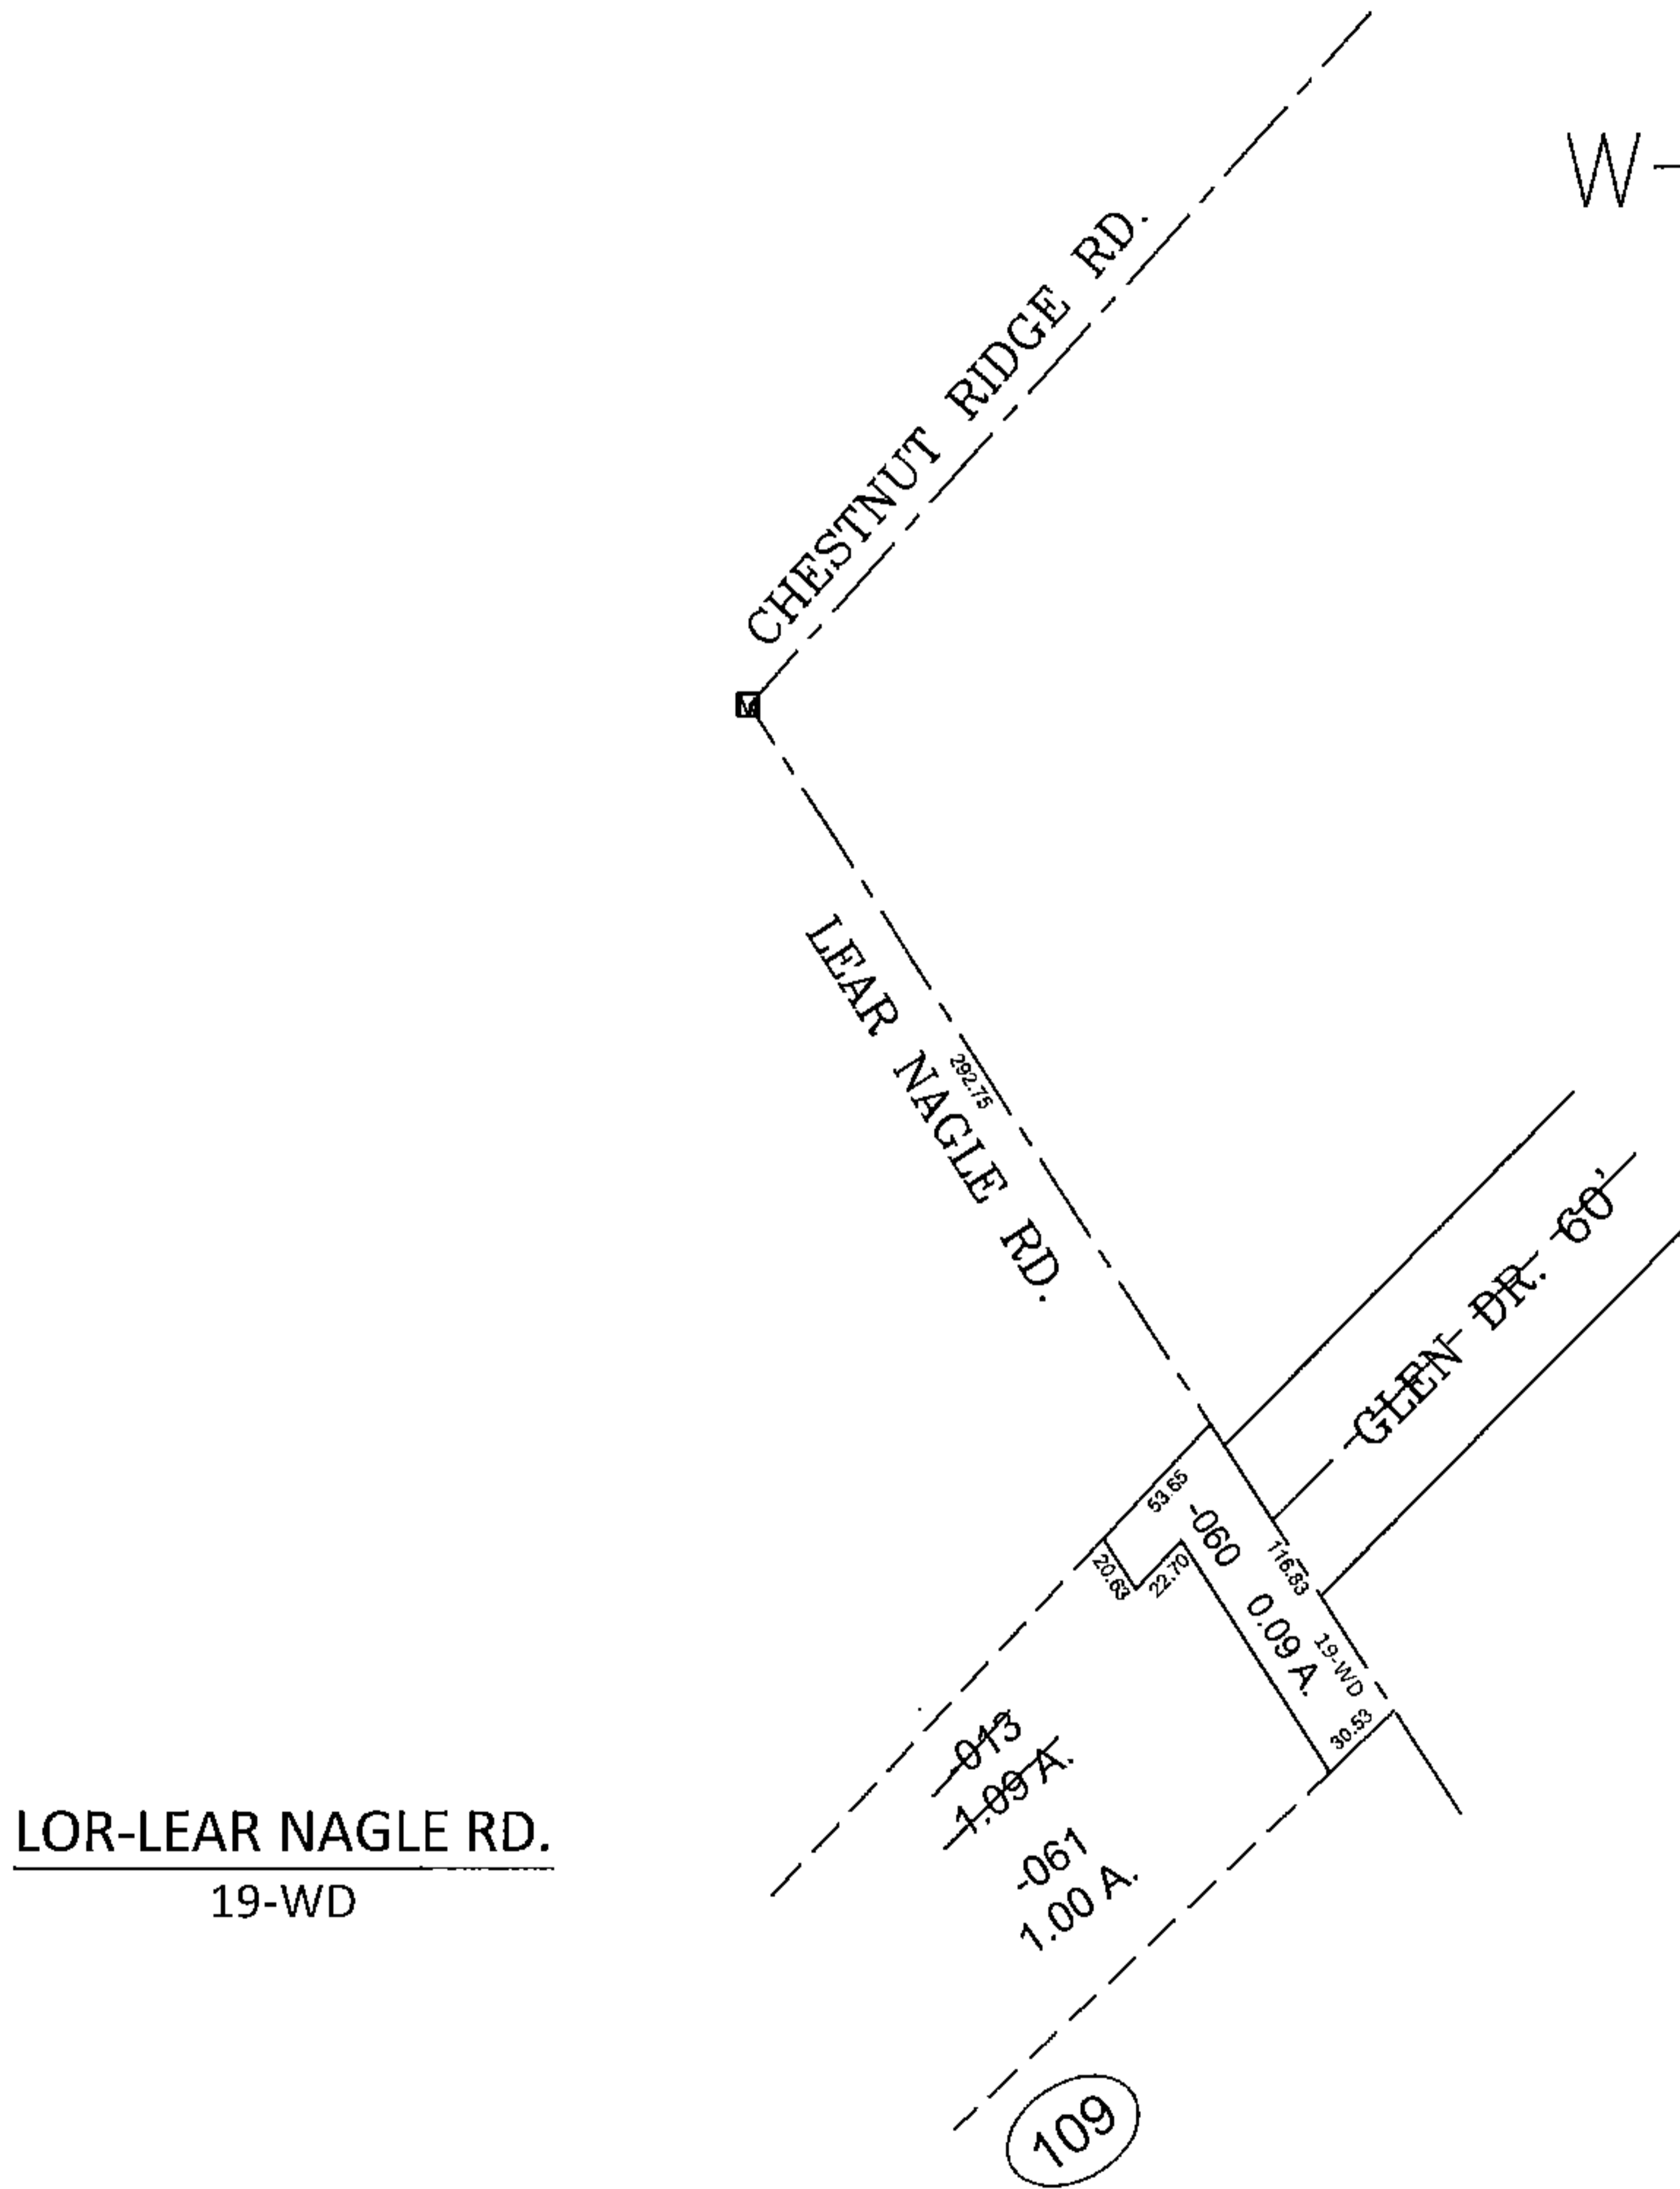


PARENT PARCEL: 07-00-004-109-013


CHILD PARCEL: 07-00-004-109-060 & -061

14-00681

STARTING POINT: AT A MON BOX AT THE INTERSECTION OF C/L OF CHESTNUT RIDGE RD. AND C/L OF LEAR NAGLE RD.

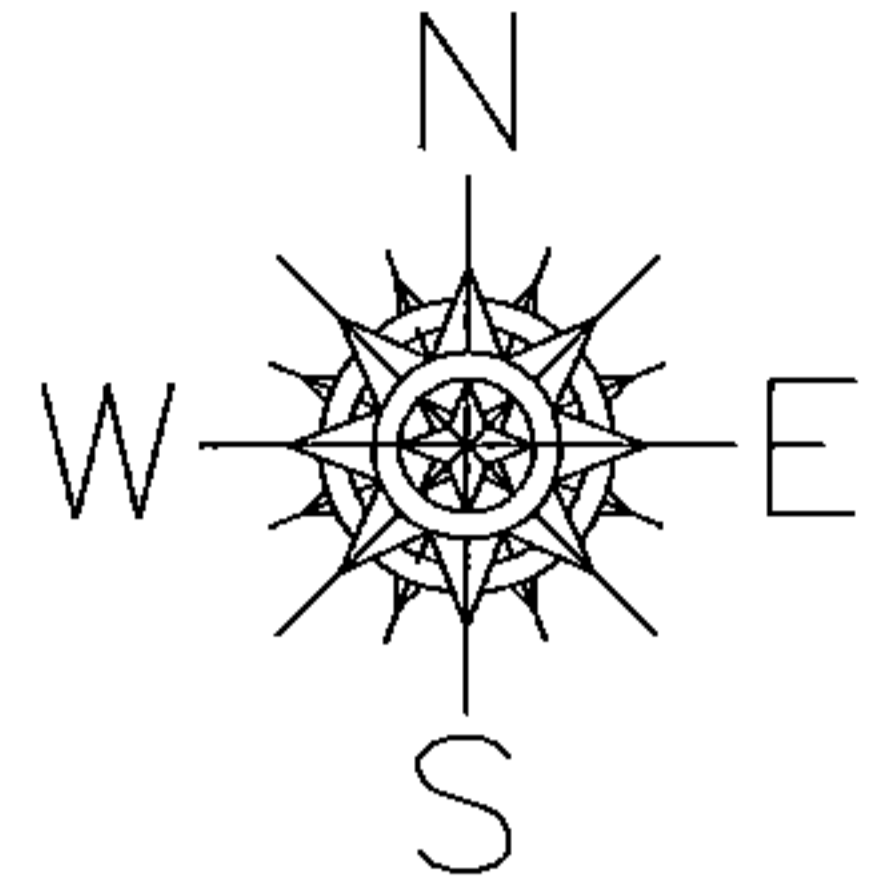

LOR-LEAR NAGLE RD.  
19-WD

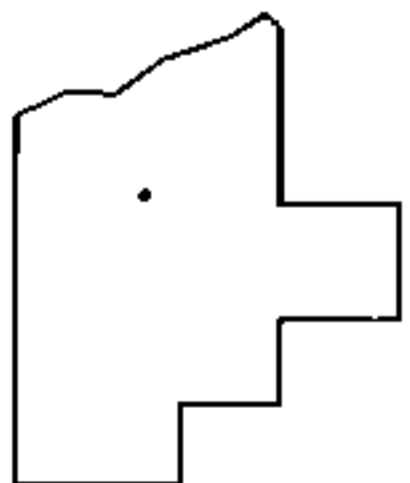

**SPLITS/DEEDS PROCESSED**

LORAIN COUNTY TAX MAP DEPARTMENT  
226 MIDDLE AVE. ELYRIA, OHIO

SURVEYED BY:	ROBERT G. HOY
CLOSURE:	.00:10,000
MAP PAGE(S):	7-00-004-C
APPROVED BY:	TJS
DATE:	9-11-14
SCALE:	1"= 100
PRIOR INST.:	20050086219