
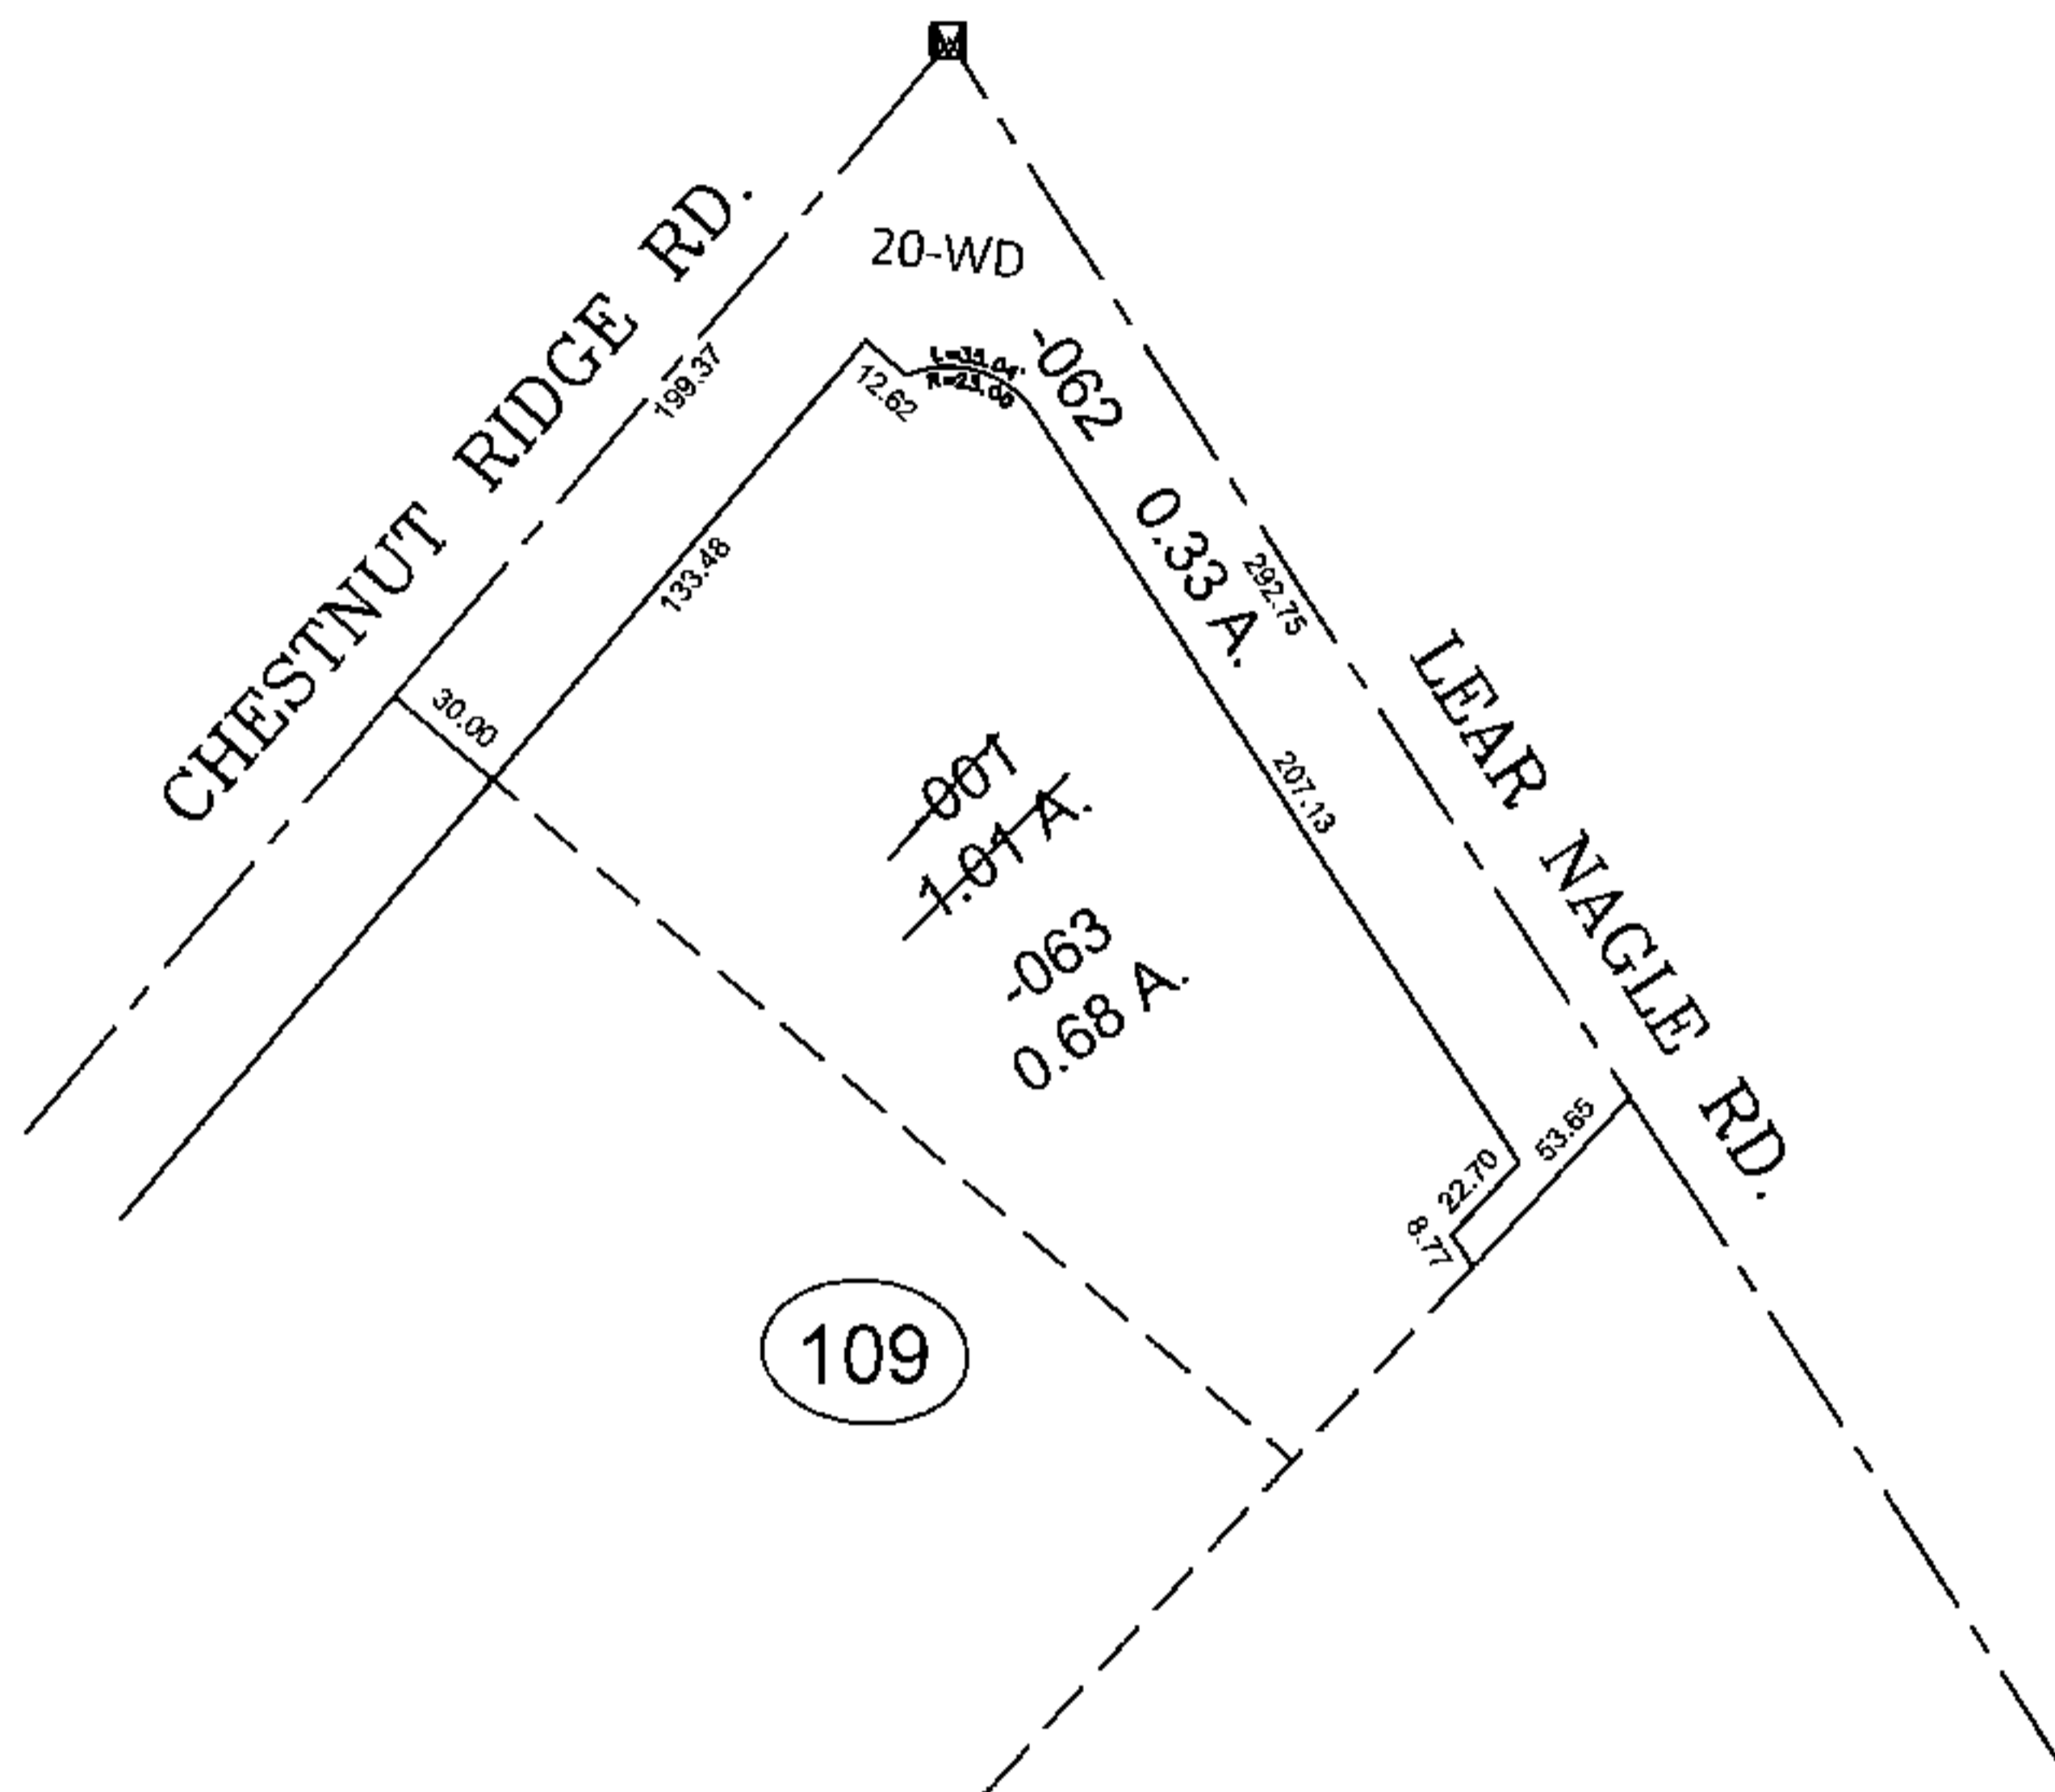


PARENT PARCEL: 07-00-004-109-001

CHILD PARCEL: 07-00-004-109-062 & -063


STARTING POINT: AT A MON BOX AT THE INTERSECTION OF C/L OF CHESTNUT RIDGE RD. AND C/L OF LEAR NAGLE RD.

14-00682

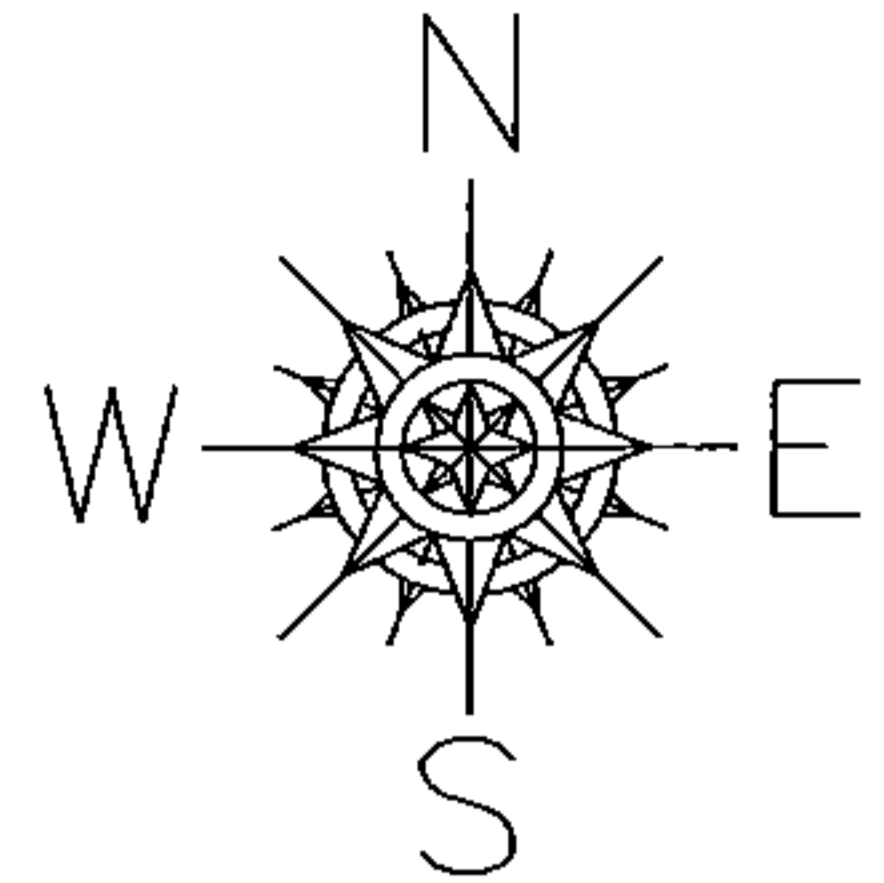

LOR-LEAR NAGLE RD.

20-WD

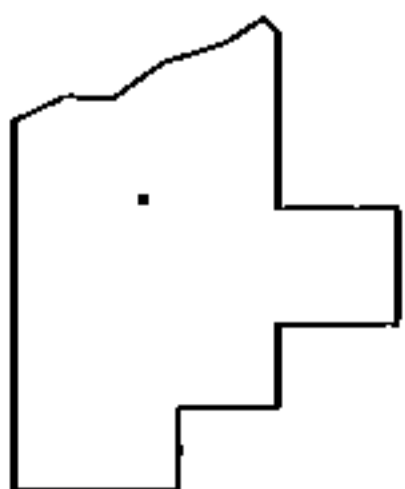

SPLITS/DEEDS PROCESSED

LORAIN COUNTY TAX MAP DEPARTMENT
226 MIDDLE AVE. ELYRIA, OHIO

SURVEYED BY: ROBERT G. HOY

CLOSURE: .00:10,000

MAP PAGE(S): 7-00-004-C

APPROVED BY: TJS DATE: 9-12-14

SCALE: 1"= 100 PRIOR INST.: OR 693/289