
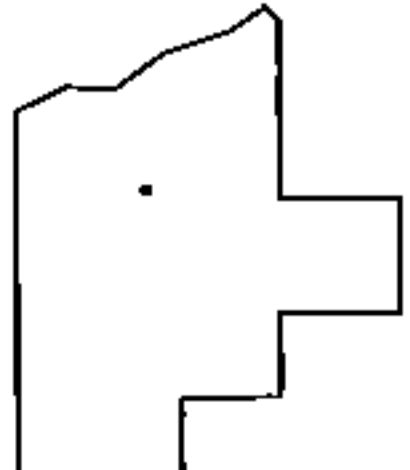
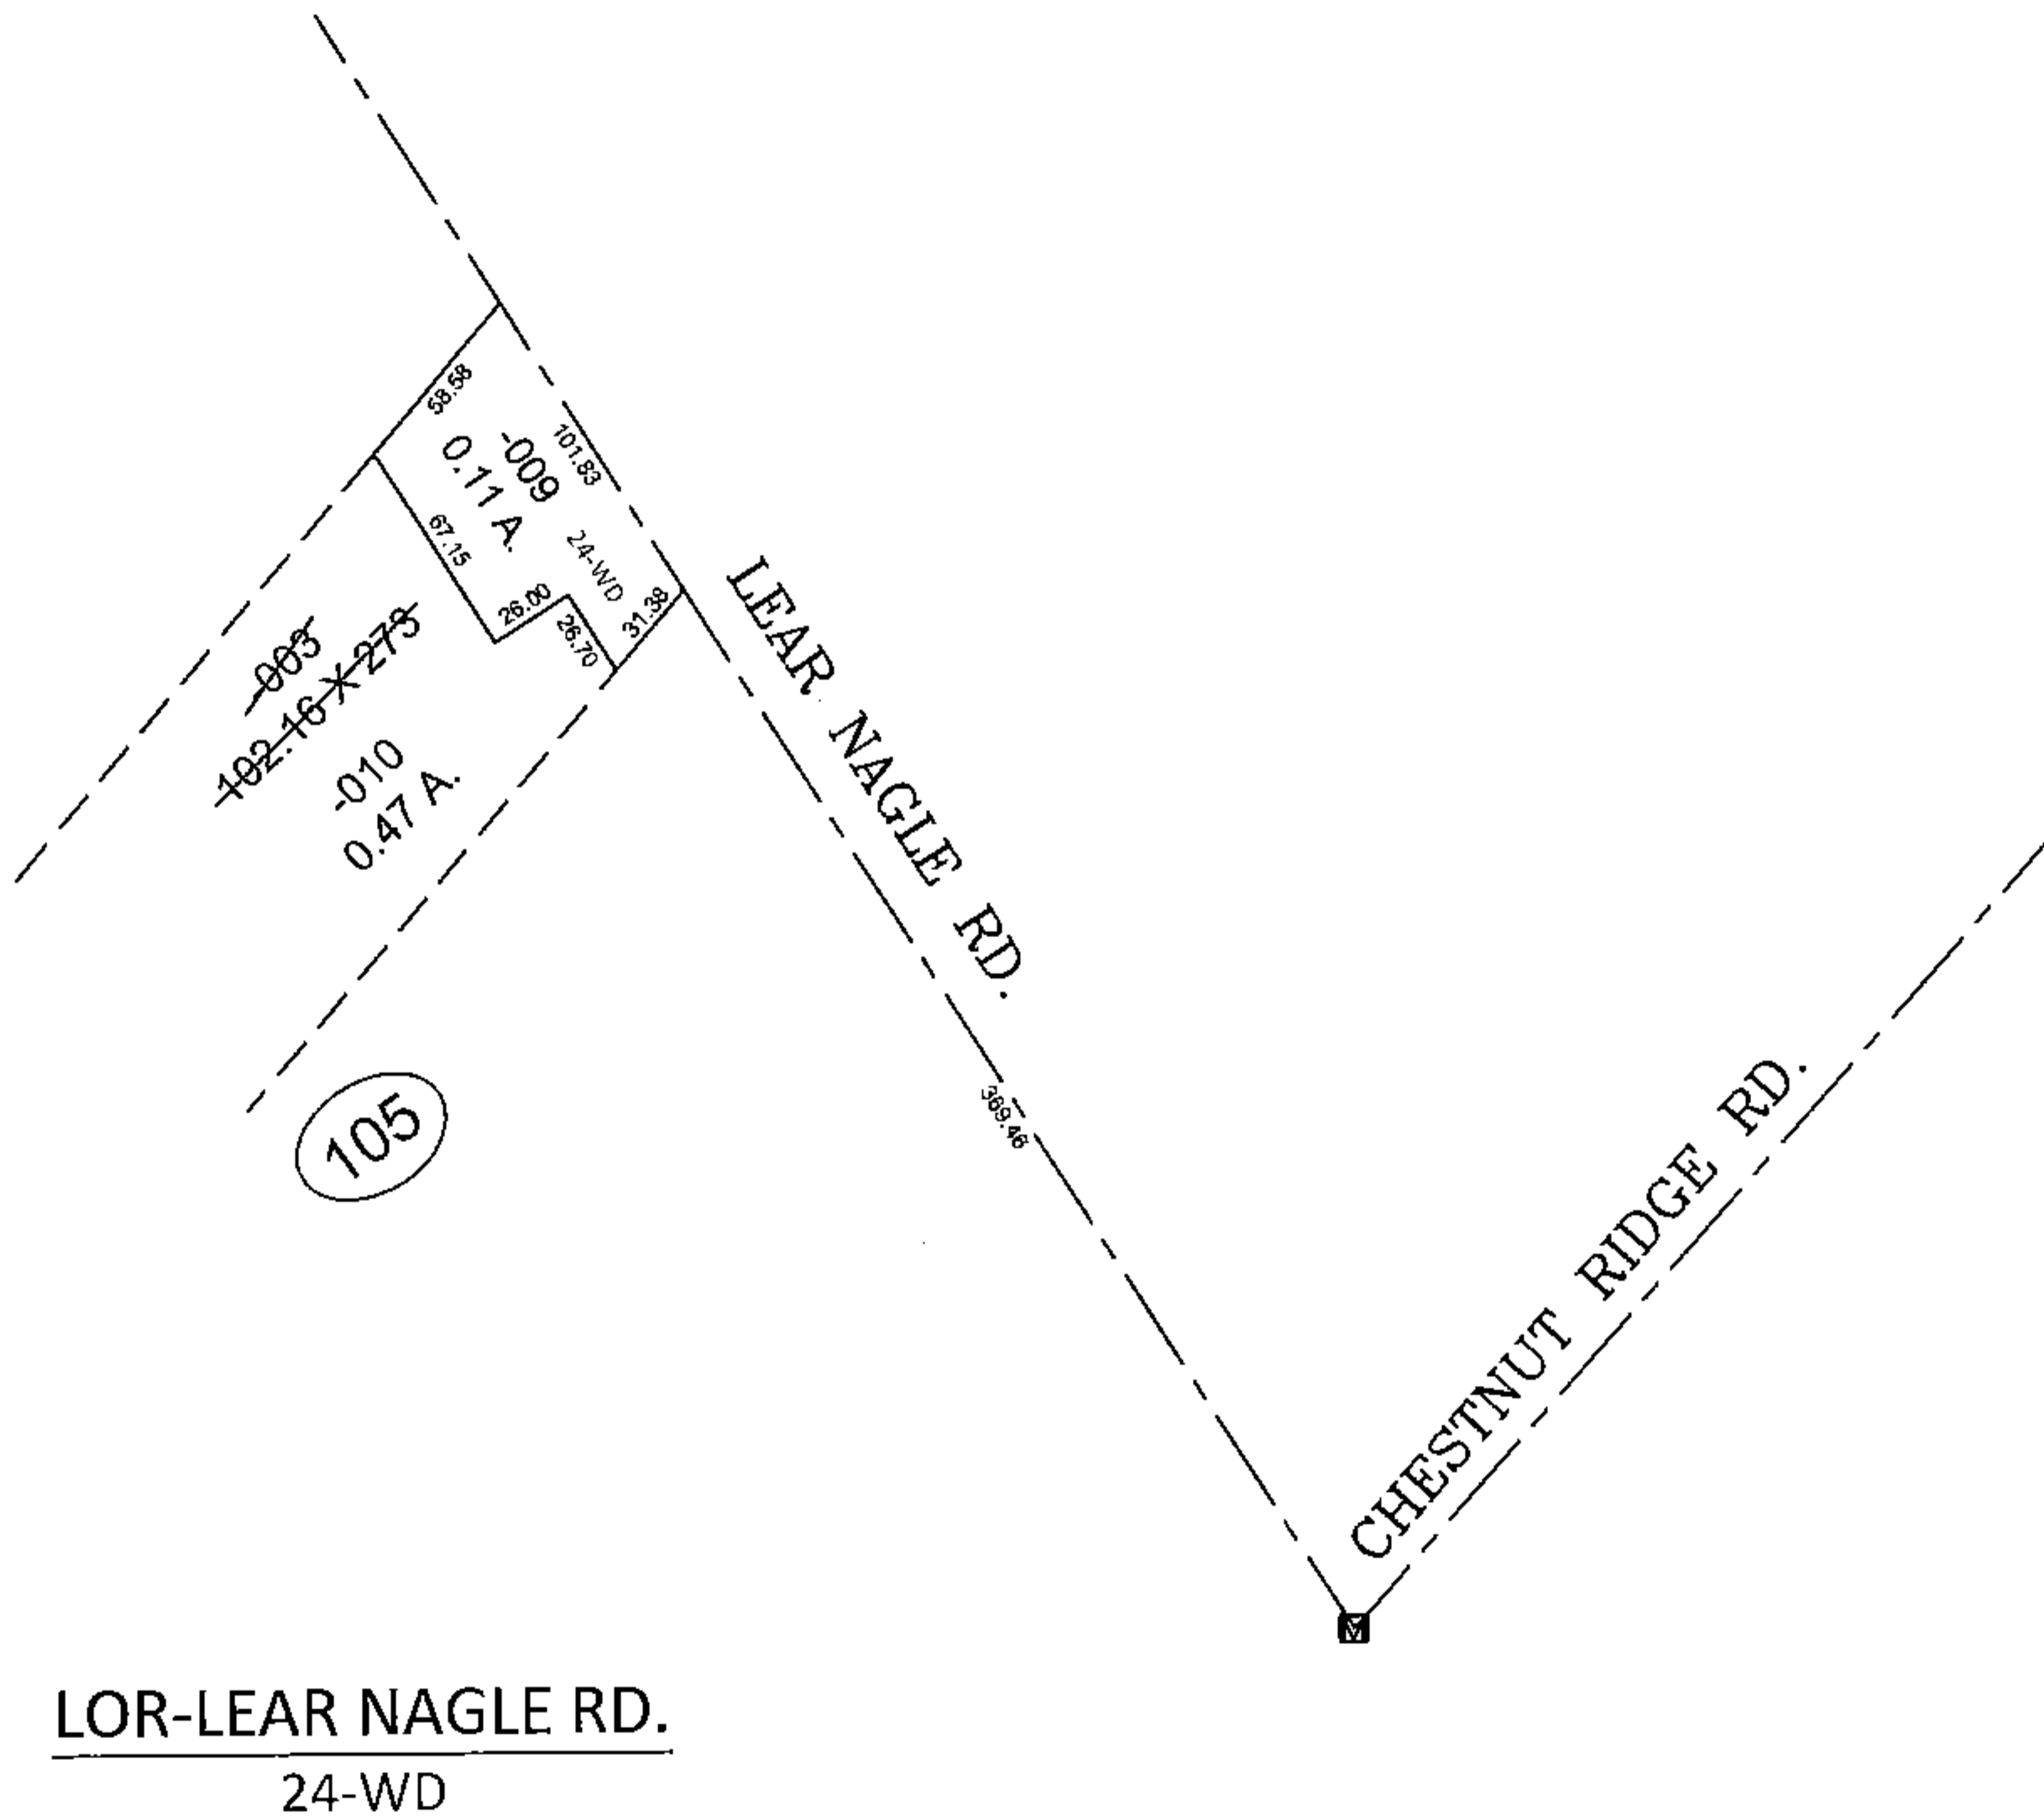


PARENT PARCEL: 07-00-004-105-003
CHILD PARCEL: 07-00-004-105-009 & -010
STARTING POINT: AT A MON BOX AT THE INTERSECTION OF C/L OF CHESTNUT RIDGE RD. AND C/L OF LEAR NAGLE RD.

14-00683

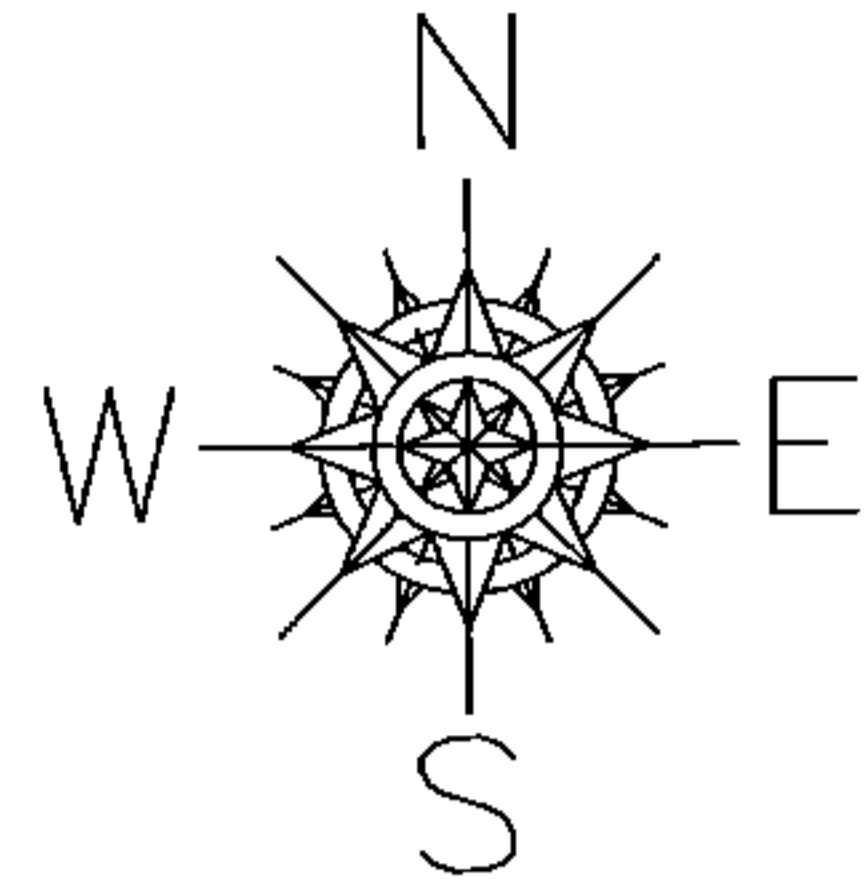

SPLITS/DEEDS PROCESSED
LORAIN COUNTY TAX MAP DEPARTMENT
226 MIDDLE AVE. ELYRIA, OHIO

SURVEYED BY: ROBERT G. HOY
CLOSURE: .00:10,000
MAP PAGE(S): 7-00-004-C
APPROVED BY: TJS DATE: 9-12-14
SCALE: 1"= 100 PRIOR INST.: DV 1172/30