
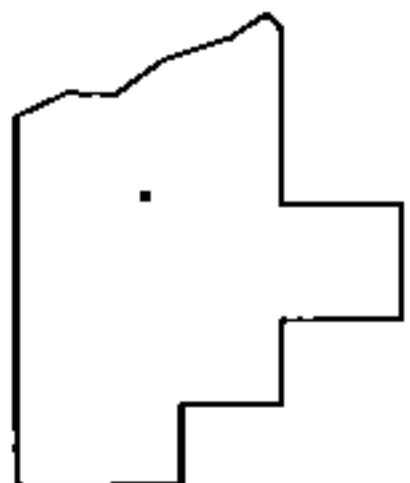
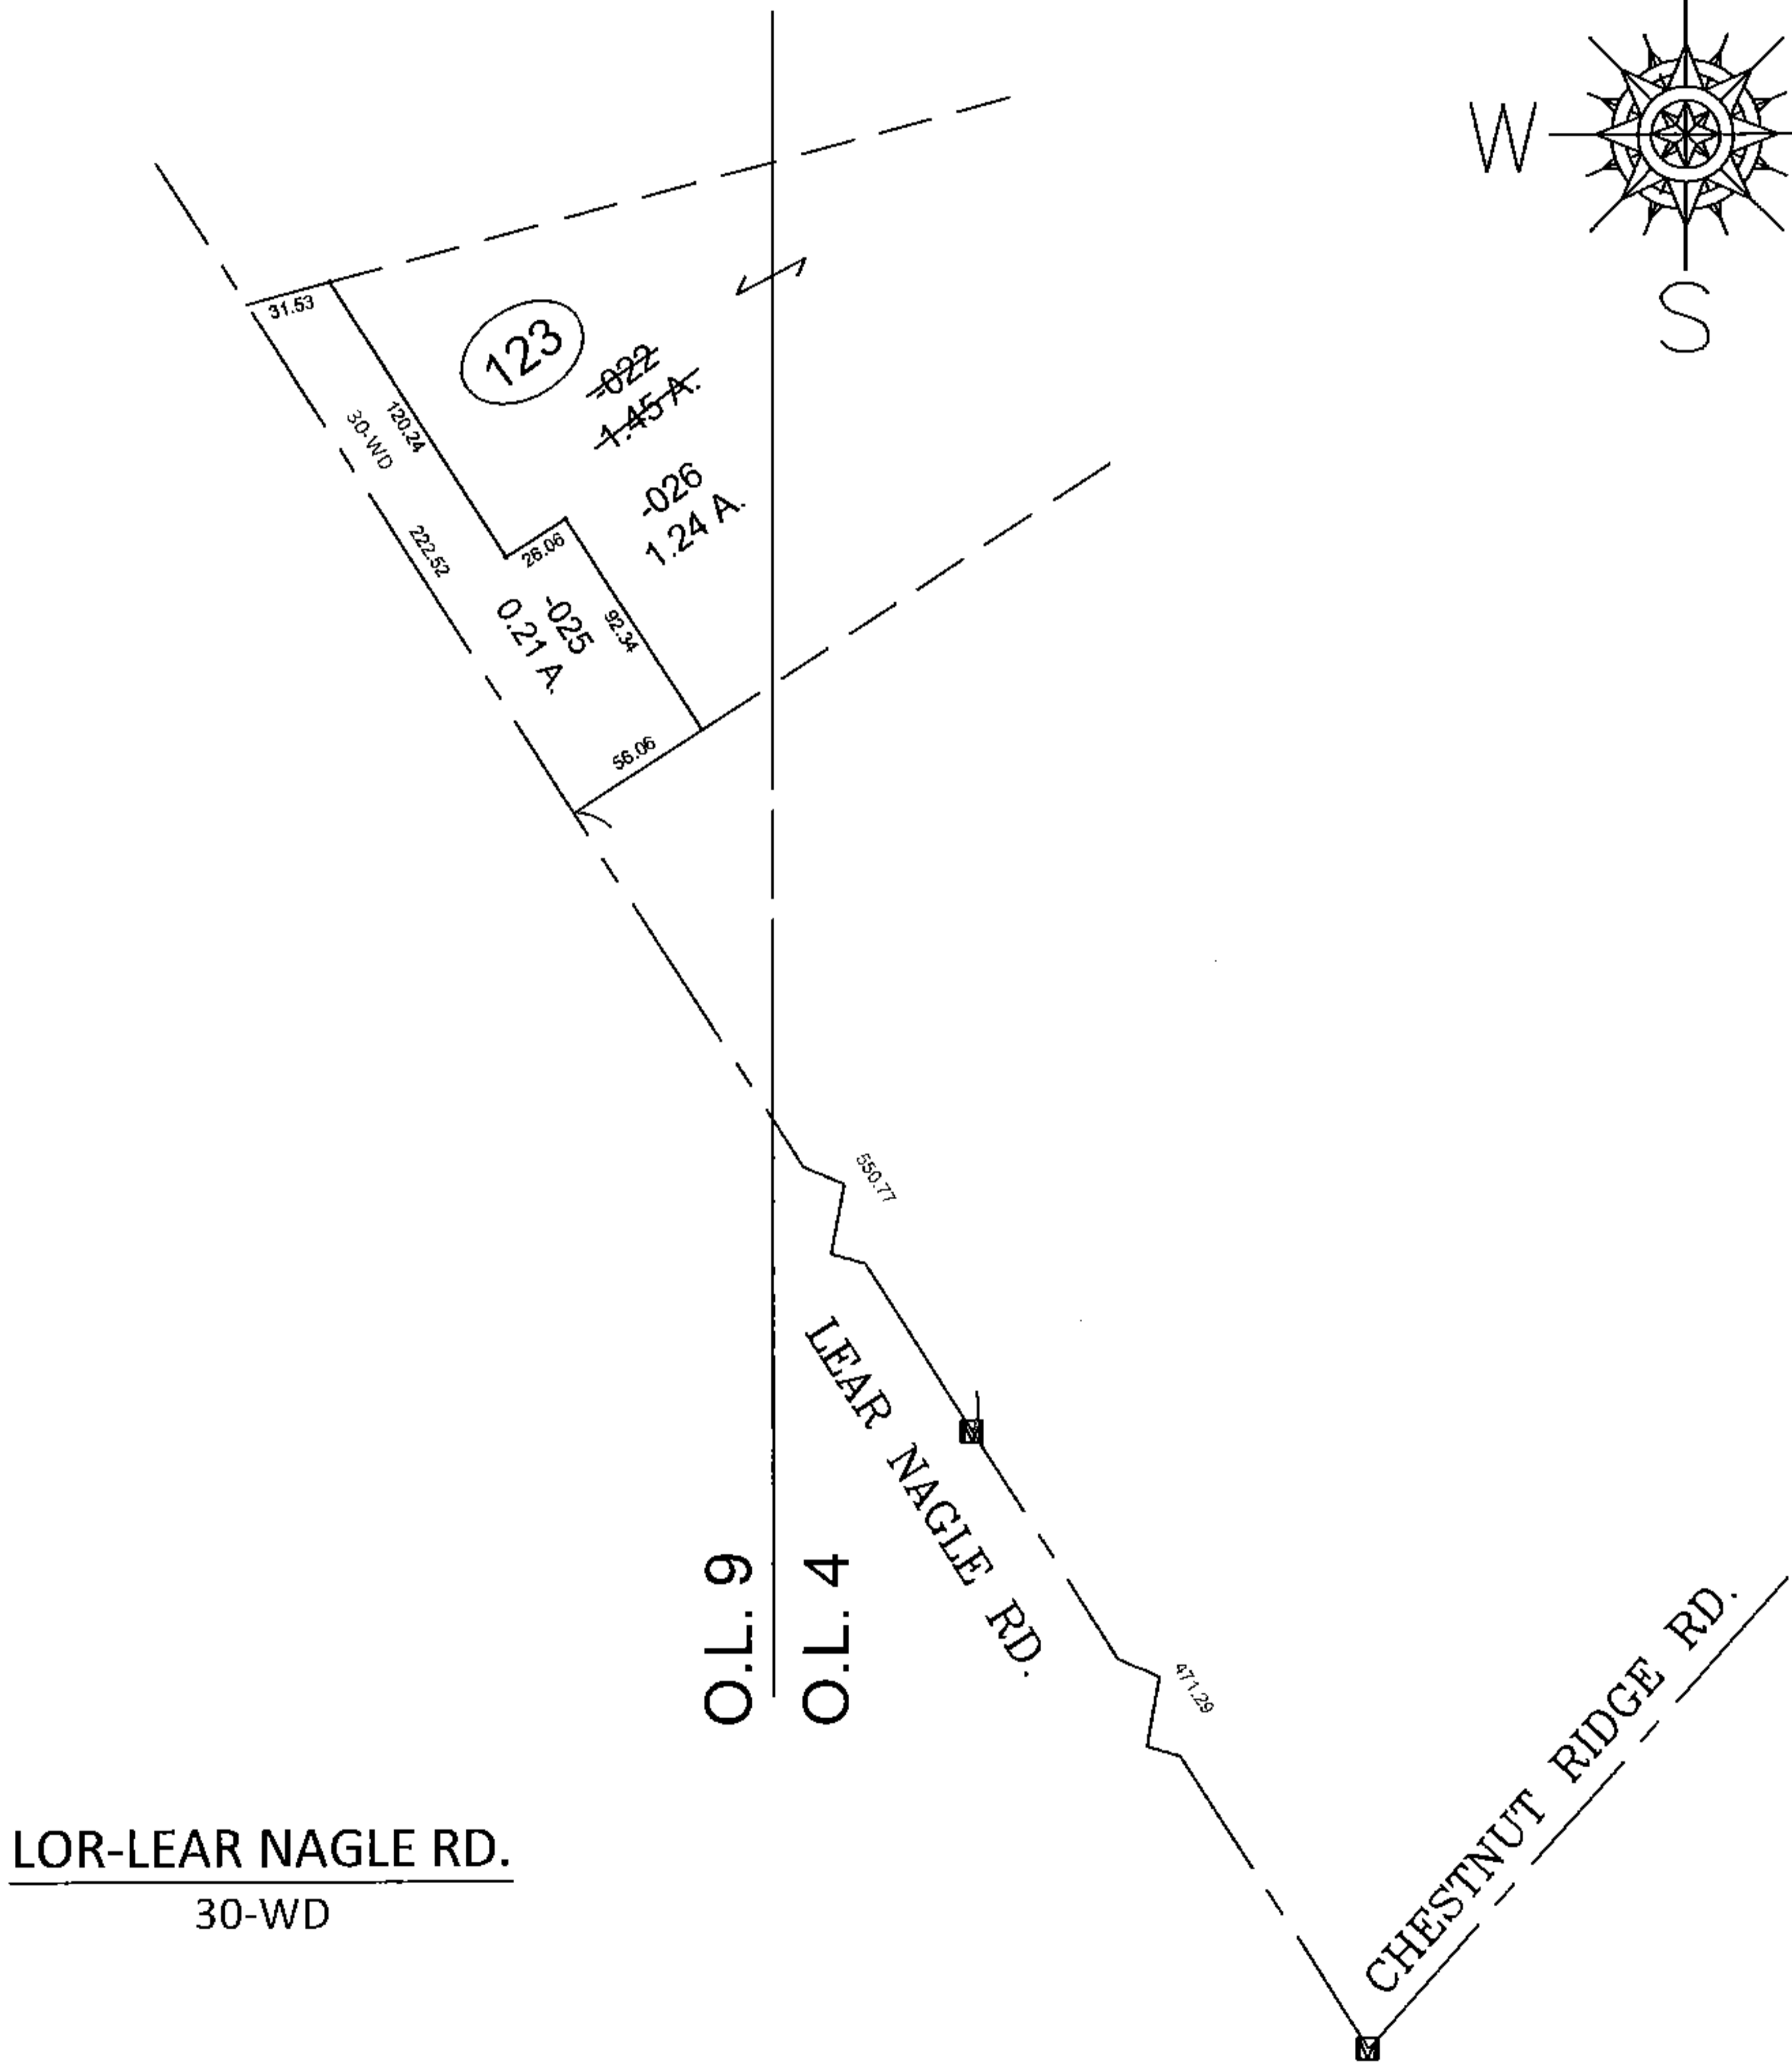


PARENT PARCEL: 07-00-009-123-022

CHILD PARCEL: 07-00-009-123-025 & -026

STARTING POINT: AT A MON BOX AT THE INTERSECTION OF C/L OF CHESTNUT RIDGE RD. AND C/L OF LEAR NAGLE RD.

14-00686

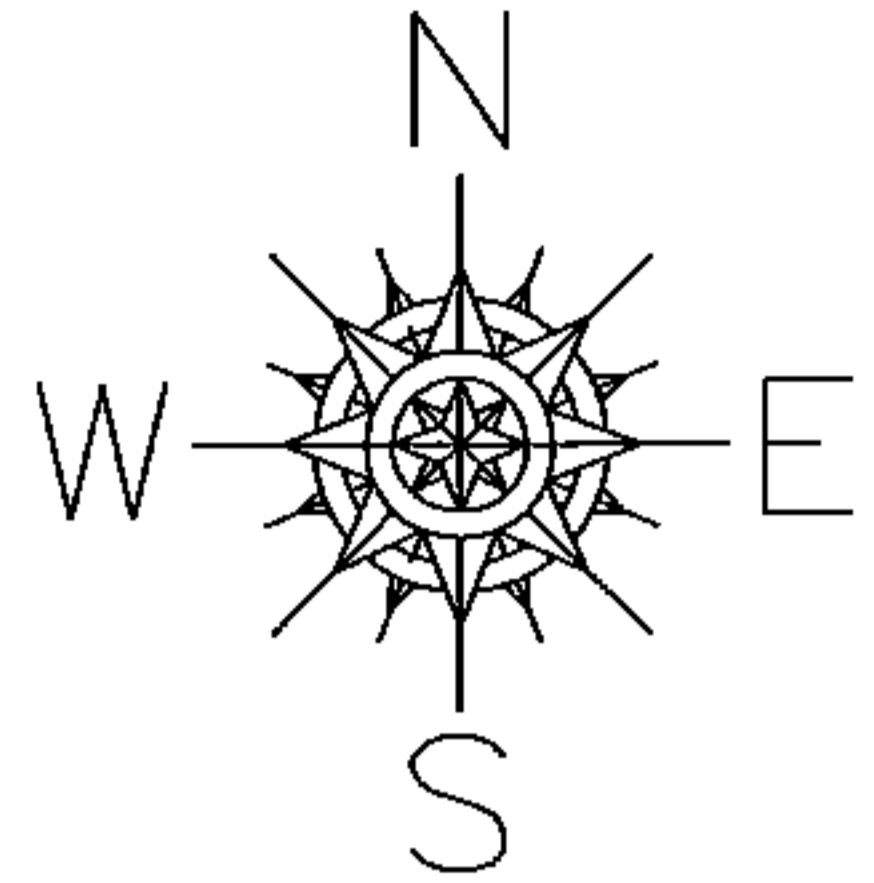

SPLITS/DEEDS PROCESSED

LORAIN COUNTY TAX MAP DEPARTMENT  
226 MIDDLE AVE. ELYRIA, OHIO

SURVEYED BY: ROBERT G. HOY

CLOSURE: .00:10,000

MAP PAGE(S): 7-00-009-B

APPROVED BY: TJS DATE: 9/19/14

SCALE: 1"=100 PRIOR INST.: 19990608854