
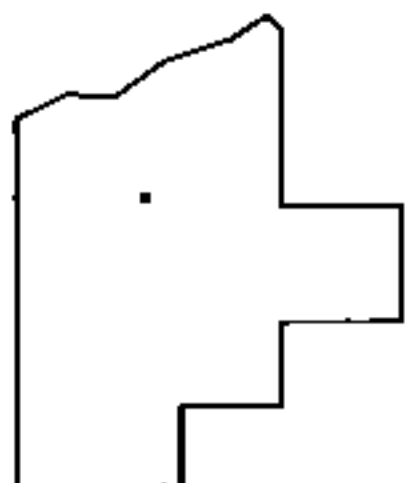
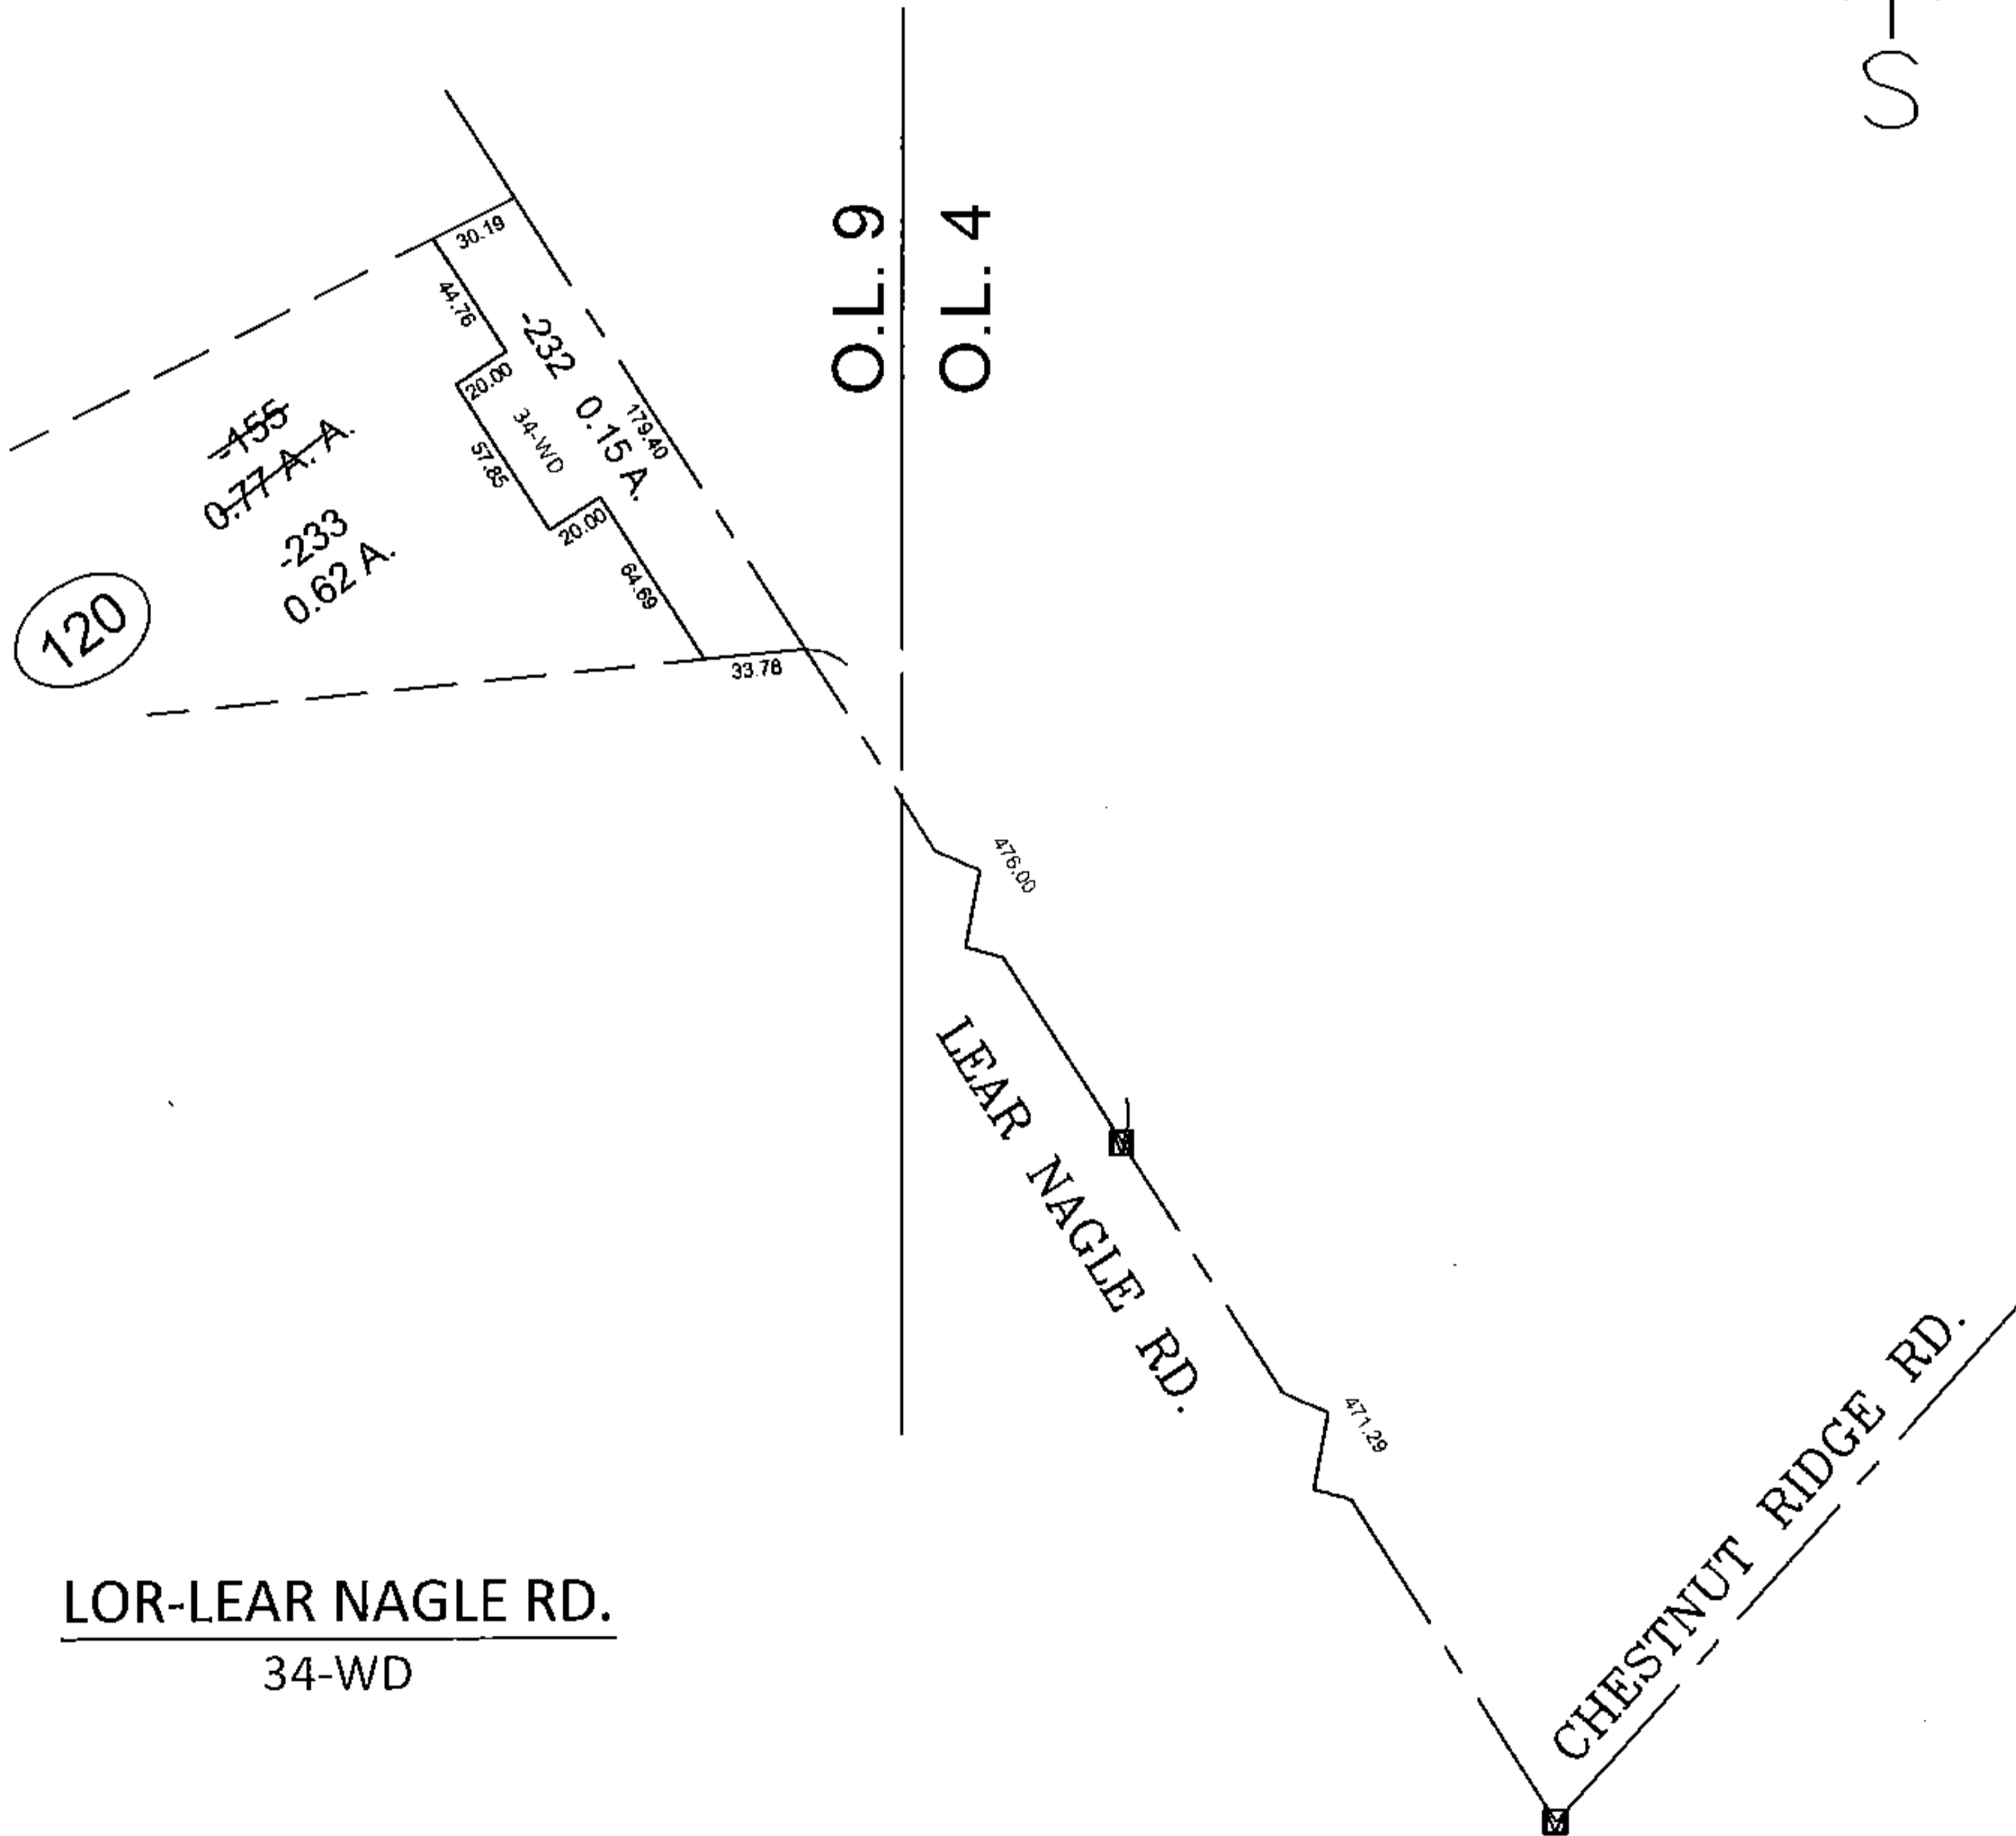


PARENT PARCEL: 07-00-009-120-155

CHILD PARCEL: 07-00-009-120-232 & -233

STARTING POINT: AT A MON BOX AT THE INTERSECTION OF C/L OF CHESTNUT RIDGE RD. AND C/L OF LEAR NAGLE RD.

14-00687

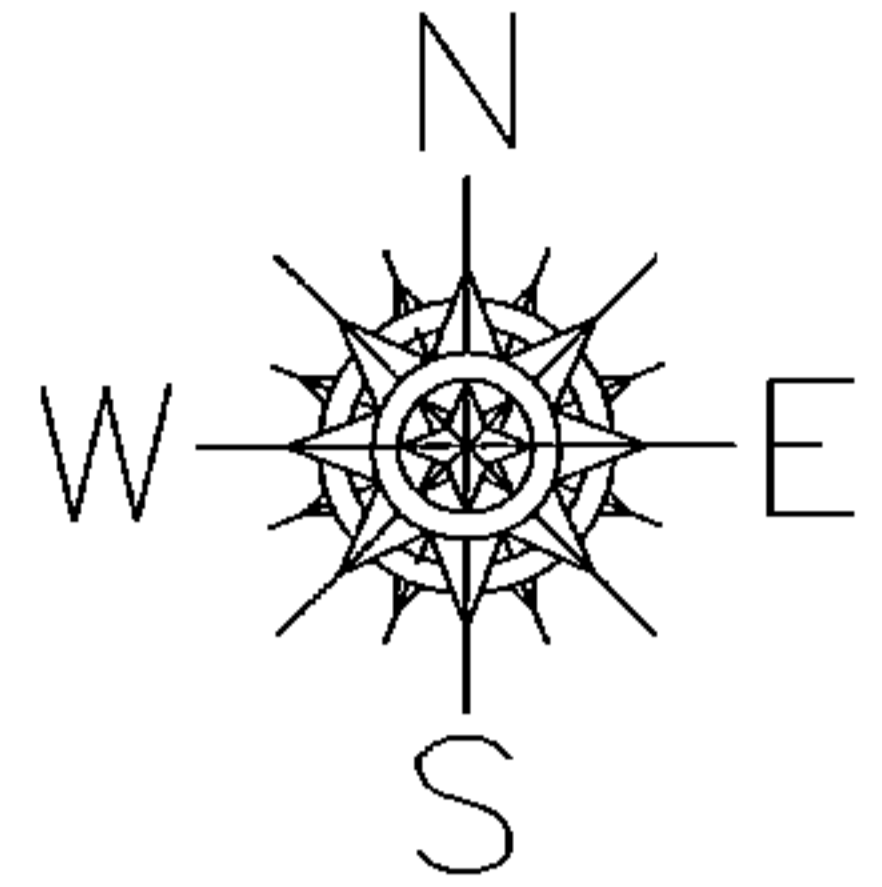

SPLITS/DEEDS PROCESSED

LORAIN COUNTY TAX MAP DEPARTMENT
226 MIDDLE AVE. ELYRIA, OHIO

SURVEYED BY: ROBERT G. HOY

CLOSURE: .00:10,000

MAP PAGE(S): 7-00-004-C

APPROVED BY: TJS DATE: 9/19/14

SCALE: 1"= 100 PRIOR INST.: DV 1408/520