
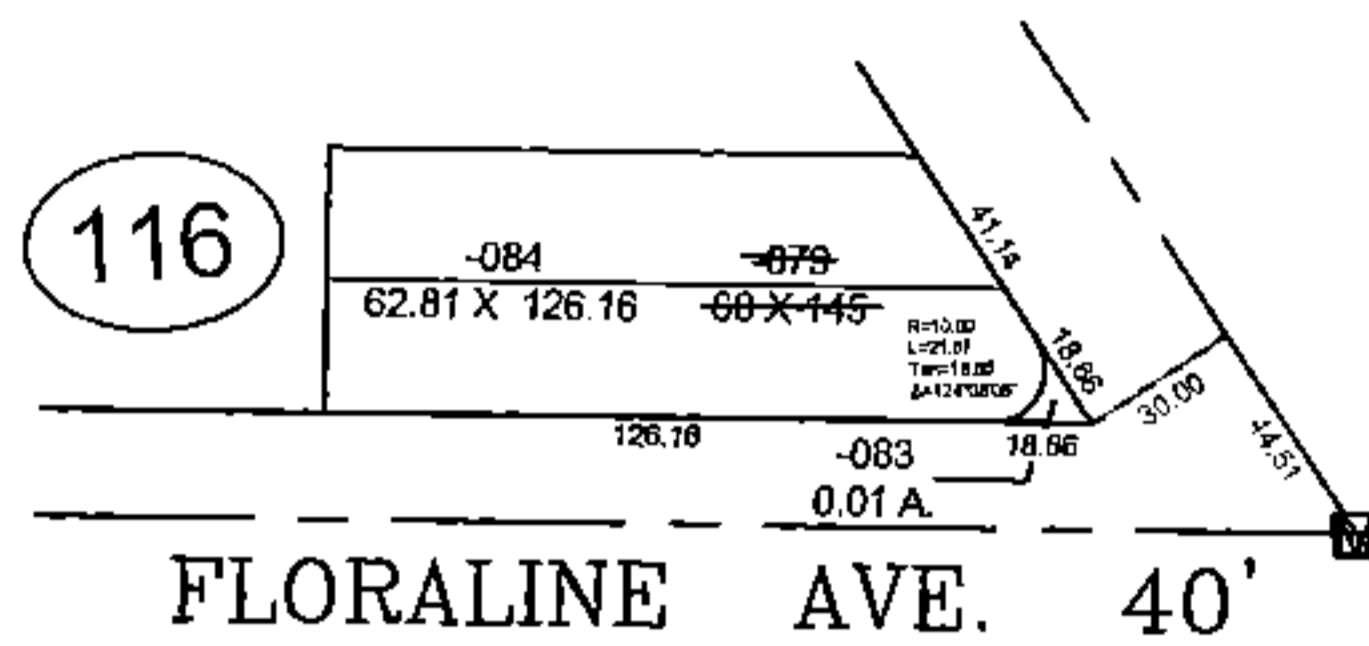


PARENT PARCEL: 07-00-009-116-079

CHILD PARCEL: 07-00-009-116-083 & -084

14-00688

STARTING POINT: AT A MON BOX AT THE INTERSECTION OF C/L OF CHESTNUT RIDGE RD. AND C/L OF LEAR NAGLE RD.

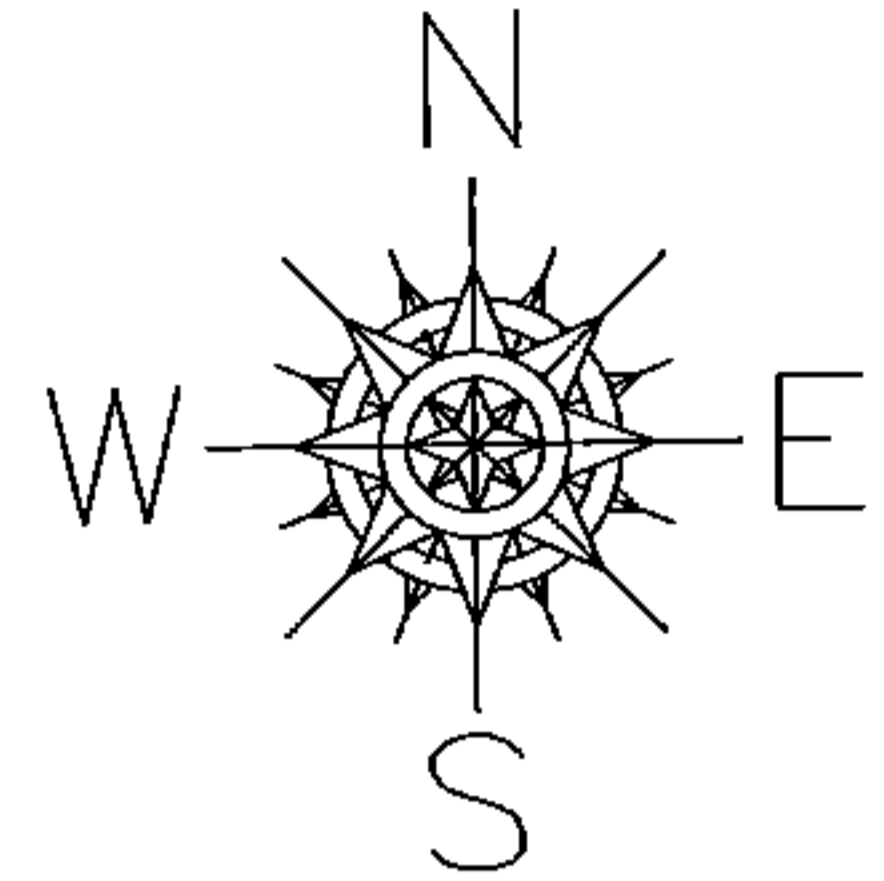


O.L. 9

O.L. 4

LEAR NAGLE RD.

CHESTNUT RIDGE RD.

LOR-LEAR NAGLE RD.
47-WD

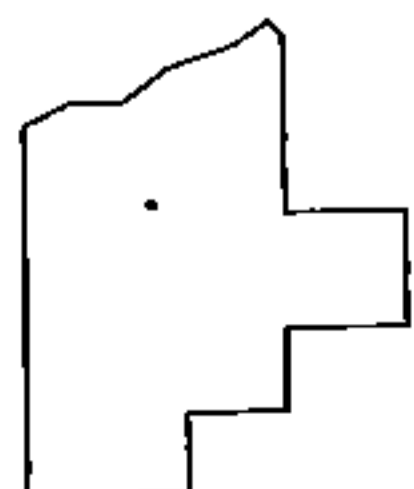

SPLITS/DEEDS PROCESSED

LORAIN COUNTY TAX MAP DEPARTMENT
226 MIDDLE AVE. ELYRIA, OHIO

SURVEYED BY: ROBERT G. HOY

CLOSURE: .00:10,000

MAP PAGE(S): 7-00-009-B

APPROVED BY: TJS DATE: 9/23/14

SCALE: 1"= 100 PRIOR INST.: DV 1250/765