
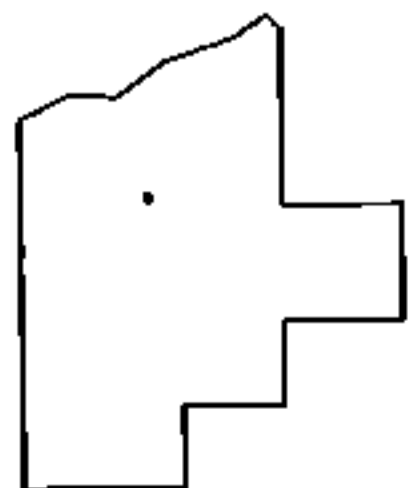
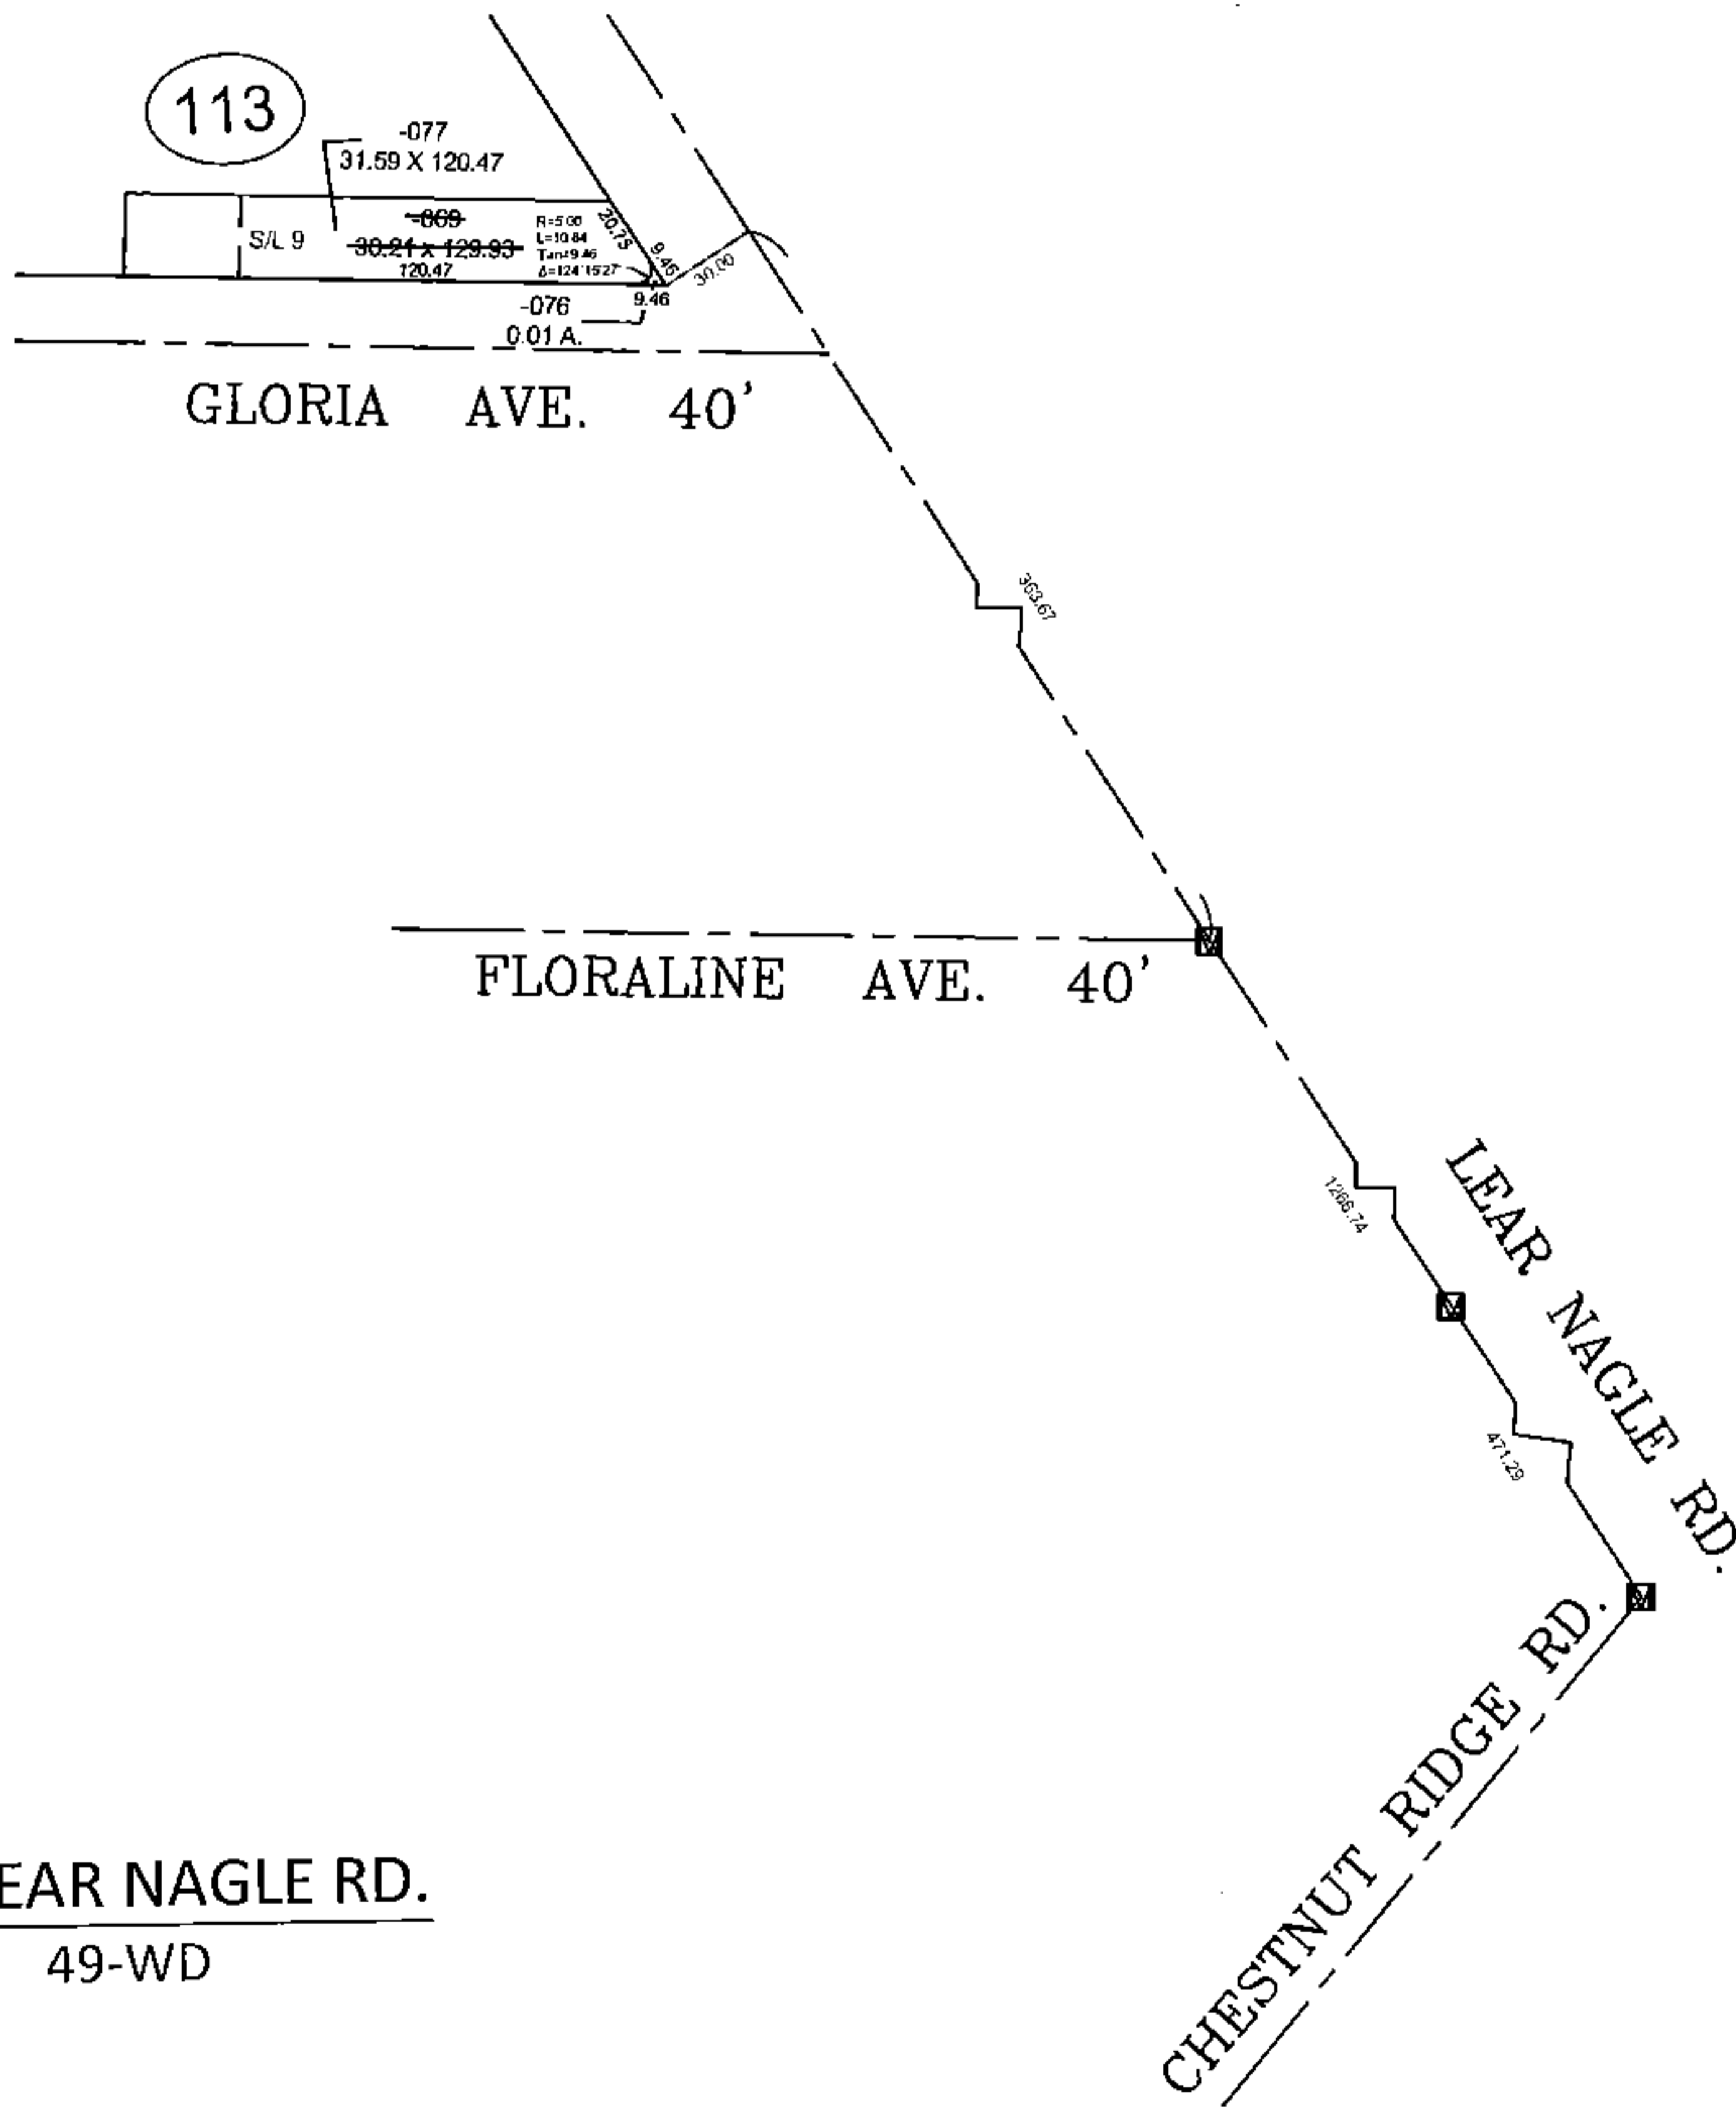


PARENT PARCEL: 07-00-009-113-069

CHILD PARCEL: 07-00-009-113-076 & -077

14-00689

STARTING POINT: AT A MON BOX AT THE INTERSECTION OF C/L OF CHESTNUT RIDGE RD. AND C/L OF LEAR NAGLE RD.

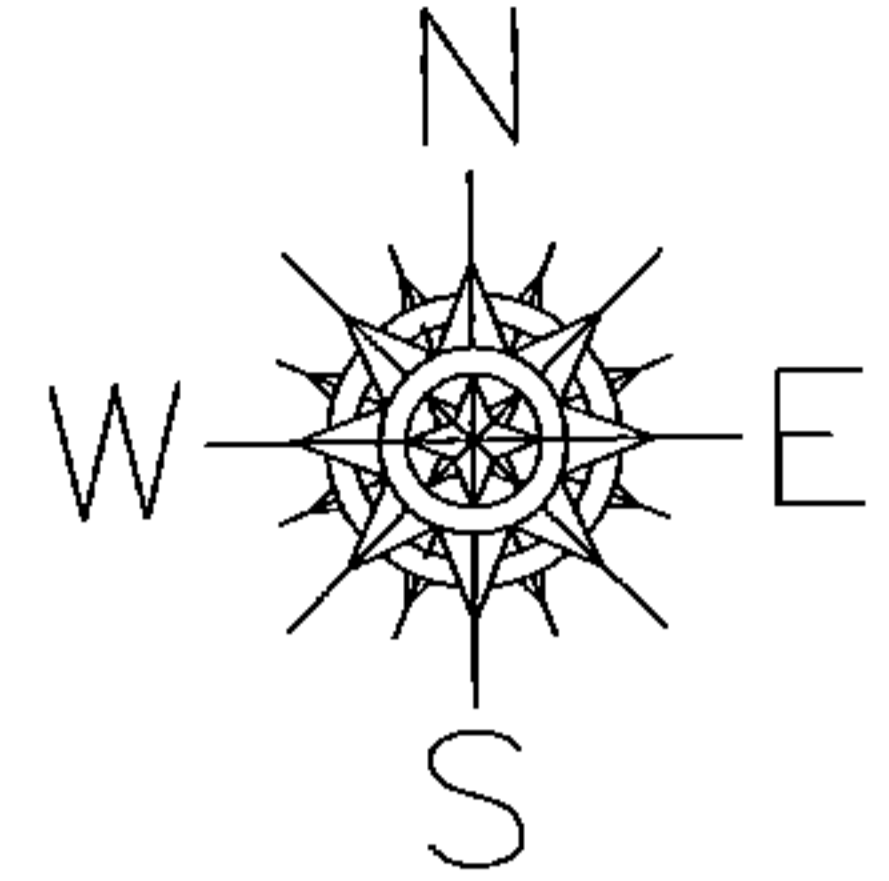

SPLITS/DEEDS PROCESSED

LORAIN COUNTY TAX MAP DEPARTMENT
226 MIDDLE AVE. ELYRIA, OHIO

SURVEYED BY: ROBERT G. HOY
 CLOSURE: .00:10,000
 MAP PAGE(S): 7-00-009-B
 APPROVED BY: TJS DATE: 9/24/14
 SCALE: 1"= 100 PRIOR INST.: 20030933499