
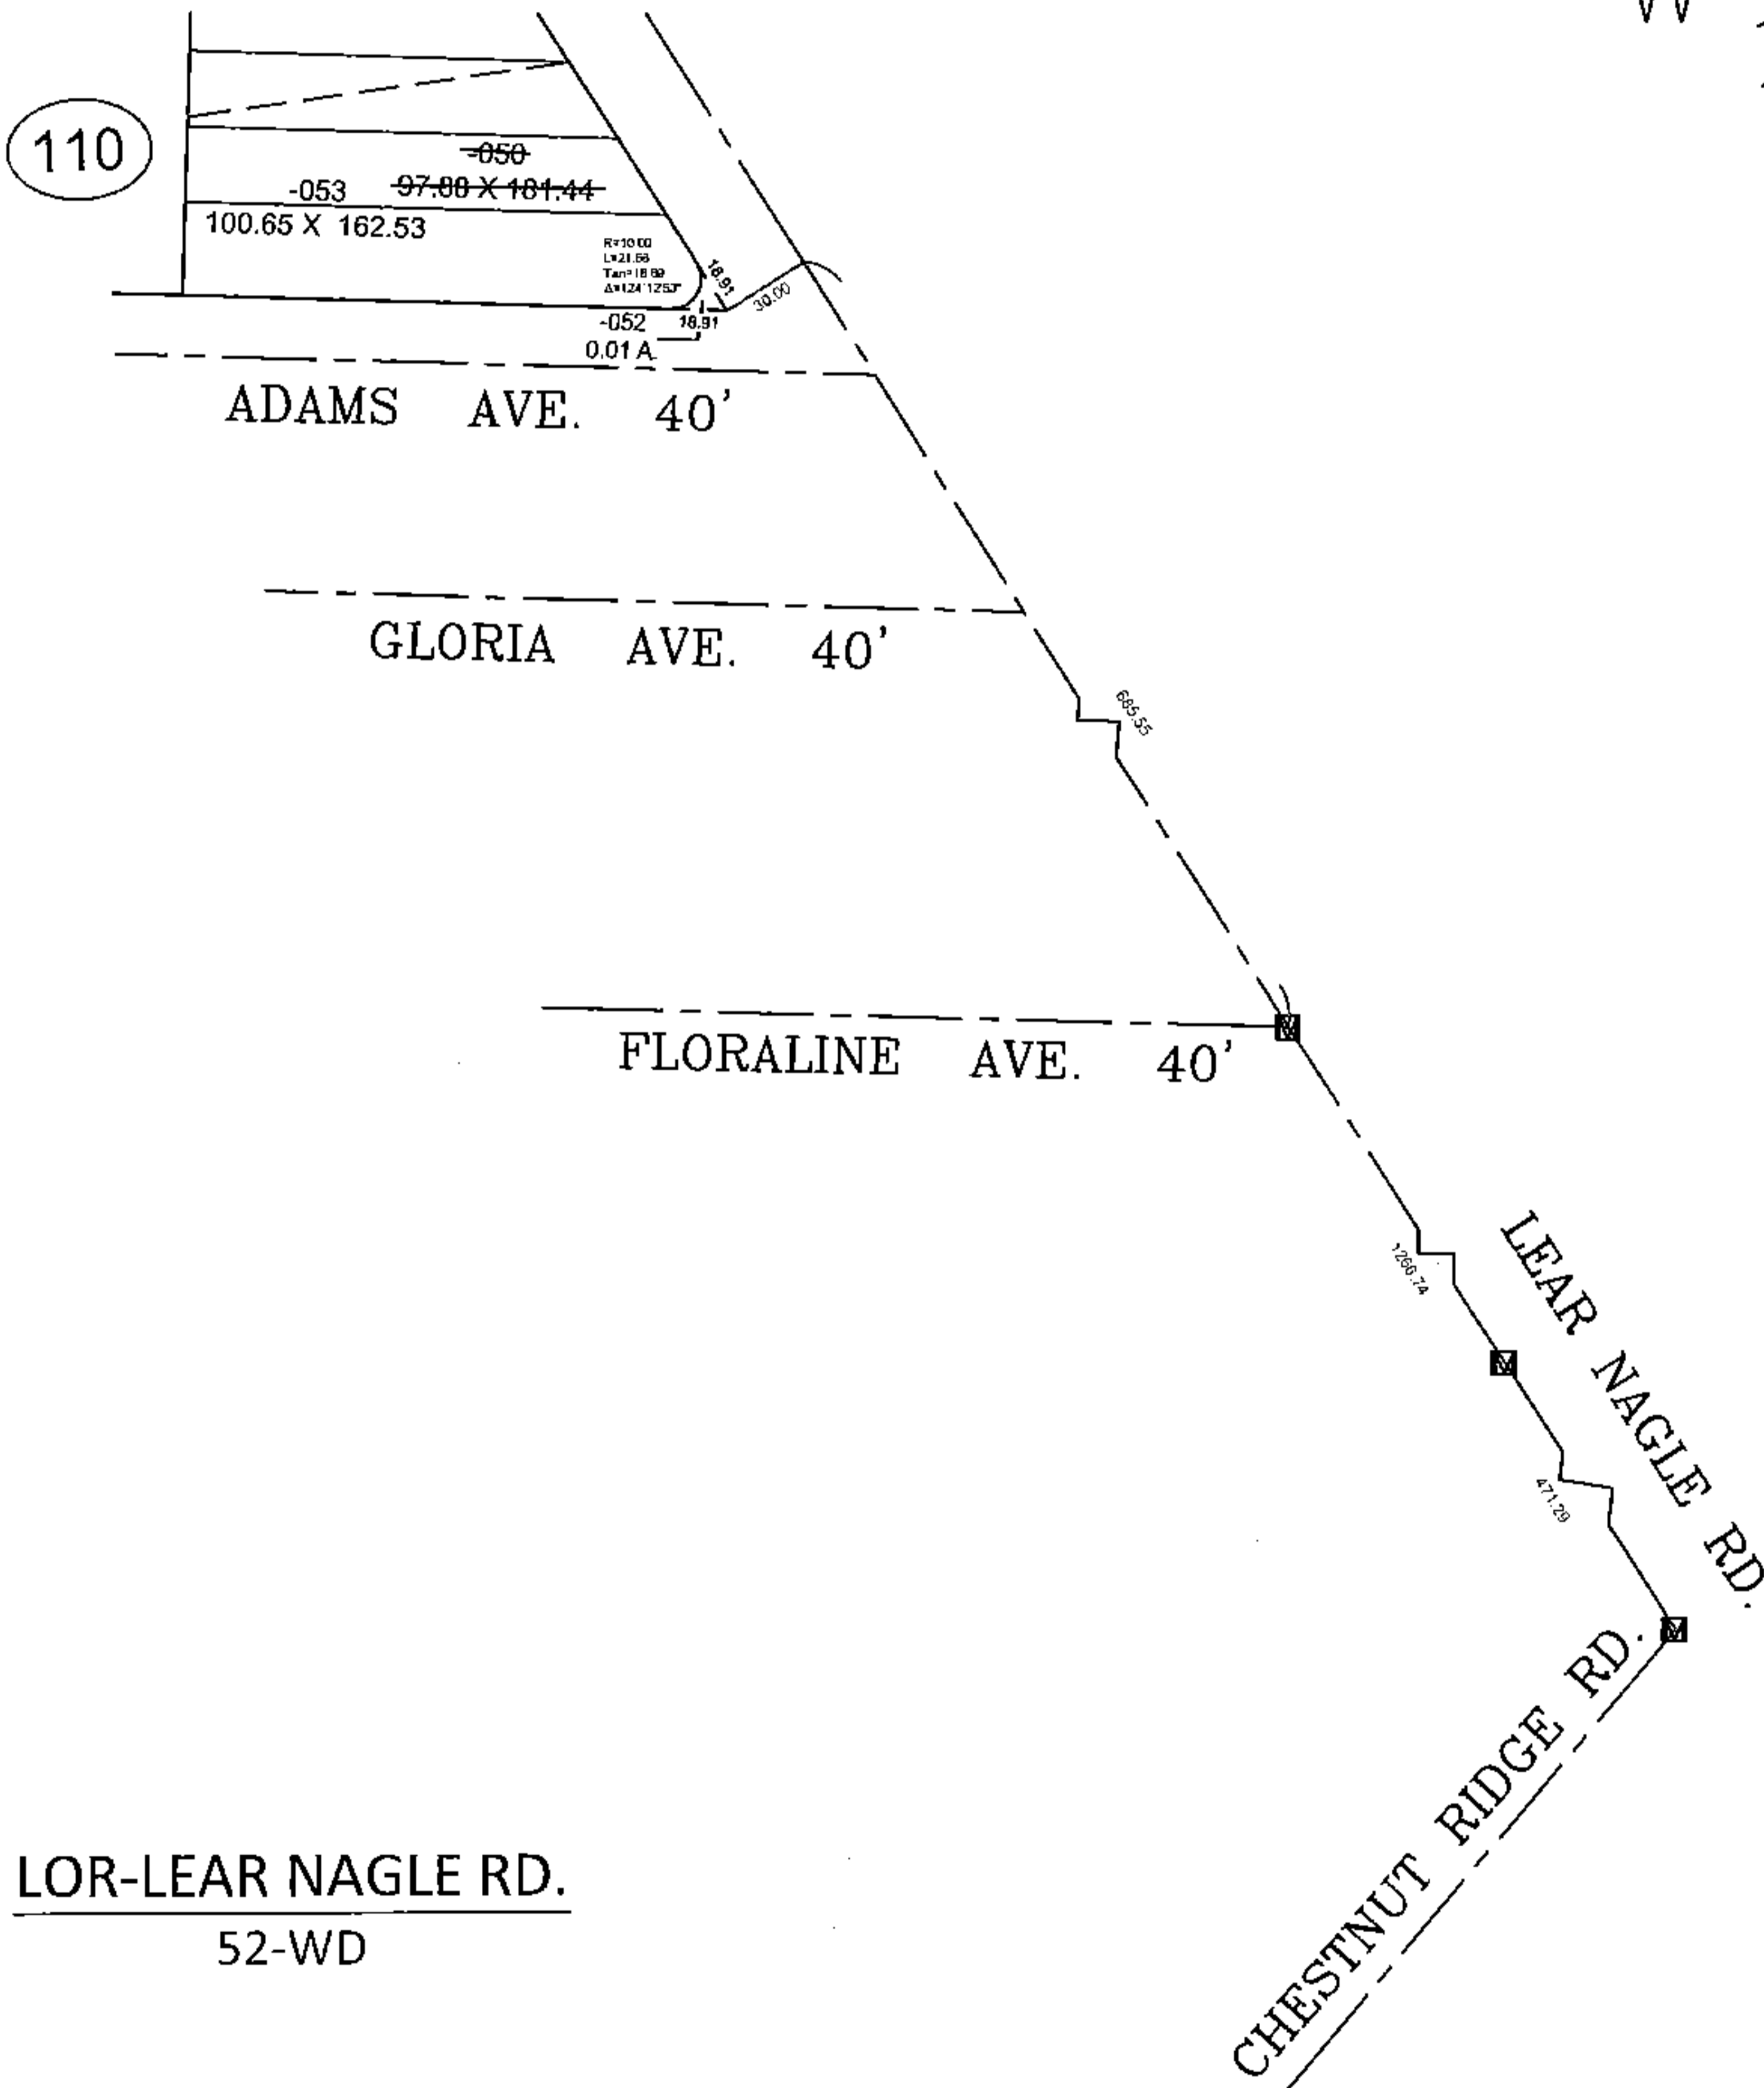


PARENT PARCEL: 07-00-009-110-050


CHILD PARCEL: 07-00-009-110-052 & -053

STARTING POINT: AT A MON BOX AT THE INTERSECTION OF C/L OF CHESTNUT RIDGE RD. AND C/L OF LEAR NAGLE RD.

14-00690

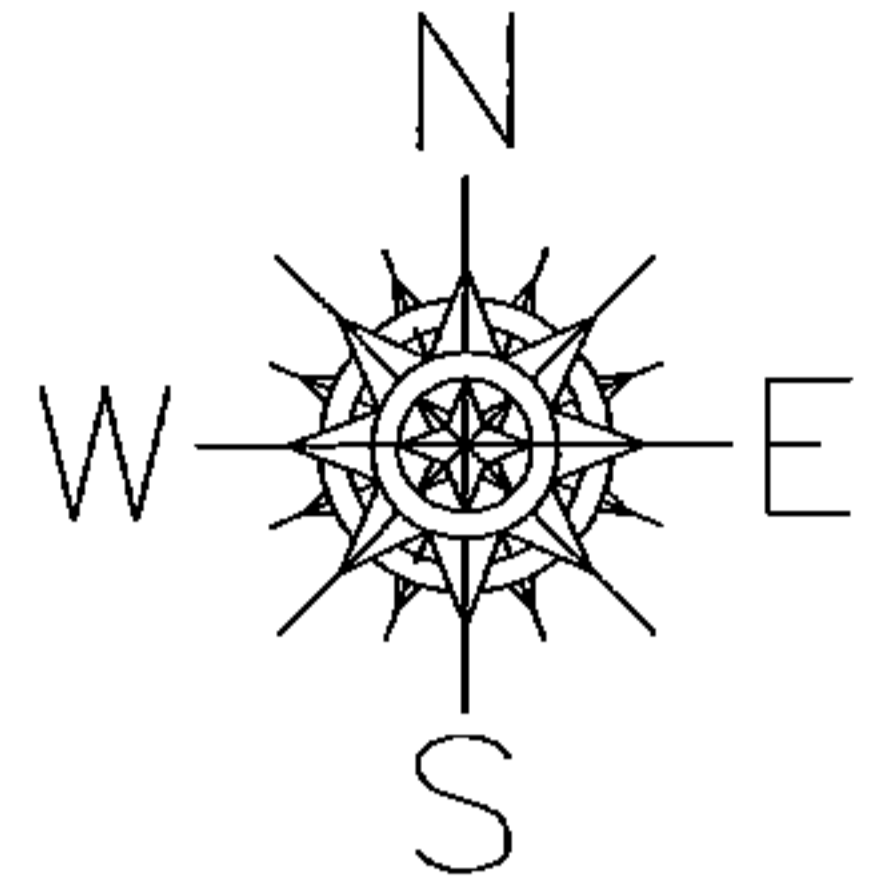

LOR-LEAR NAGLE RD.
52-WD

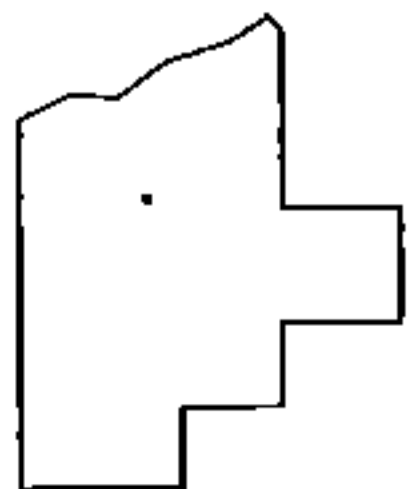

SPLITS/DEEDS PROCESSED

LORAIN COUNTY TAX MAP DEPARTMENT
226 MIDDLE AVE. ELYRIA, OHIO

SURVEYED BY: ROBERT G. HOY

CLOSURE: .00:10,000

MAP PAGE(S): 7-00-009-B

APPROVED BY: TJS DATE: 9/24/14

SCALE: 1"= 100 PRIOR INST.: 19970475742