
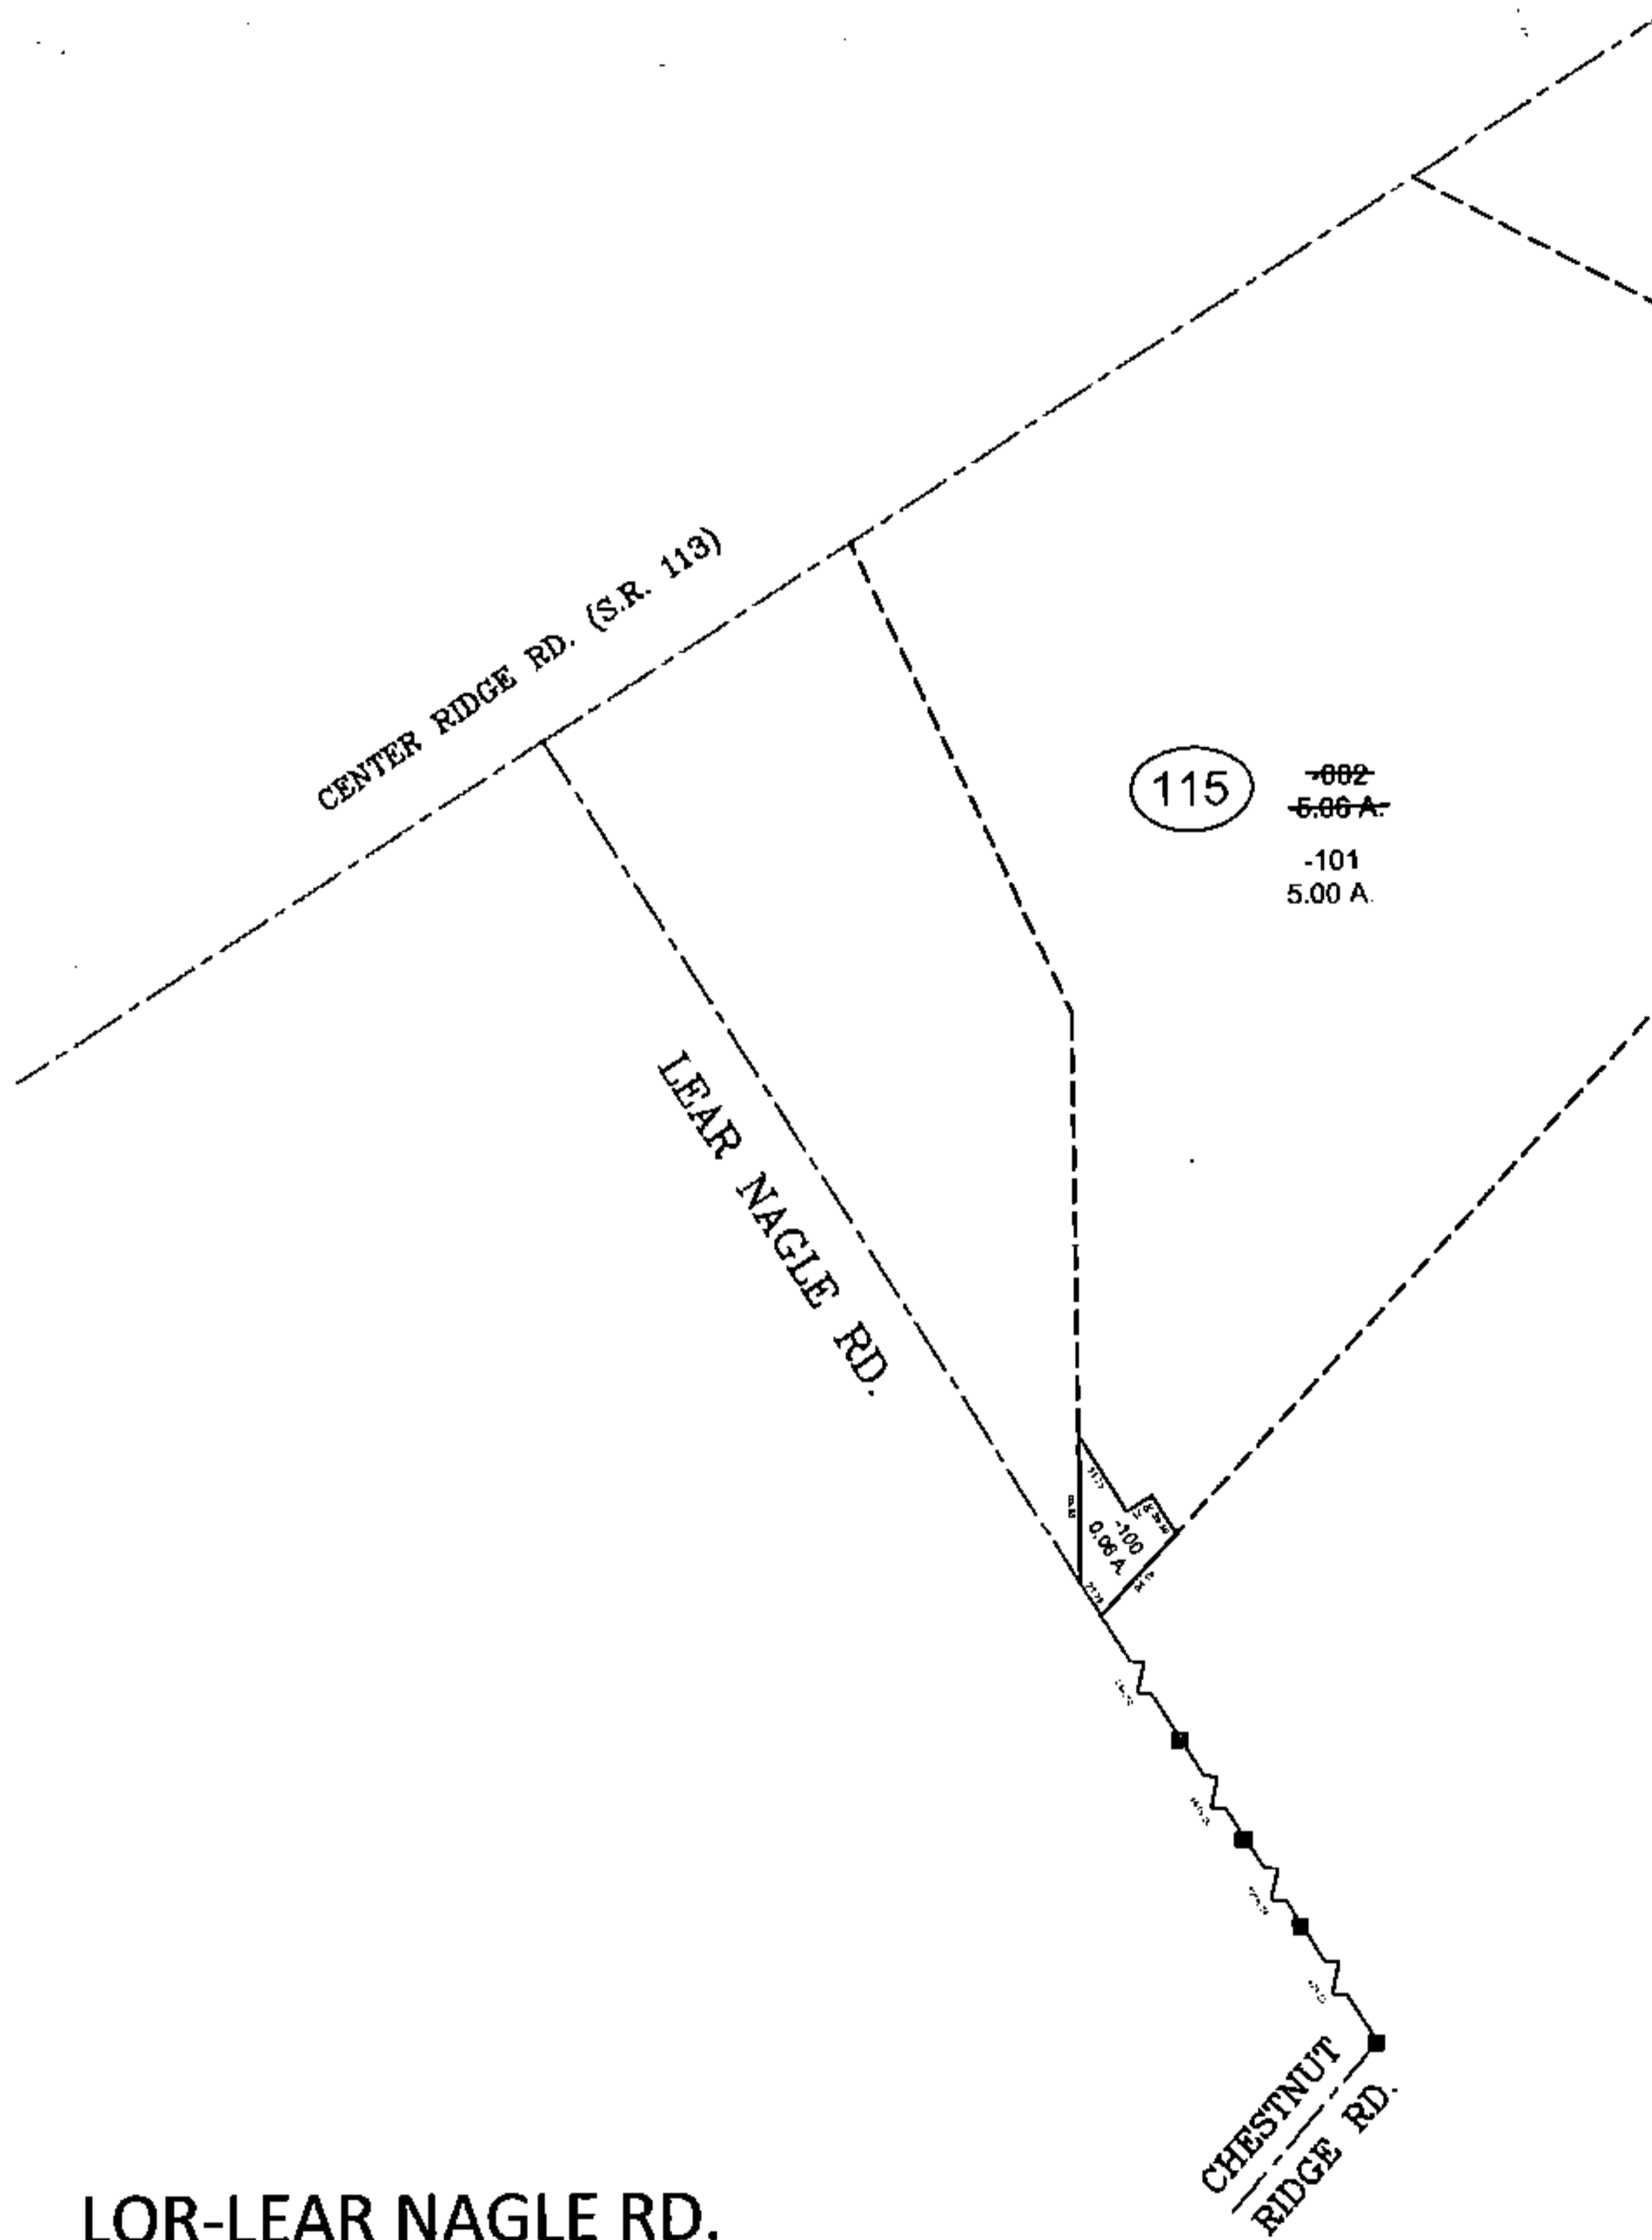


PARENT PARCEL: 07-00-008-115-002


CHILD PARCEL: 07-00-008-115-100 & -101

STARTING POINT: MON. BOX AT THE INTERSECTION OF C/L OF CHESTNUT RIDGE RD. AND C/L OF LEAR NAGLE RD.

14-00695

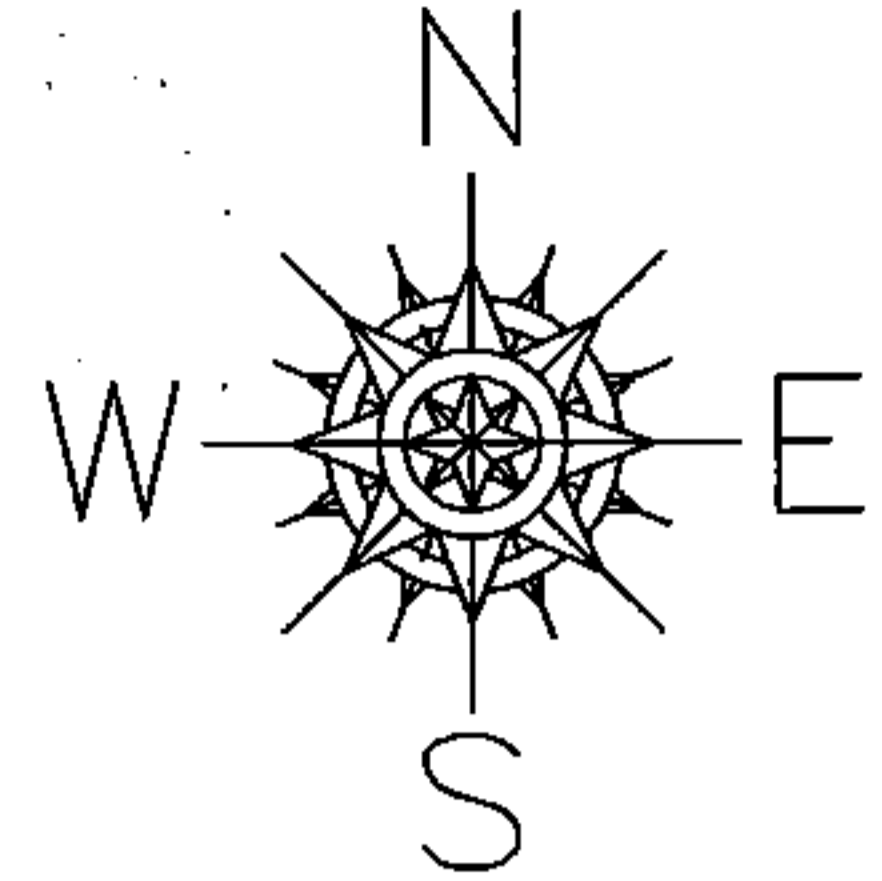

LOR-LEAR NAGLE RD.  
82-WD

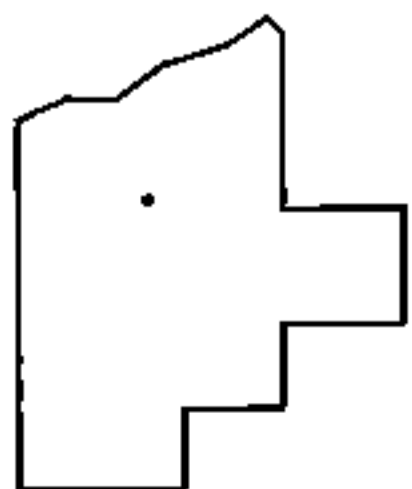

SPLITS/DEEDS PROCESSED

LORAIN COUNTY TAX MAP DEPARTMENT  
226 MIDDLE AVE. ELYRIA, OHIO

SURVEYED BY: ROBERT G. HOY

CLOSURE: 0.01 : 10,000

MAP PAGE(S): 7-00-008-C

APPROVED BY: TJS DATE: 12/2/14

SCALE: 1" = 200 PRIOR INST.: DV 1232/233