
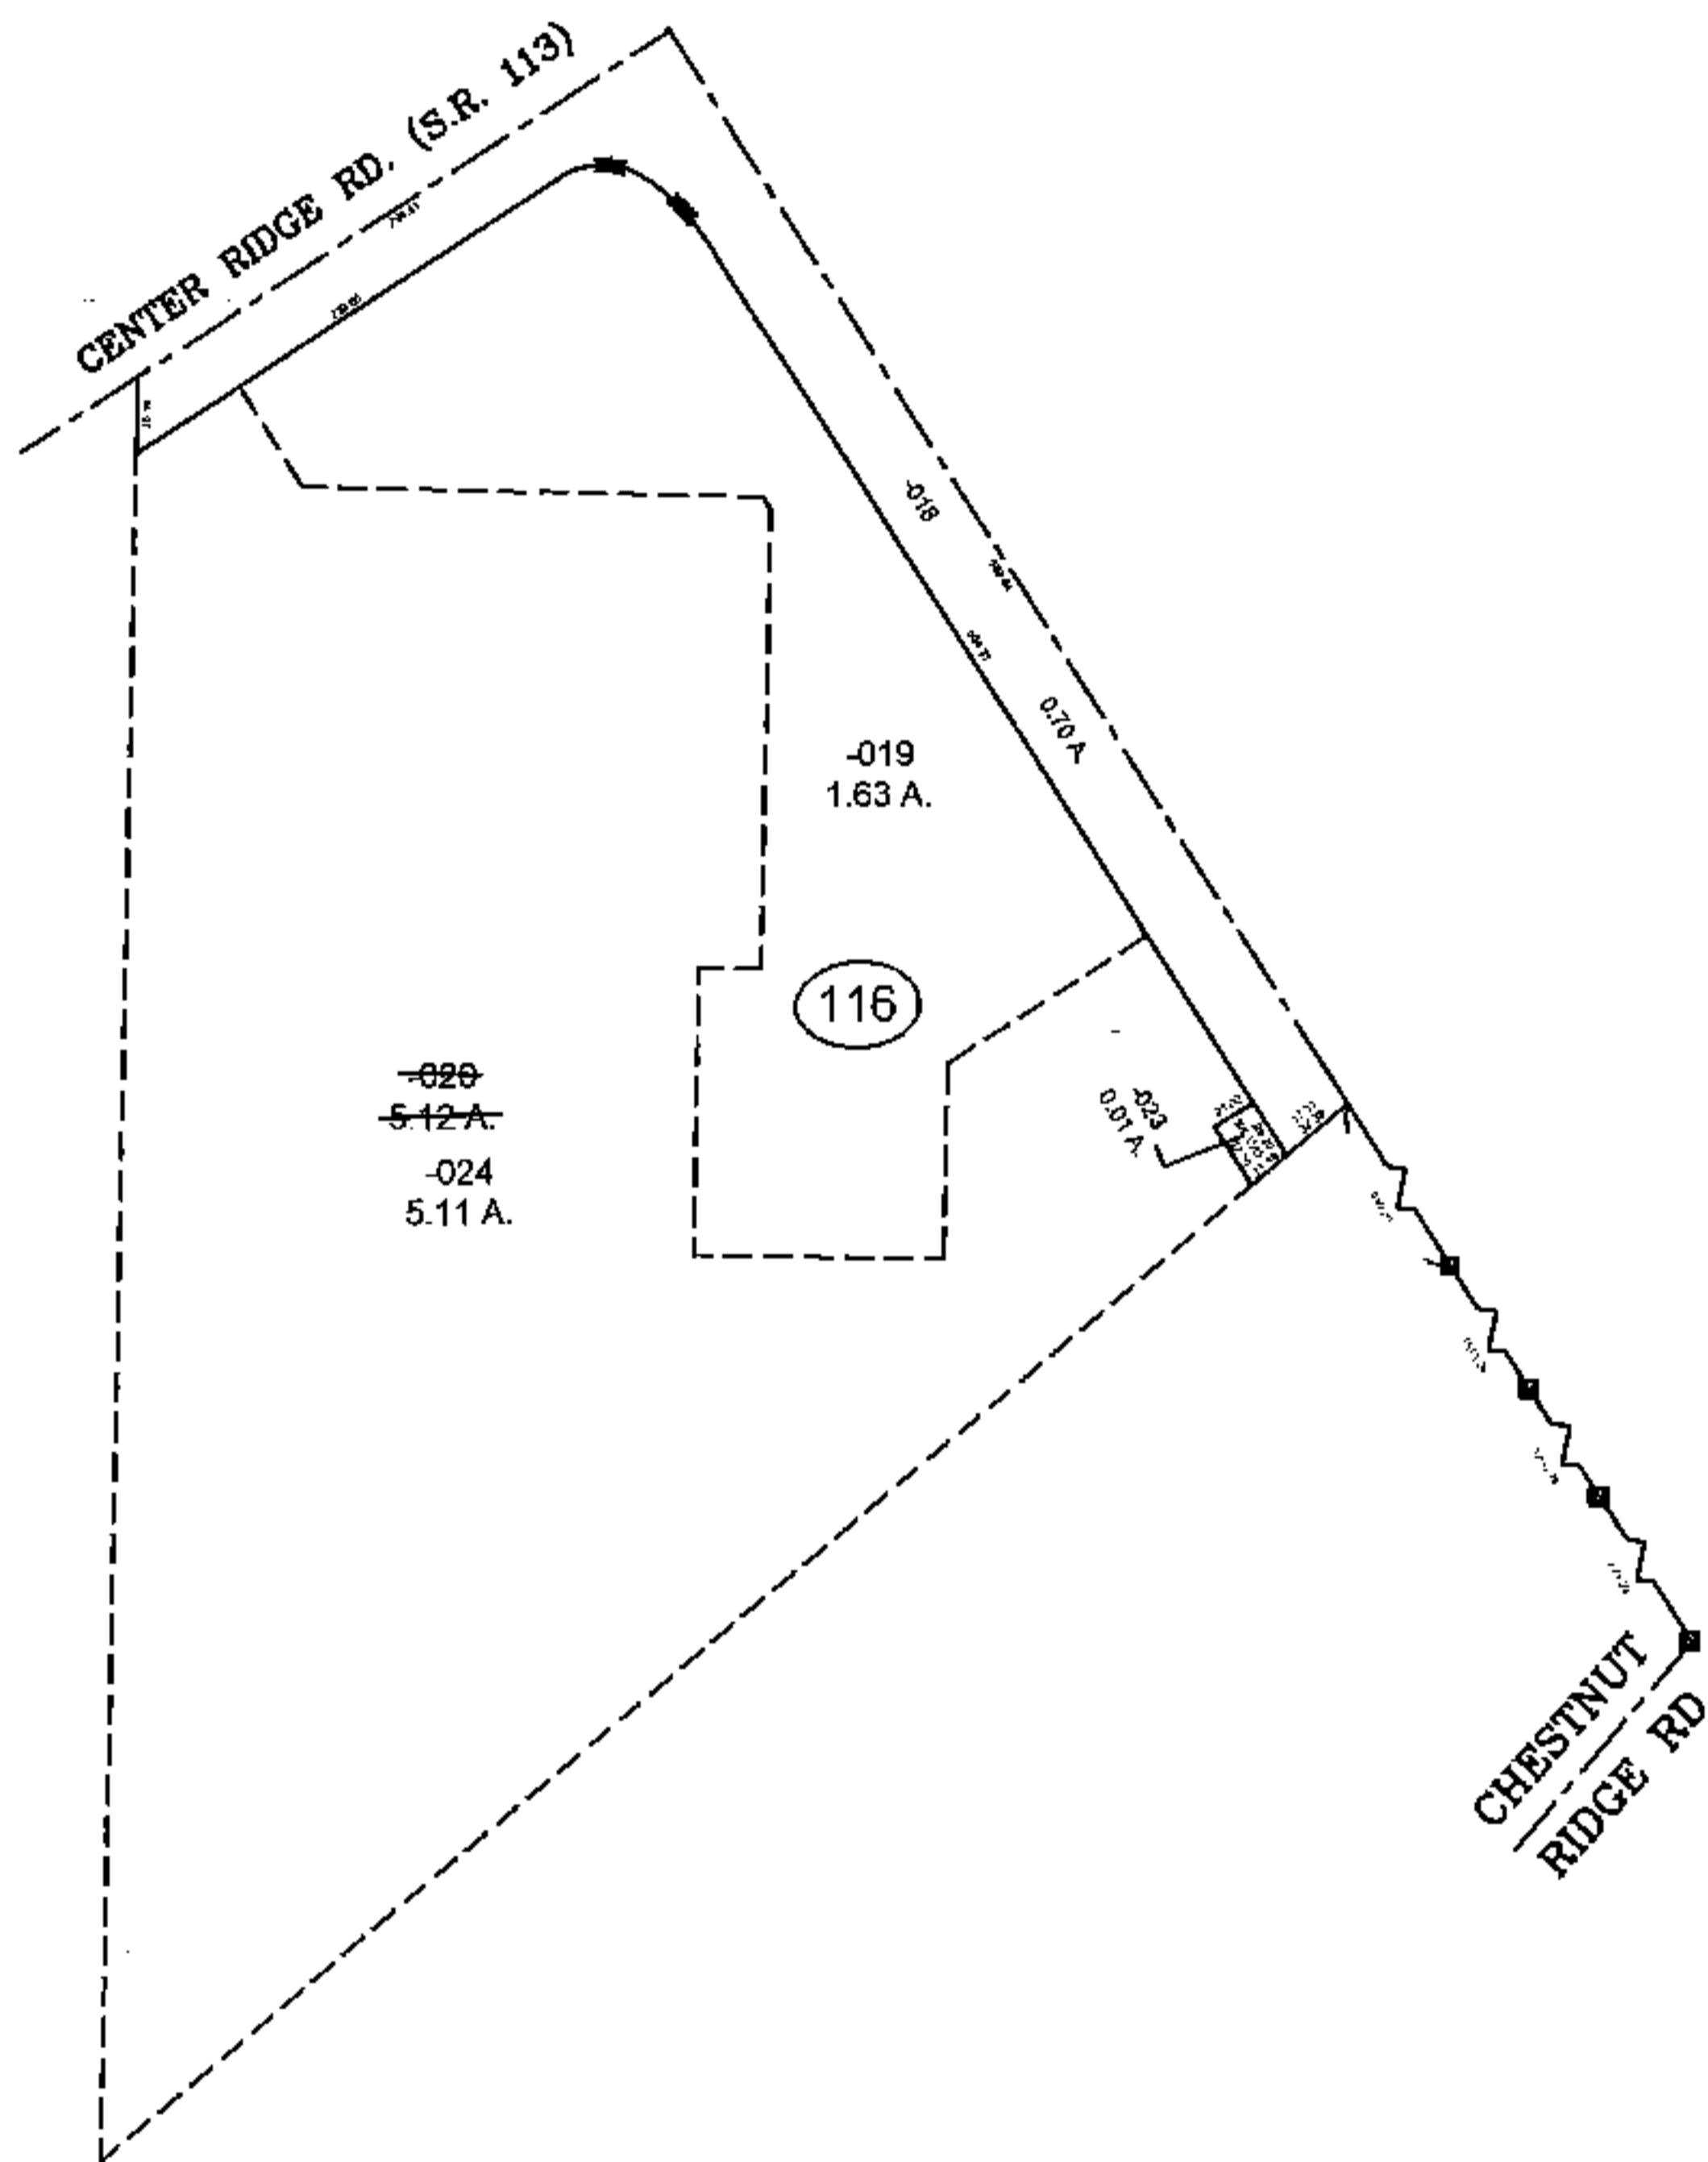


PARENT PARCEL: 07-00-008-116-020

CHILD PARCEL: 07-00-008-116-023 & -024


STARTING POINT: MON. BOX AT THE INTERSECTION OF C/L OF CHESTNUT RIDGE RD. AND C/L OF LEAR NAGLE RD.

14-00697

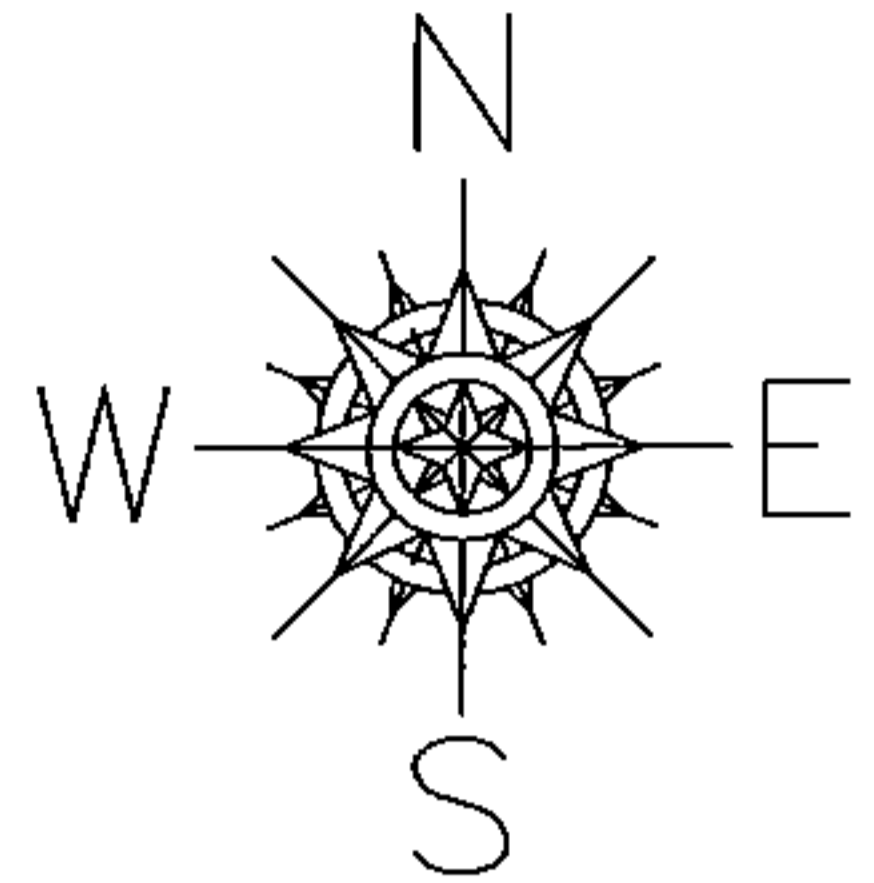

LOR-LEAR NAGLE RD.

84-WD

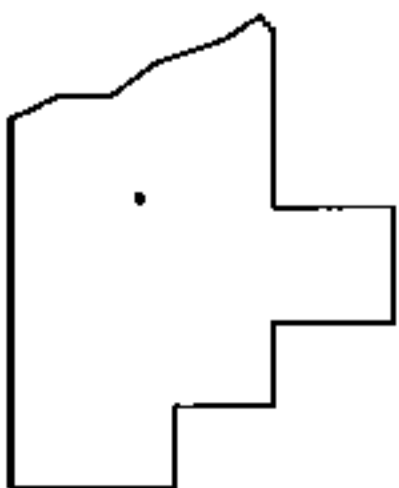

SPLITS/DEEDS PROCESSED

LORAIN COUNTY TAX MAP DEPARTMENT  
226 MIDDLE AVE. ELYRIA, OHIO

SURVEYED BY: ROBERT G. HOY

CLOSURE: 0.01 : 10,000

MAP PAGE(S): 7-00-008-C

APPROVED BY: TJS DATE: 12/4/14

SCALE: 1"= 200 PRIOR INST.: 20050110074