


PARENT PARCEL: 07-00-004-110-040

CHILD PARCEL: 07-00-004-110-051, -052



STARTING POINT: INTERSECTION OF C/L OF CHESTNUT RIDGE RD. AND C/L OF LEAR NAGLE RD.

14-00698

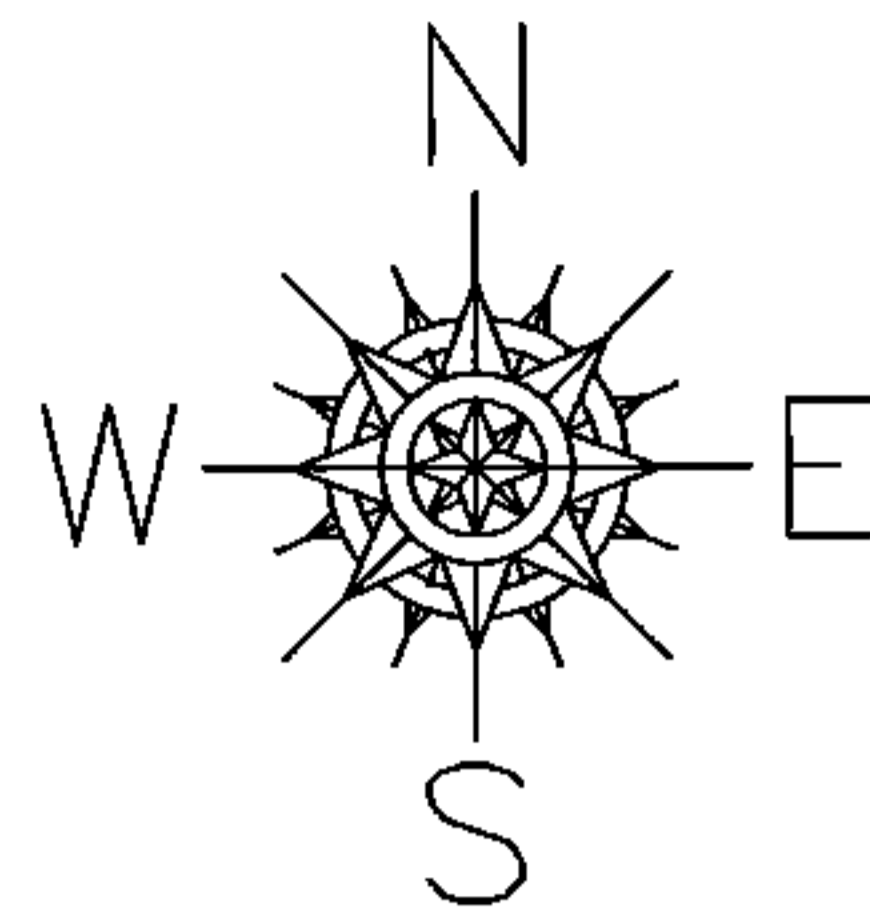

LOR-LEAR NAGLE ROAD

95-WD

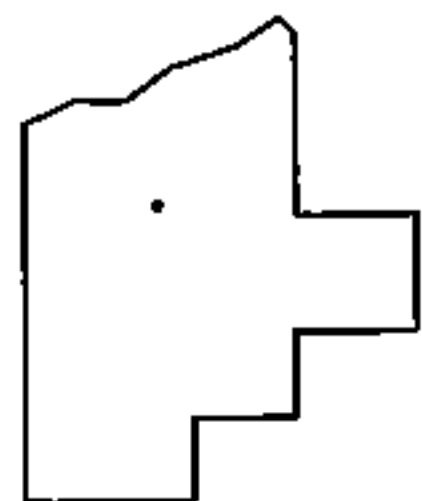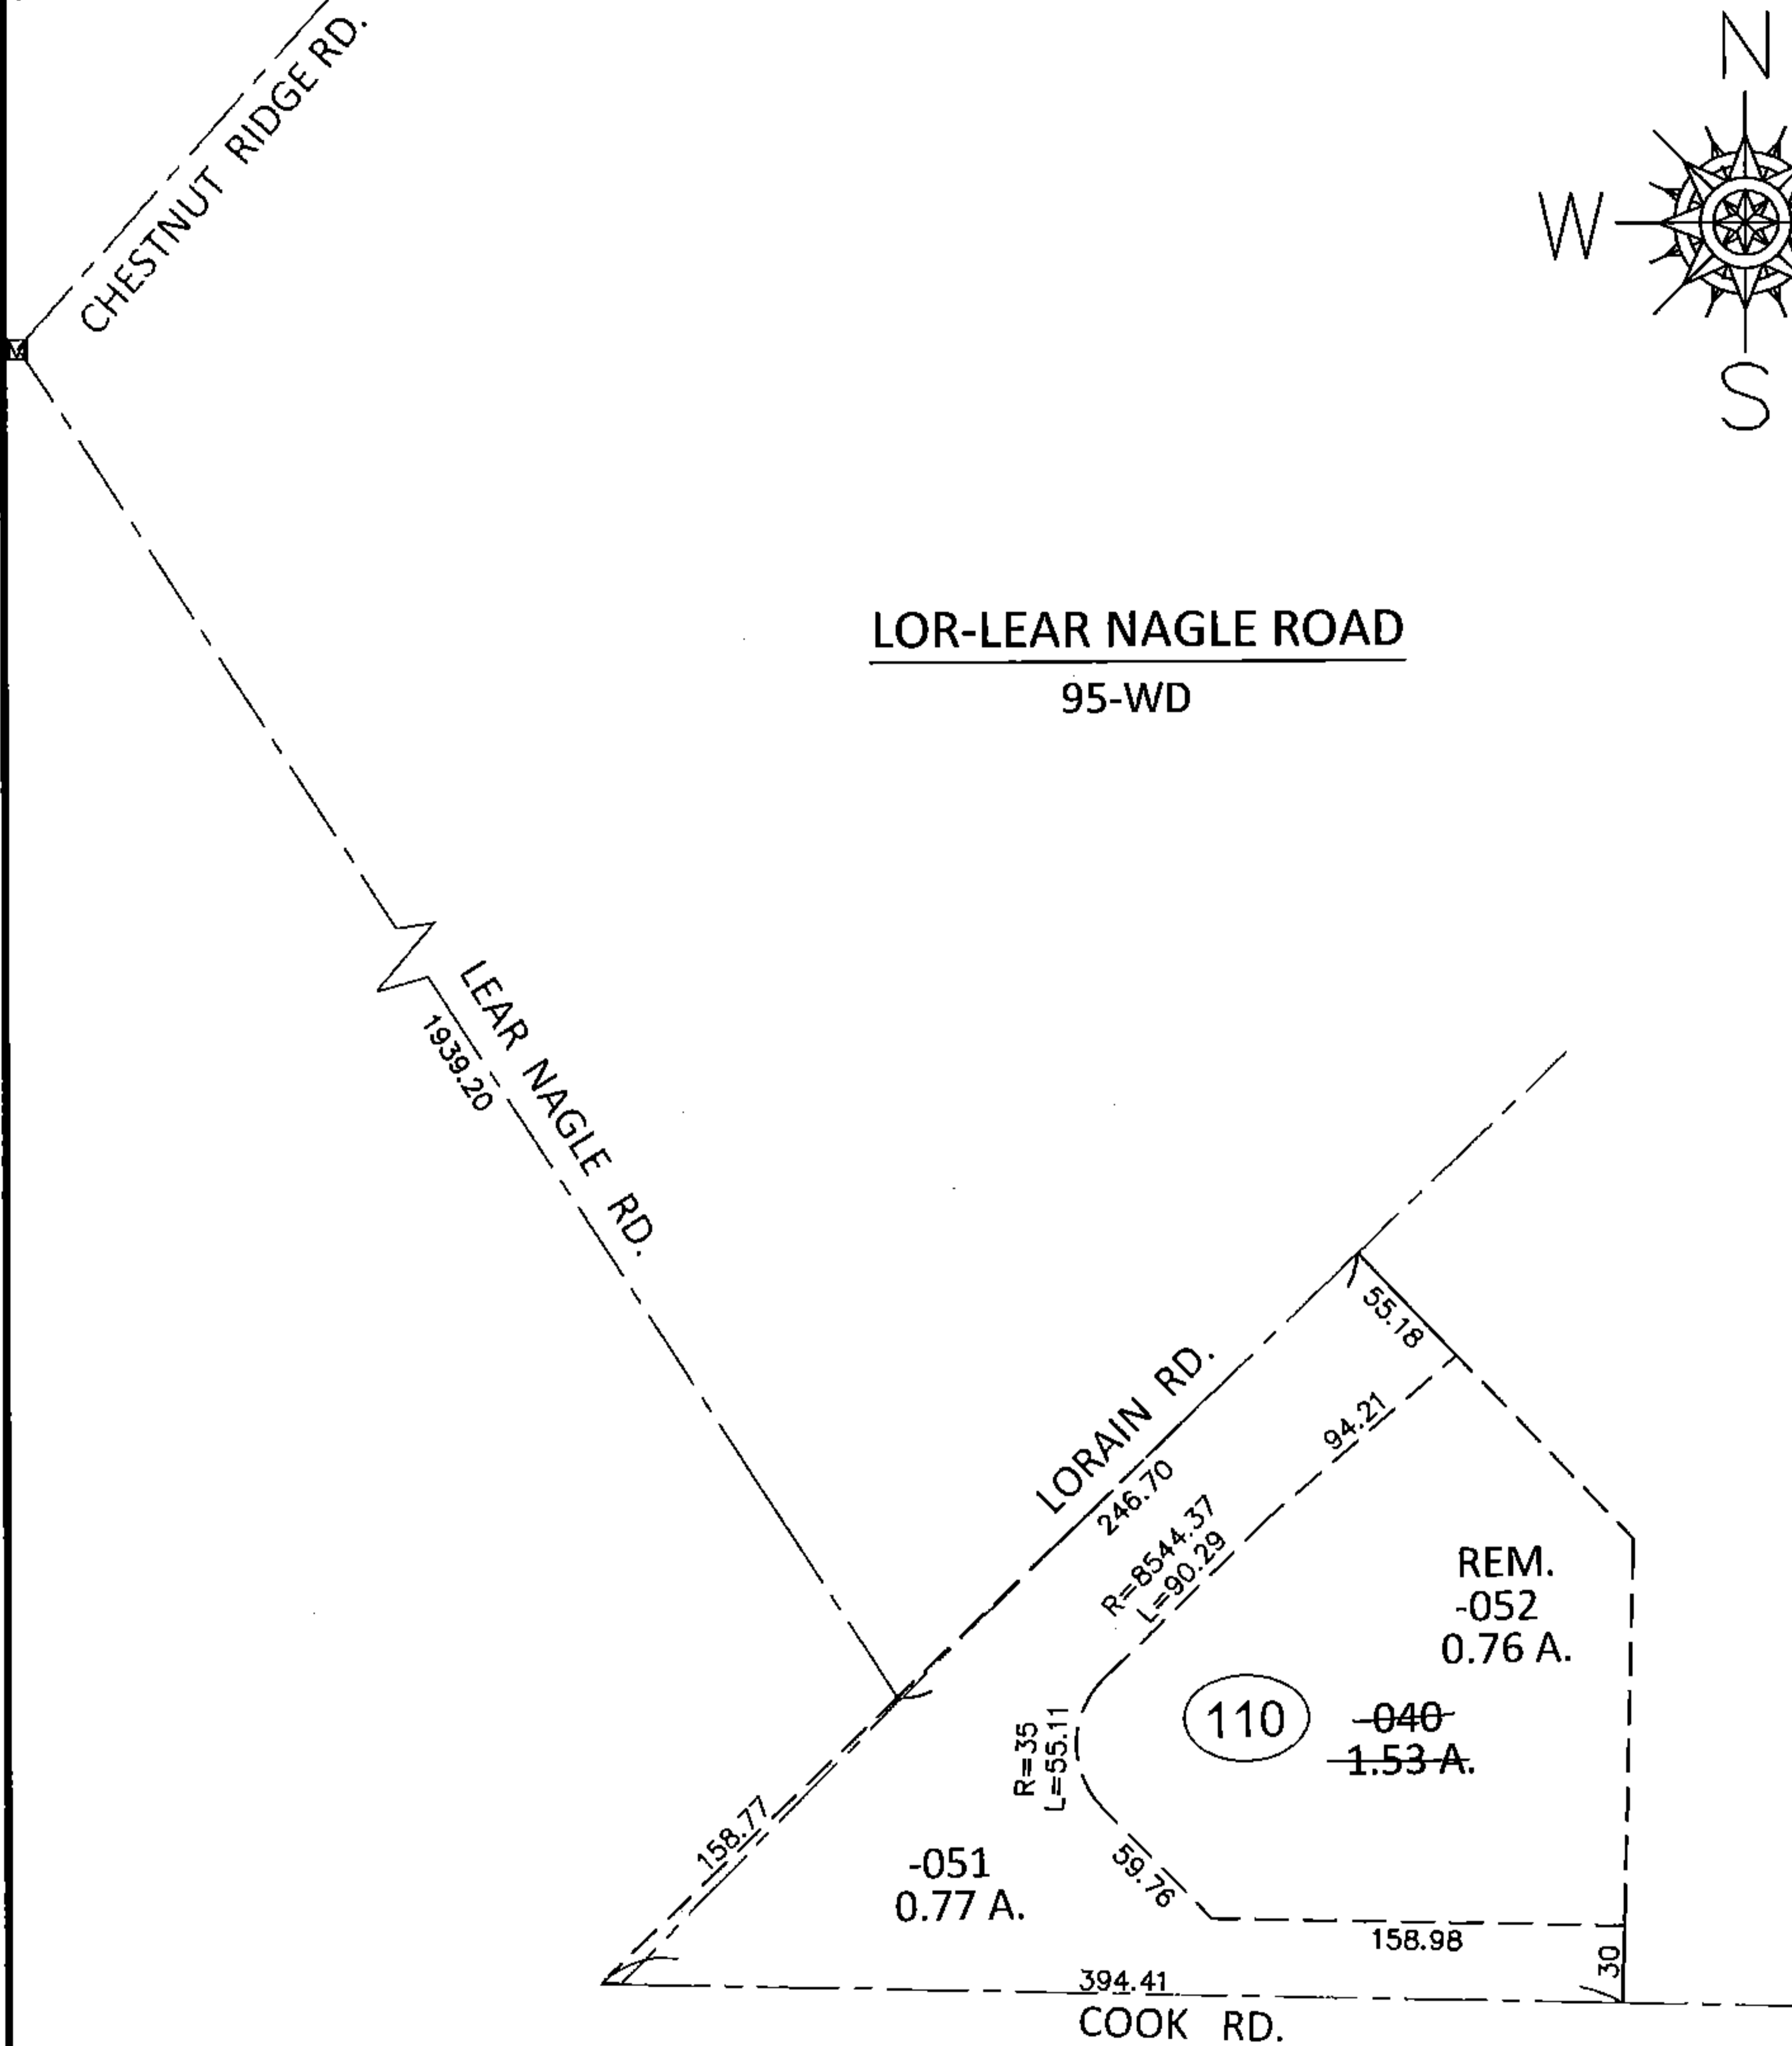

SPLITS/DEEDS PROCESSED

LORAIN COUNTY TAX MAP DEPARTMENT
226 MIDDLE AVE. ELYRIA, OHIO

SURVEYED BY: ROBERT G. HOY

CLOSURE: .01:10.000

MAP PAGE(S): 7-00-004-D

APPROVED BY: RRM DATE: 1-20-15

SCALE: 1"= 100 PRIOR INST.: 20040986127