
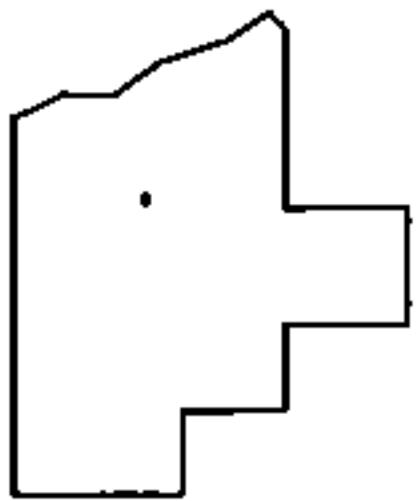


PARENT PARCEL: 04-00-021-000-132
CHILD PARCEL: 04-00-021-000-281, -282
STARTING POINT: INTERSECTION OF C/L OF NAGEL RD. AND SOUTH LINE OF SEC.21

14-00699

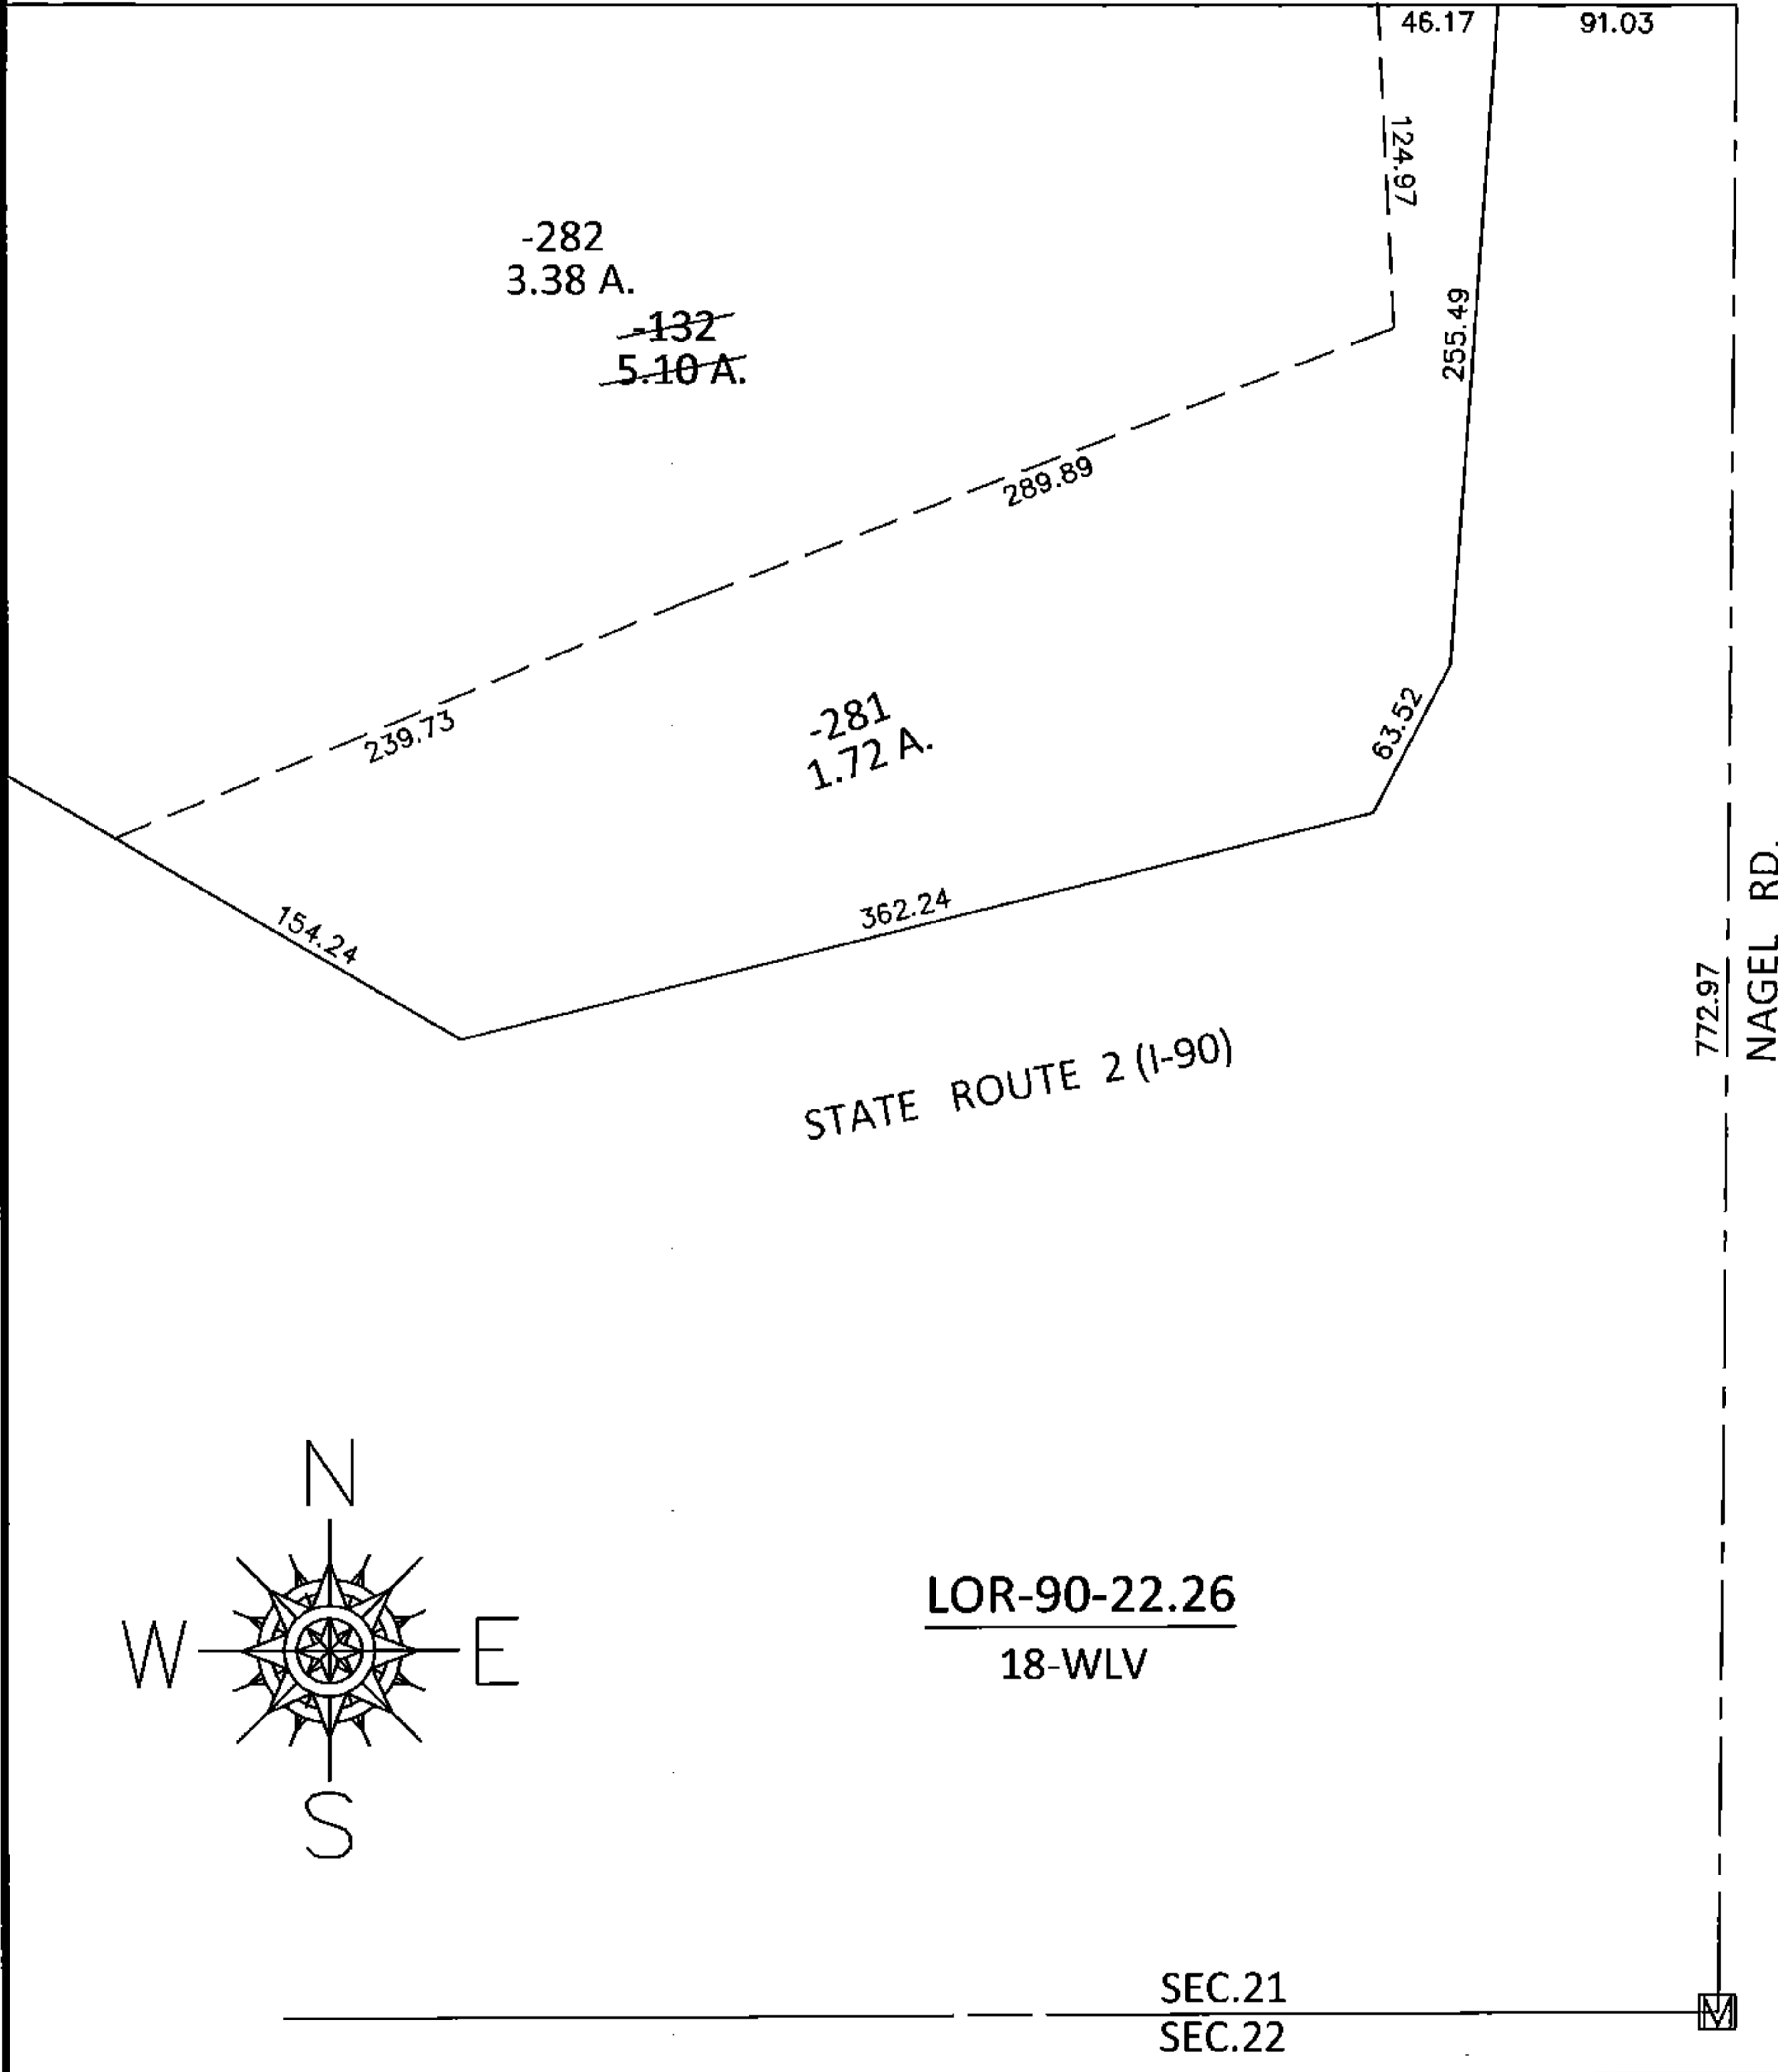

SPLITS/DEEDS PROCESSED
LORAIN COUNTY TAX MAP DEPARTMENT
226 MIDDLE AVE. ELYRIA, OHIO

SURVEYED BY: WILLIAM J. SALA
CLOSURE: .01:10,000
MAP PAGE(S): 4-00-021-H
APPROVED BY: RRM DATE: 11-25-14
SCALE: 1"= 100 PRIOR INST.: OR 1263/481