


SEE 7-00-009-D #14000

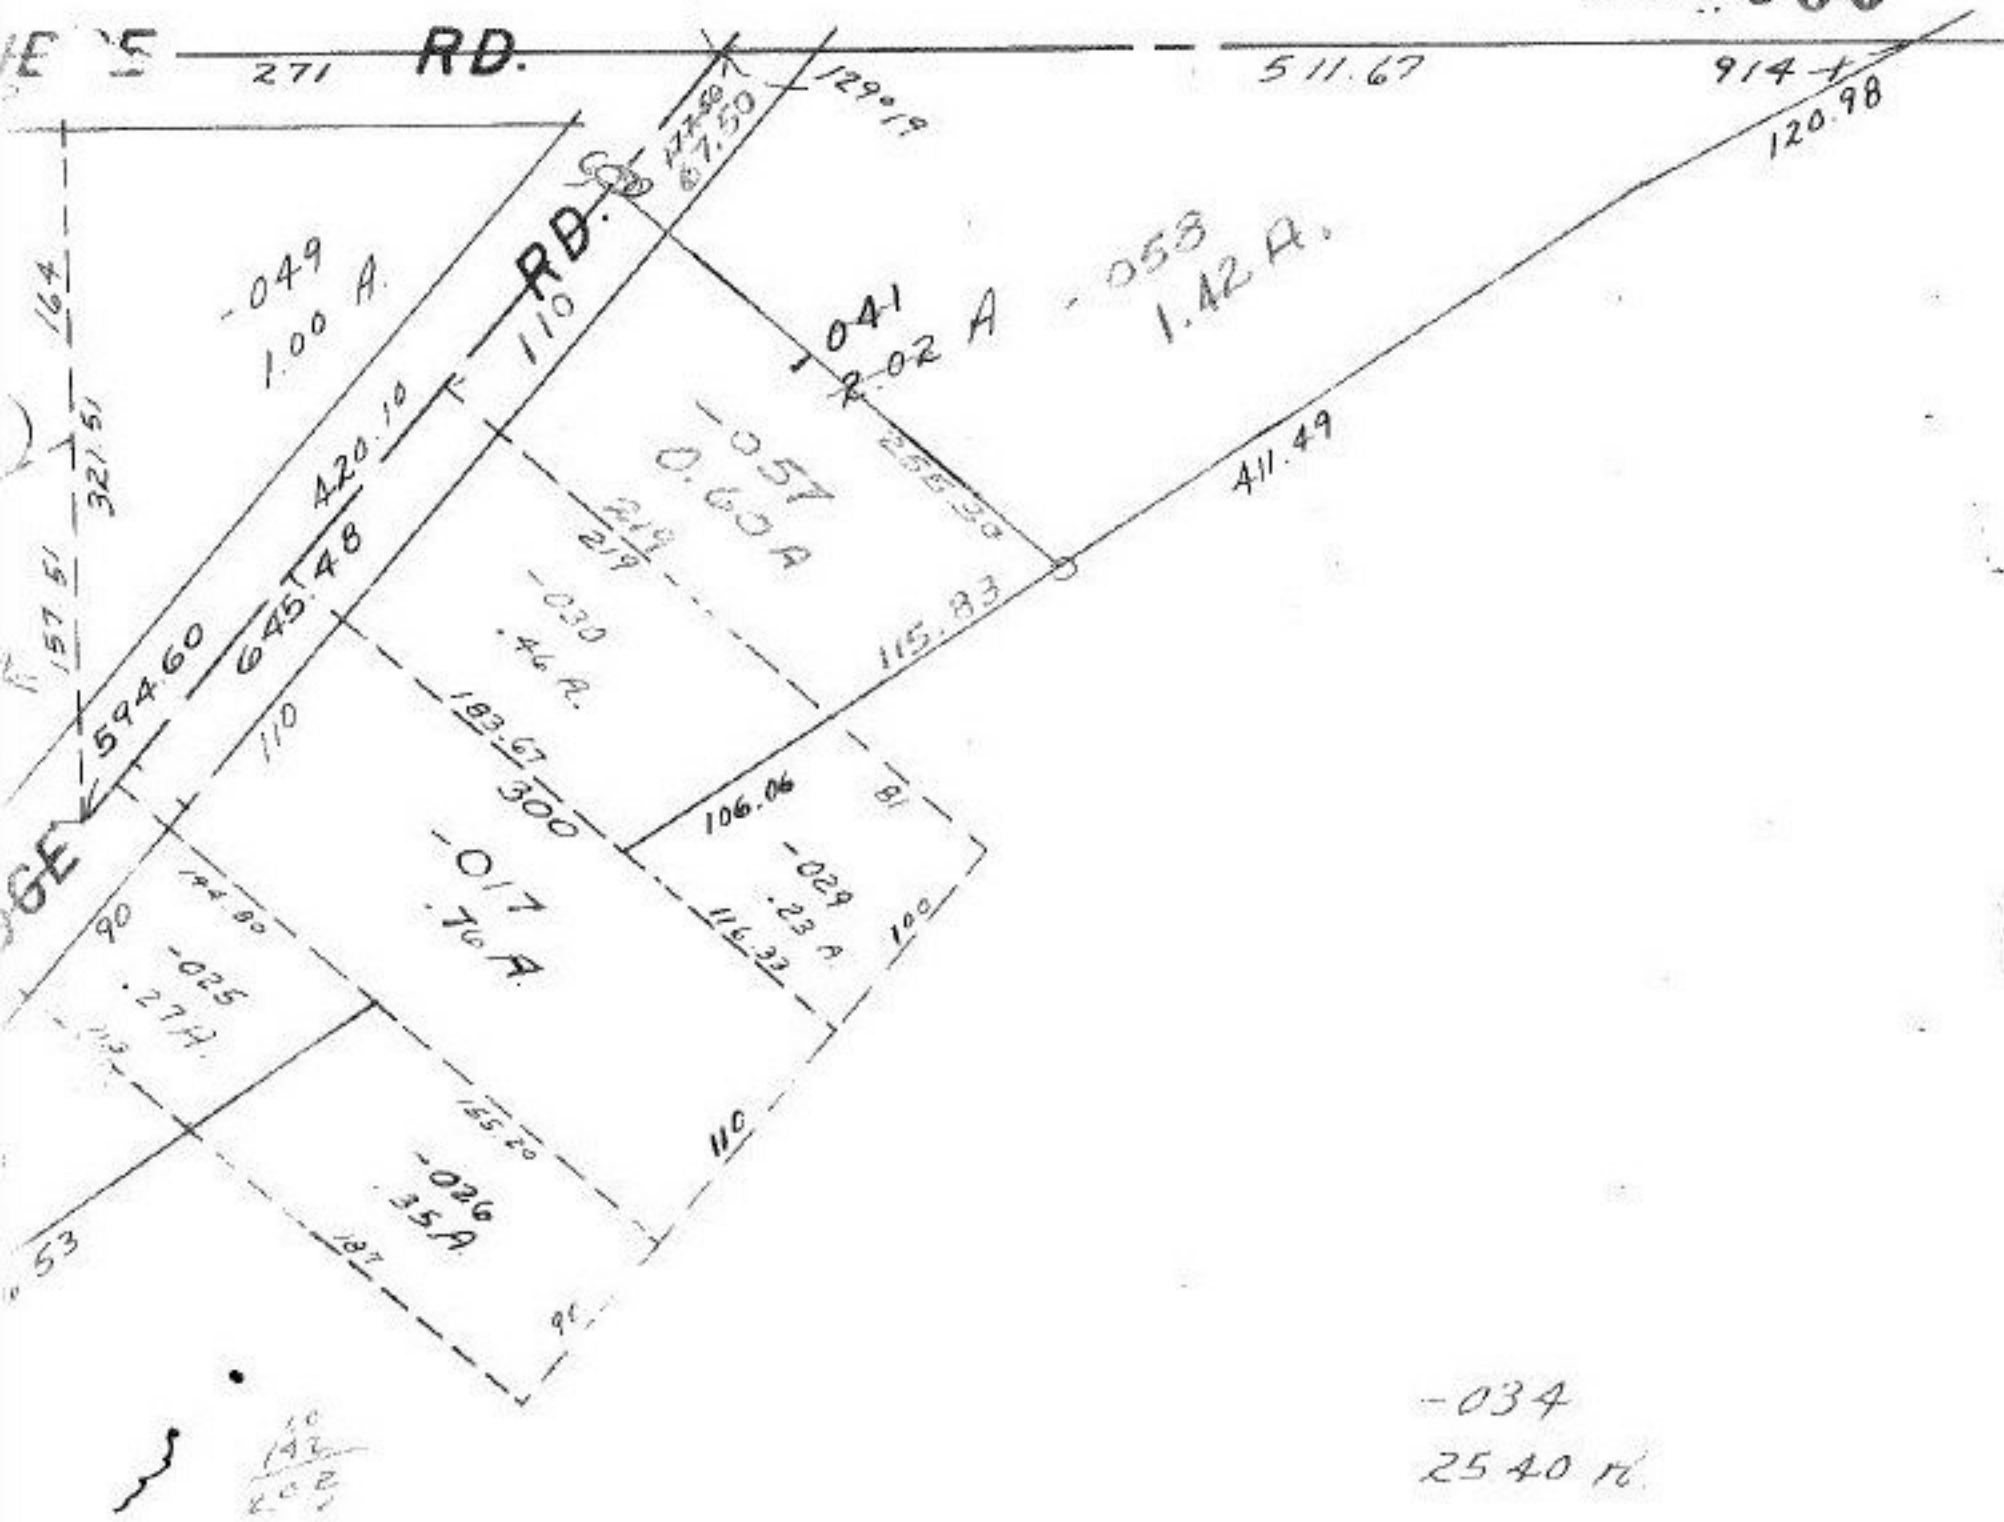

#14000

APPROVED
LORAIN CO.
MAP DEPT.
DATE 1-13-81
PAGE 7-00-010-
BY Carolyn F
VOID AFTER 14000

T.M.
4-20-81

B

40.80