


14016

ANNEXA
COMM. I
65-7:

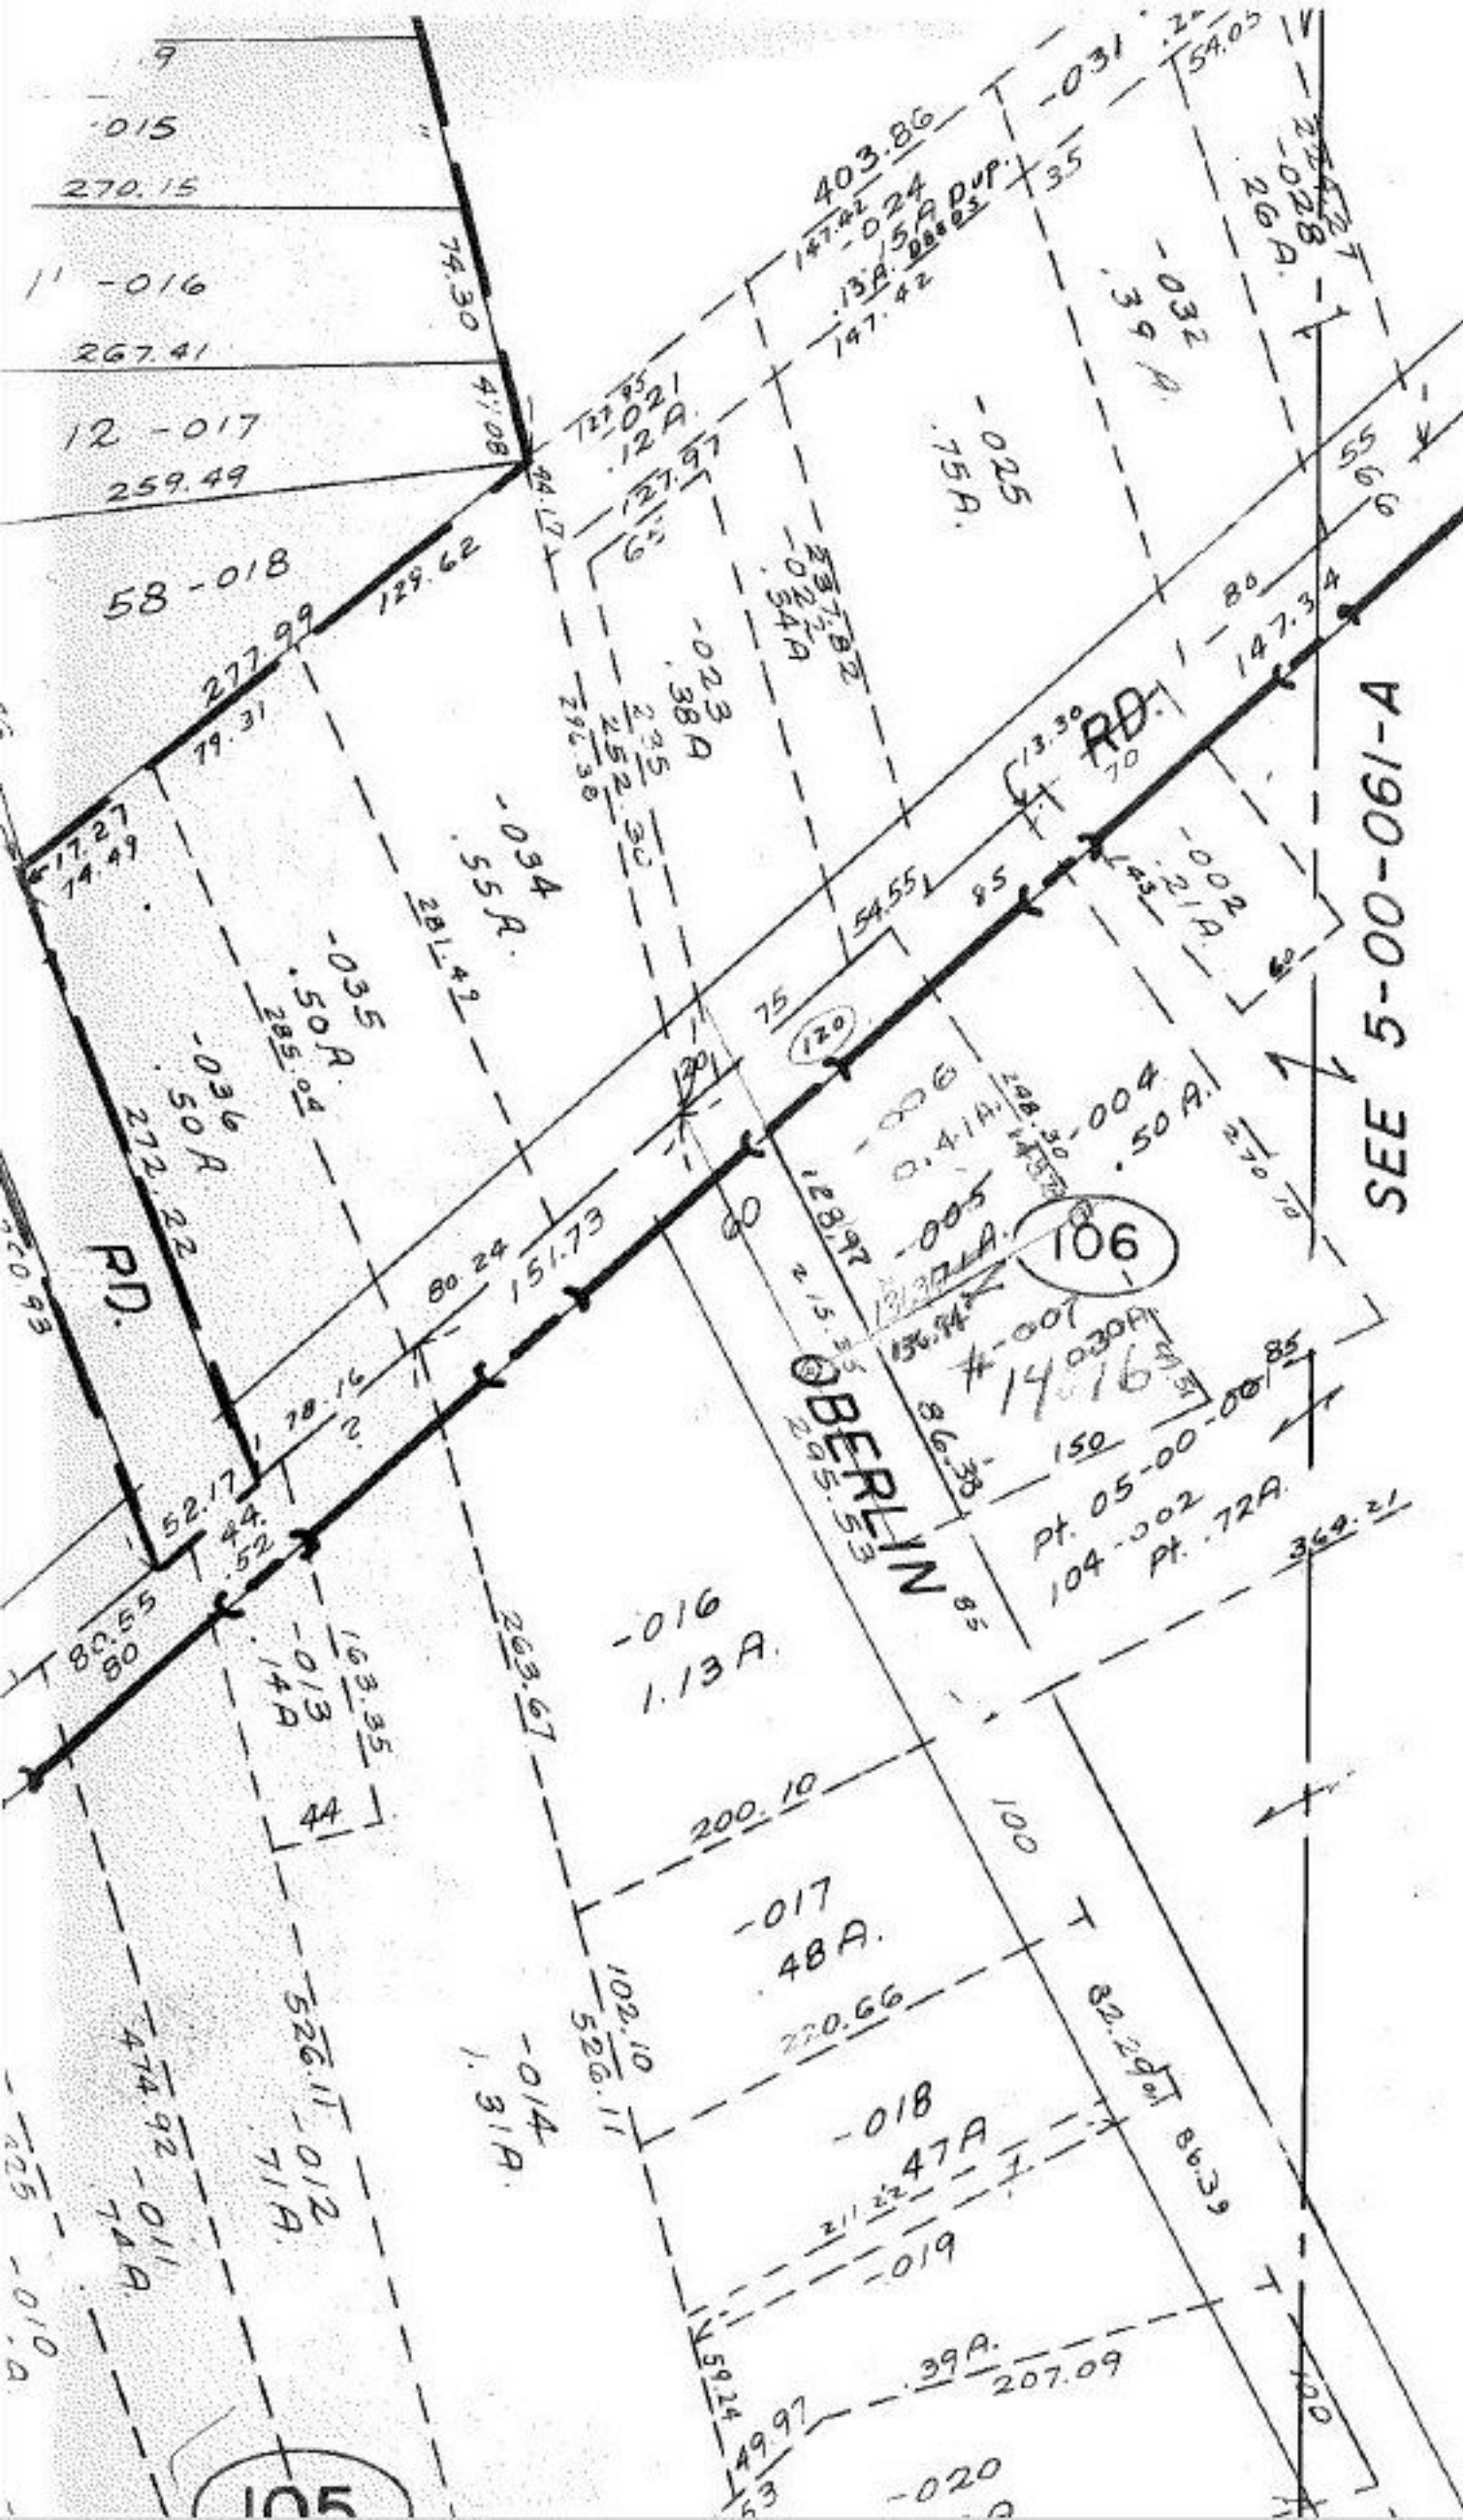

SEE 5-00-061-A

OBERLIN

4-13-81
T.M.

14016

APPROVED LORAIN CO. MAP DEPT.	
DATE 1-23-81	
PAGE 15-00-060-B	
BY <i>C. A. Adams</i>	
VOID AFTER	14016