


104

129.96

14022

Pt. - 034

Pt. 6.82 A

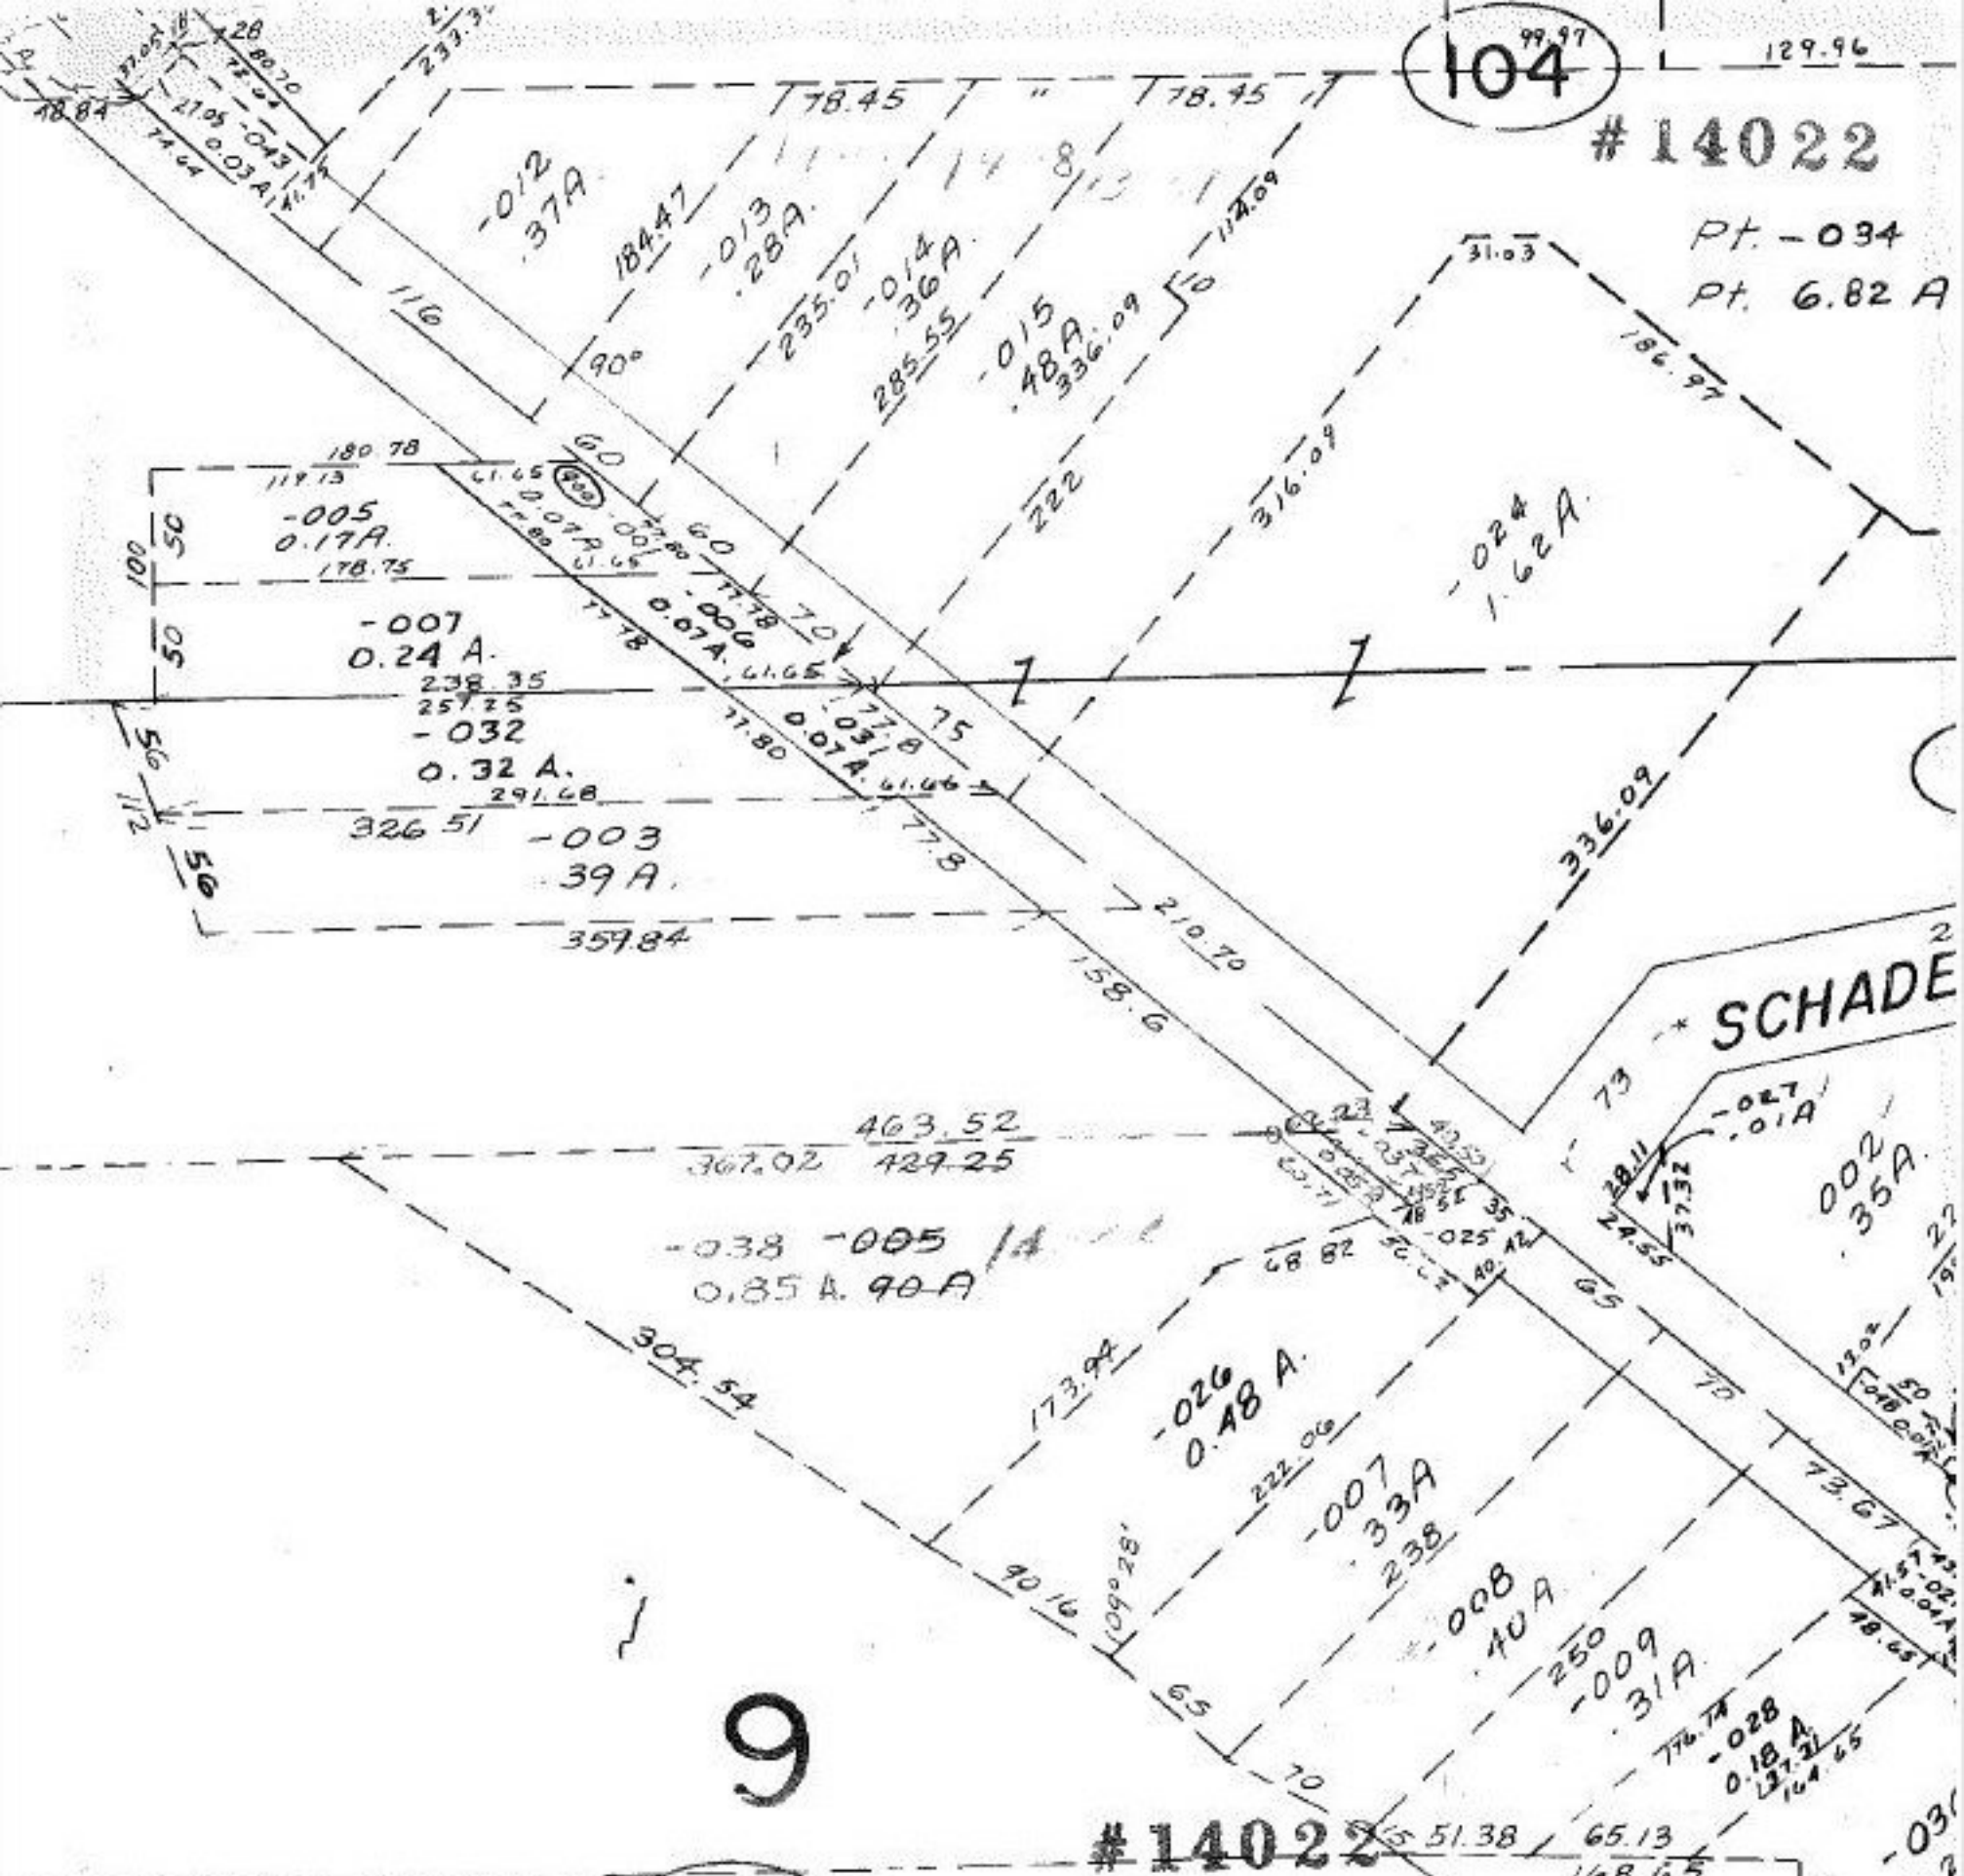

101

14022

APPROVED LORAIN CO. MAP DEPT.	
DATE 2-2-81	
PAGE 6-24	
BY <i>C. ...</i>	
VOID	AFTER

T.M.
4-14-81

-011
12.40 A.

