


#14030

Acreages Correction (1 parcel was included  
IN Acreages Correction - that should not have  
been included - Already has it own Number

~~5173 A~~

50.75 A.

SPLIT NO \* 14004 DATE 1-14-81  
05-00-086-000-004

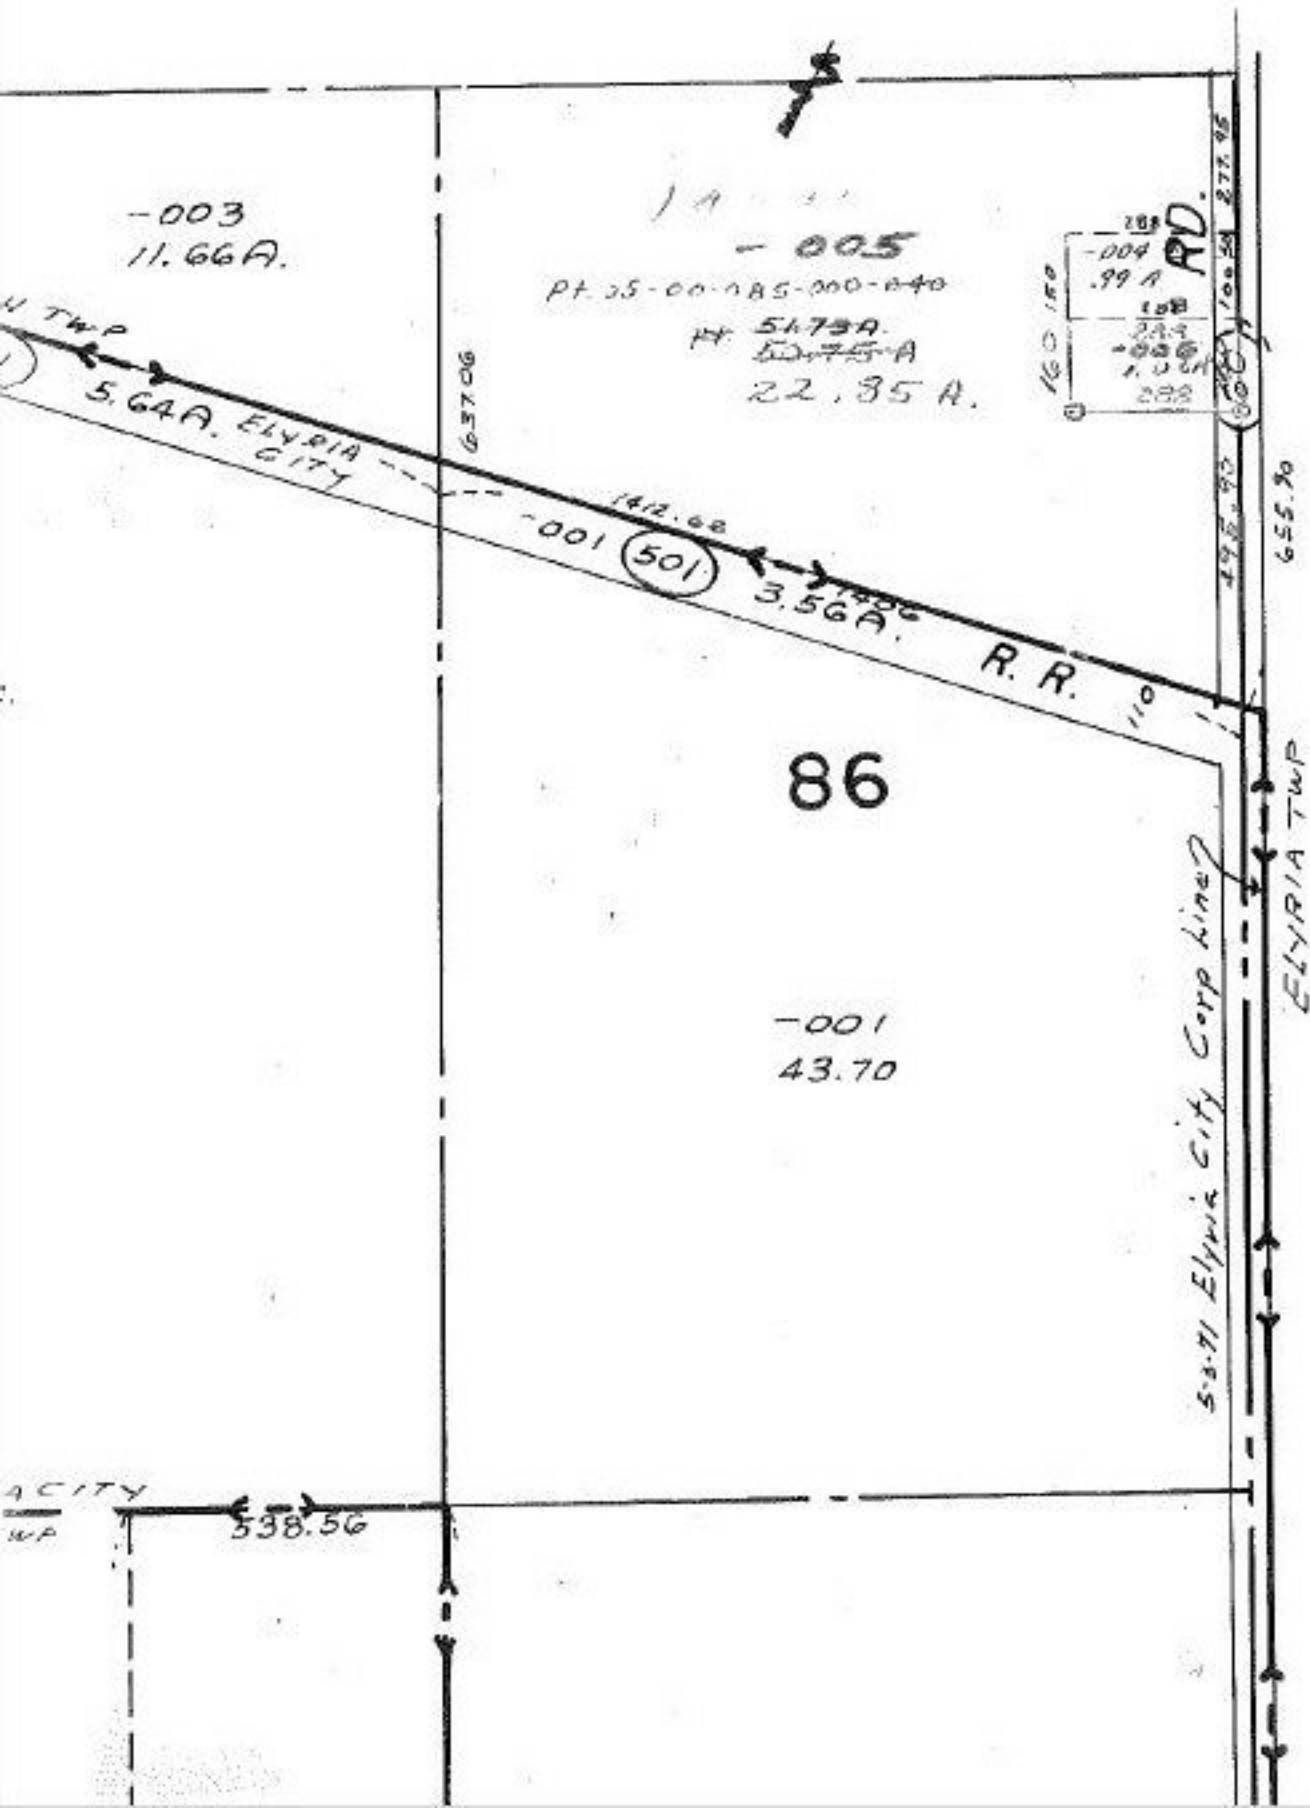

T.M. 1.06  
 4.10.81 22.85  
 26.81  
 50.75

#14030

|                                     |                    |
|-------------------------------------|--------------------|
| APPROVED<br>LORAIN CO.<br>MAP DEPT. |                    |
| DATE                                | 2-3-81             |
| PAGE                                | 5-H                |
| BY                                  | <i>[Signature]</i> |
| VOID<br>AFTER                       | 14030              |