

#14033


.06
- .01

.05 AC.

SEE 6-101

NORTH ST.


LOB

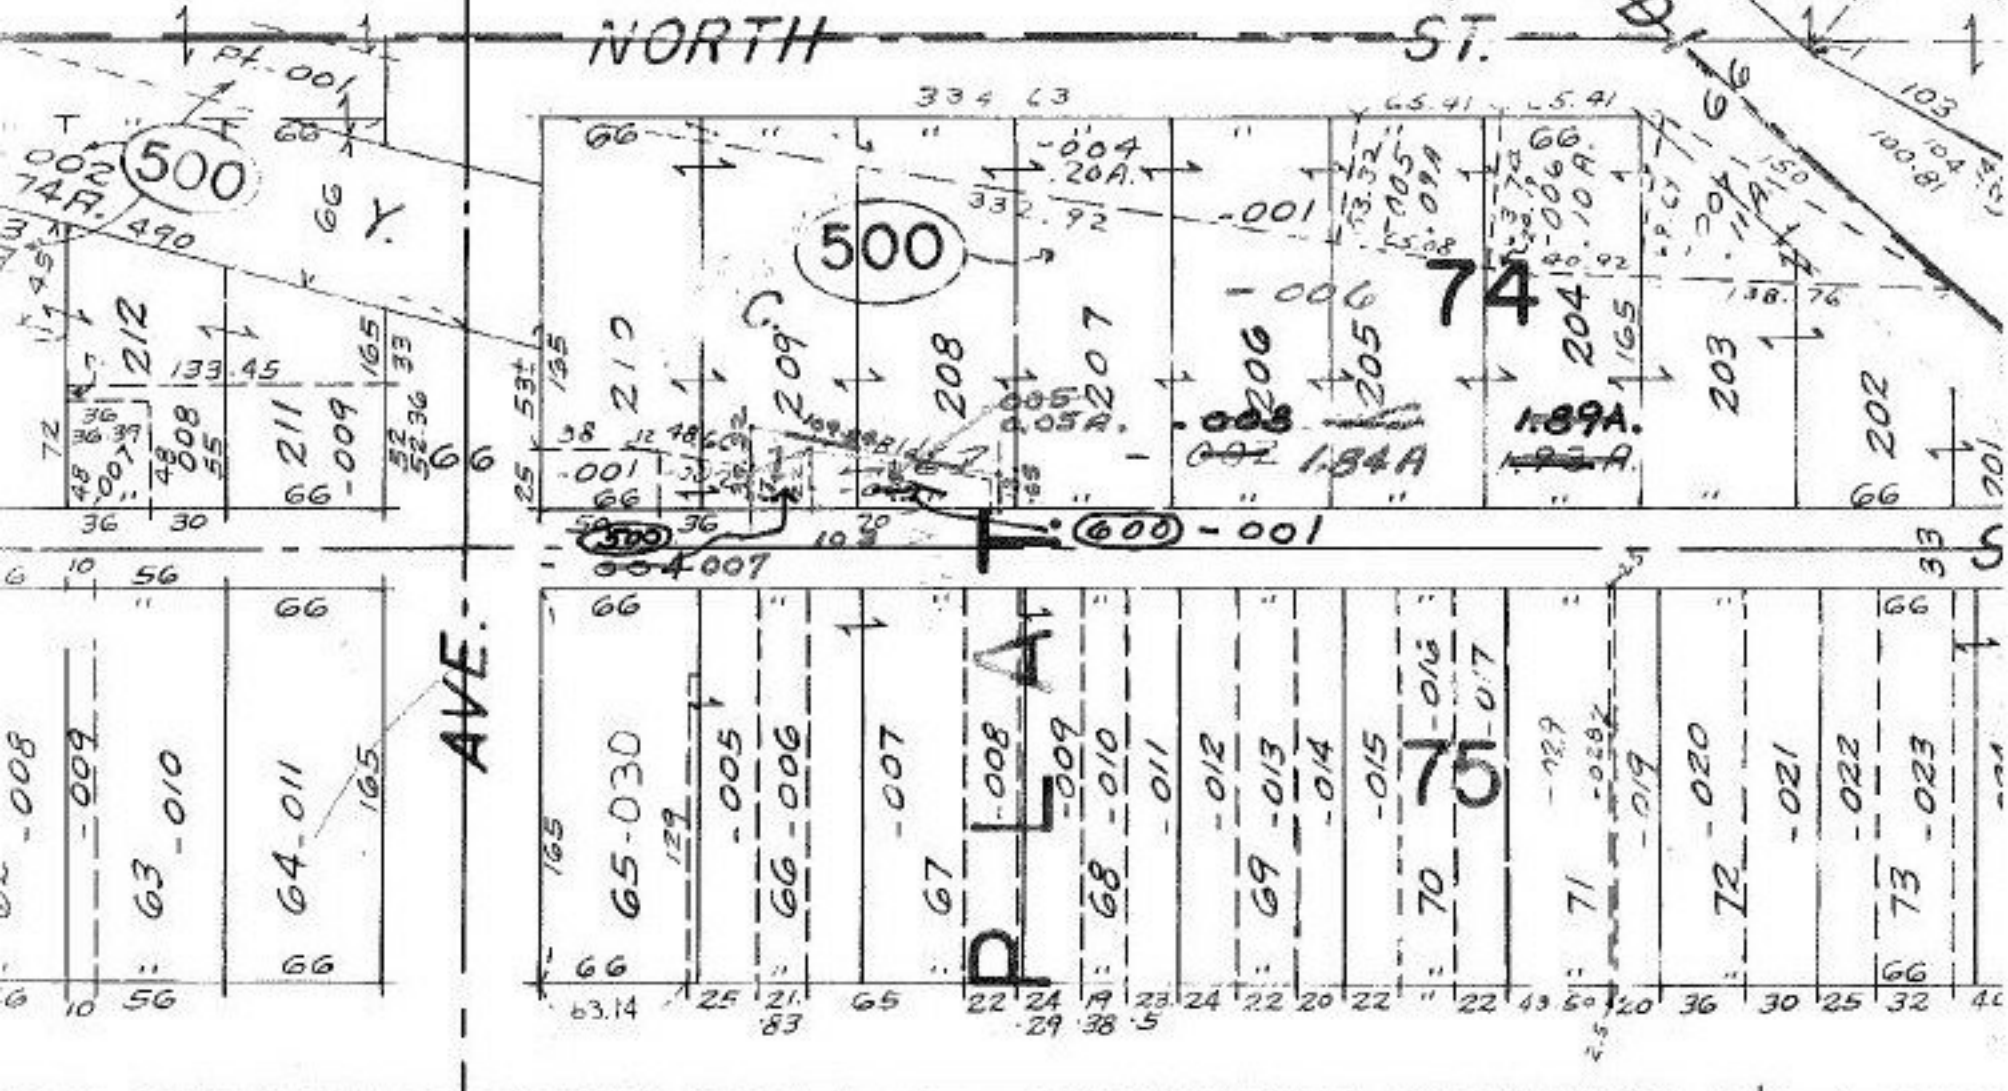

AVE.

P L A

74

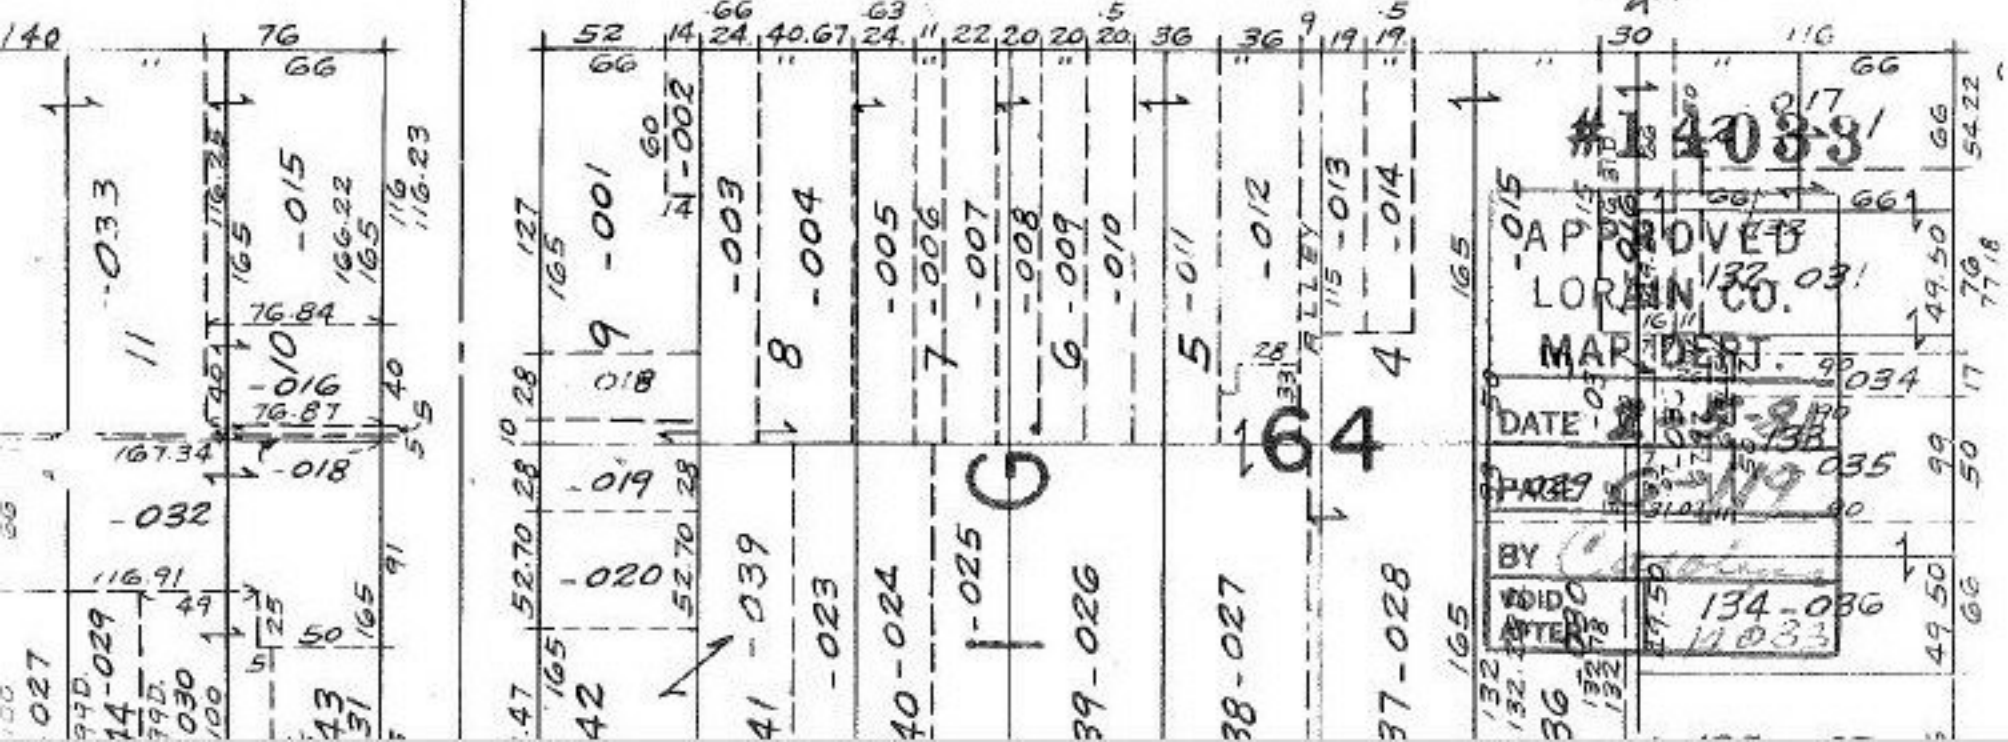

T.M. 4-16-81

#14033

APPROVED
LORAIN CO.
MAY 1981
DATE
BY
134-036
11033