


#14034

SEE

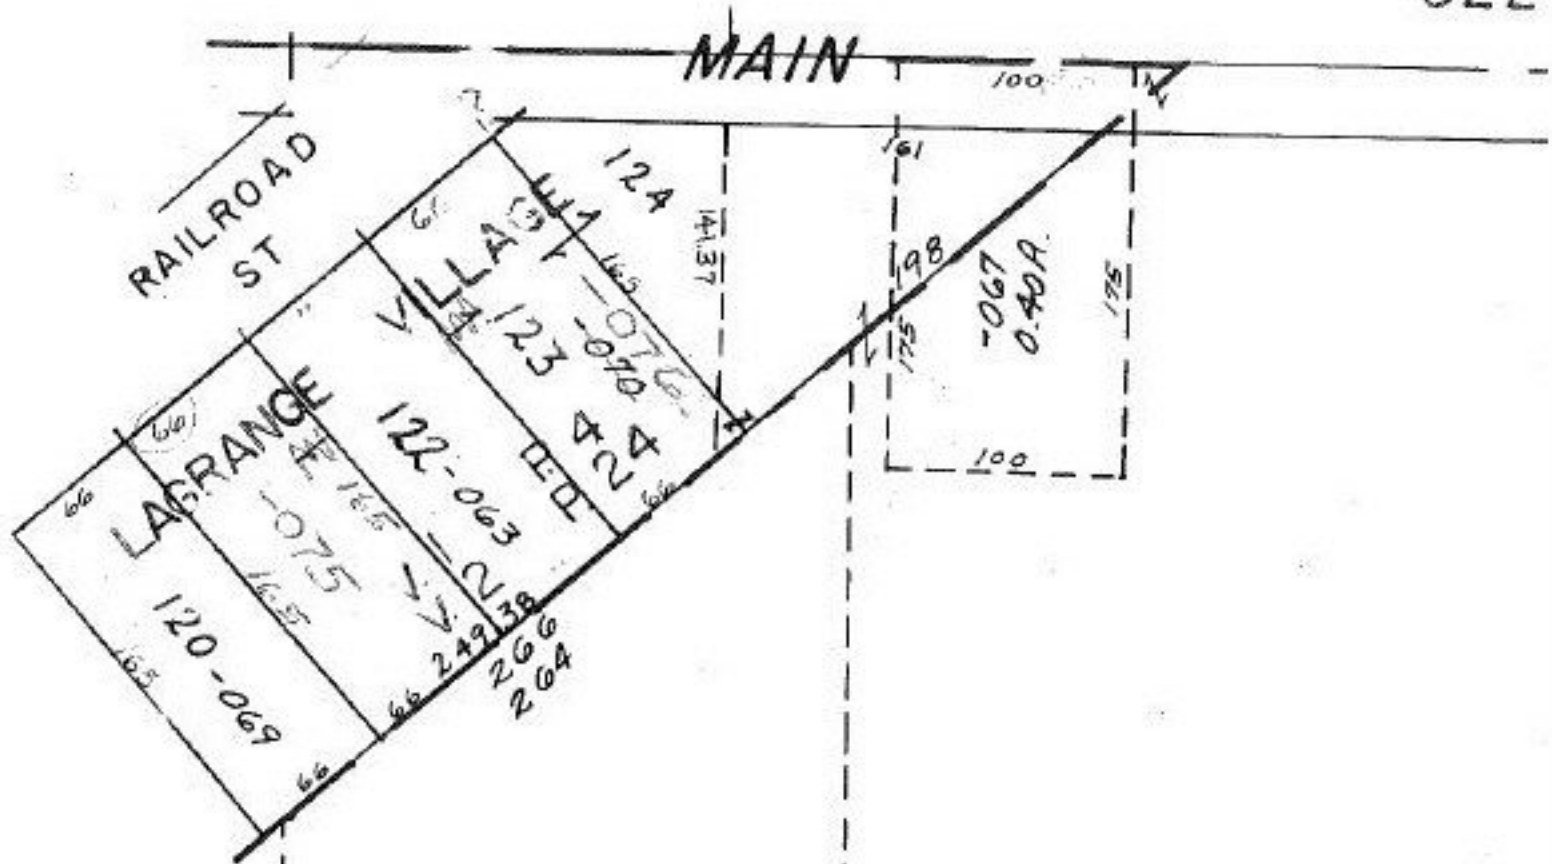

#14034

APR 10 1981

*Handwritten signature*

APPROVED LORAIN CO. MAP DEPT.	
DATE 2-6-81	
PAGE 15-00-053 - B	
BY Carolyn J. [Signature]	
VOID AFTER	14034