


#14042

SEE 9-00-08

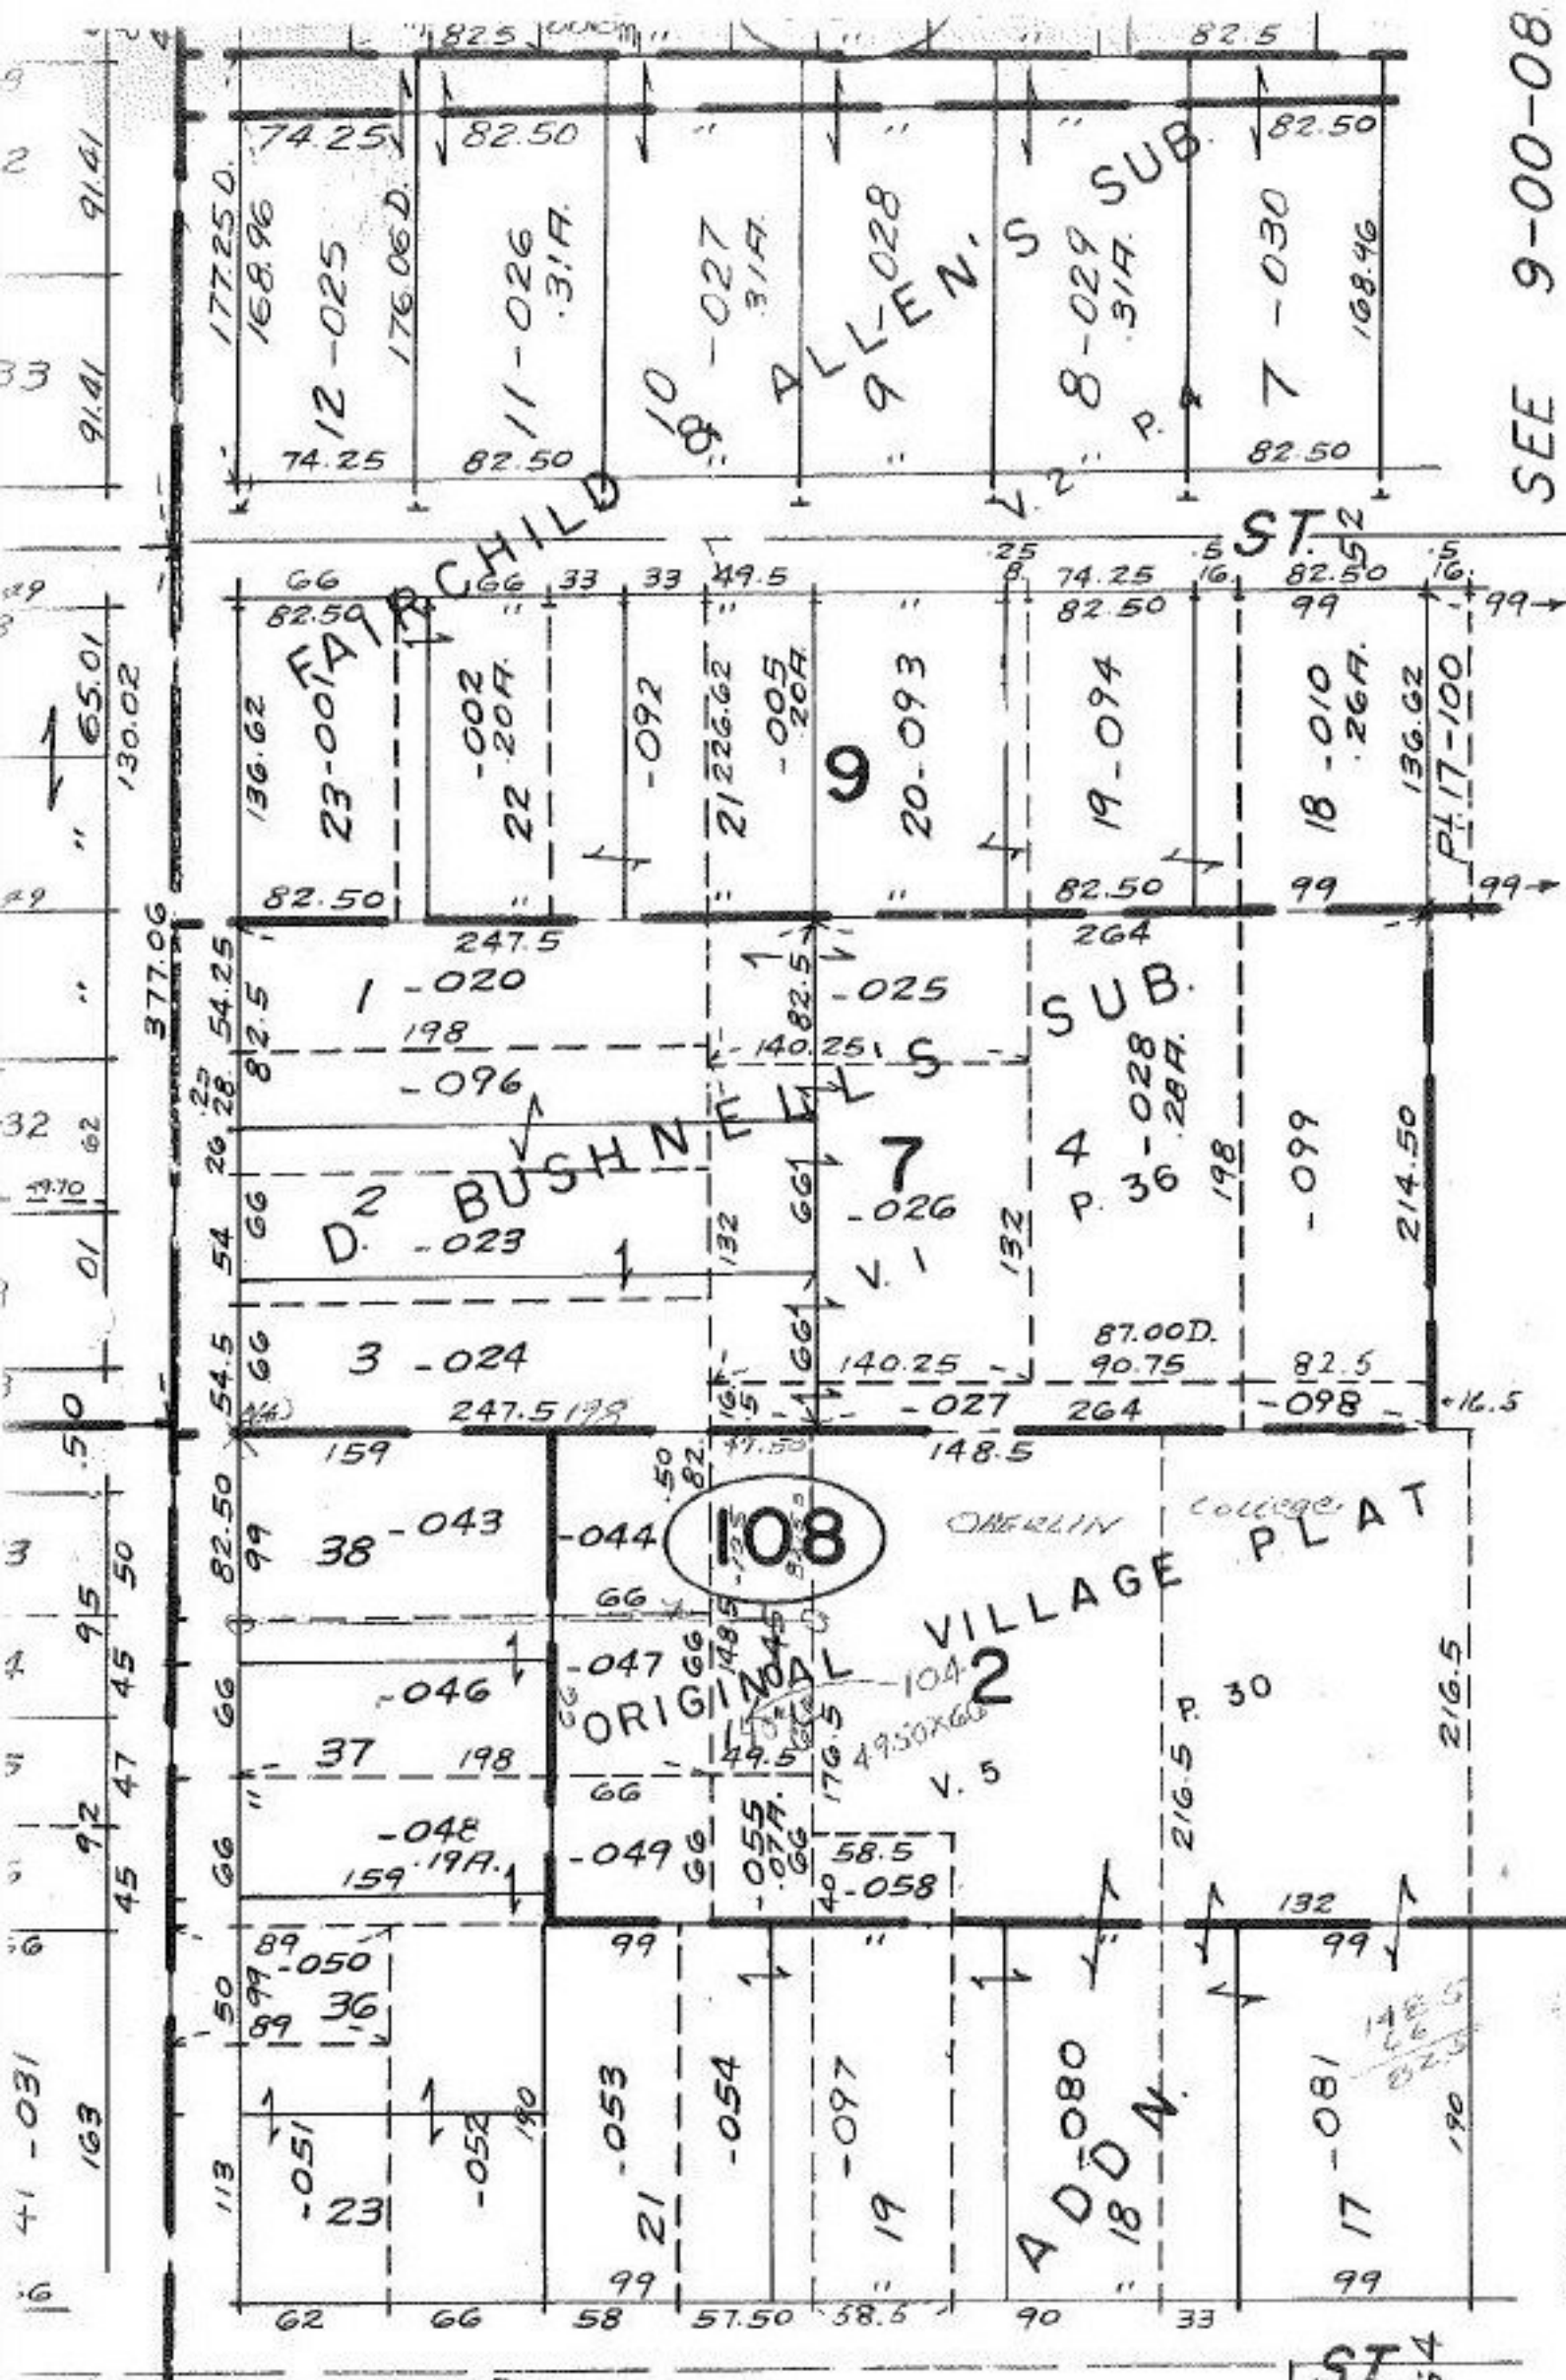

T.M.
4-16-81

#14042

APPROVED	
LORAIN CO.	
MAP DEPT.	
DATE 2-17-81	
PAGE 09-00-085-1	
BY Carolyn J.	
VOID AFTER	14042

ST. 54