


#14050

-016  
79.42 AC

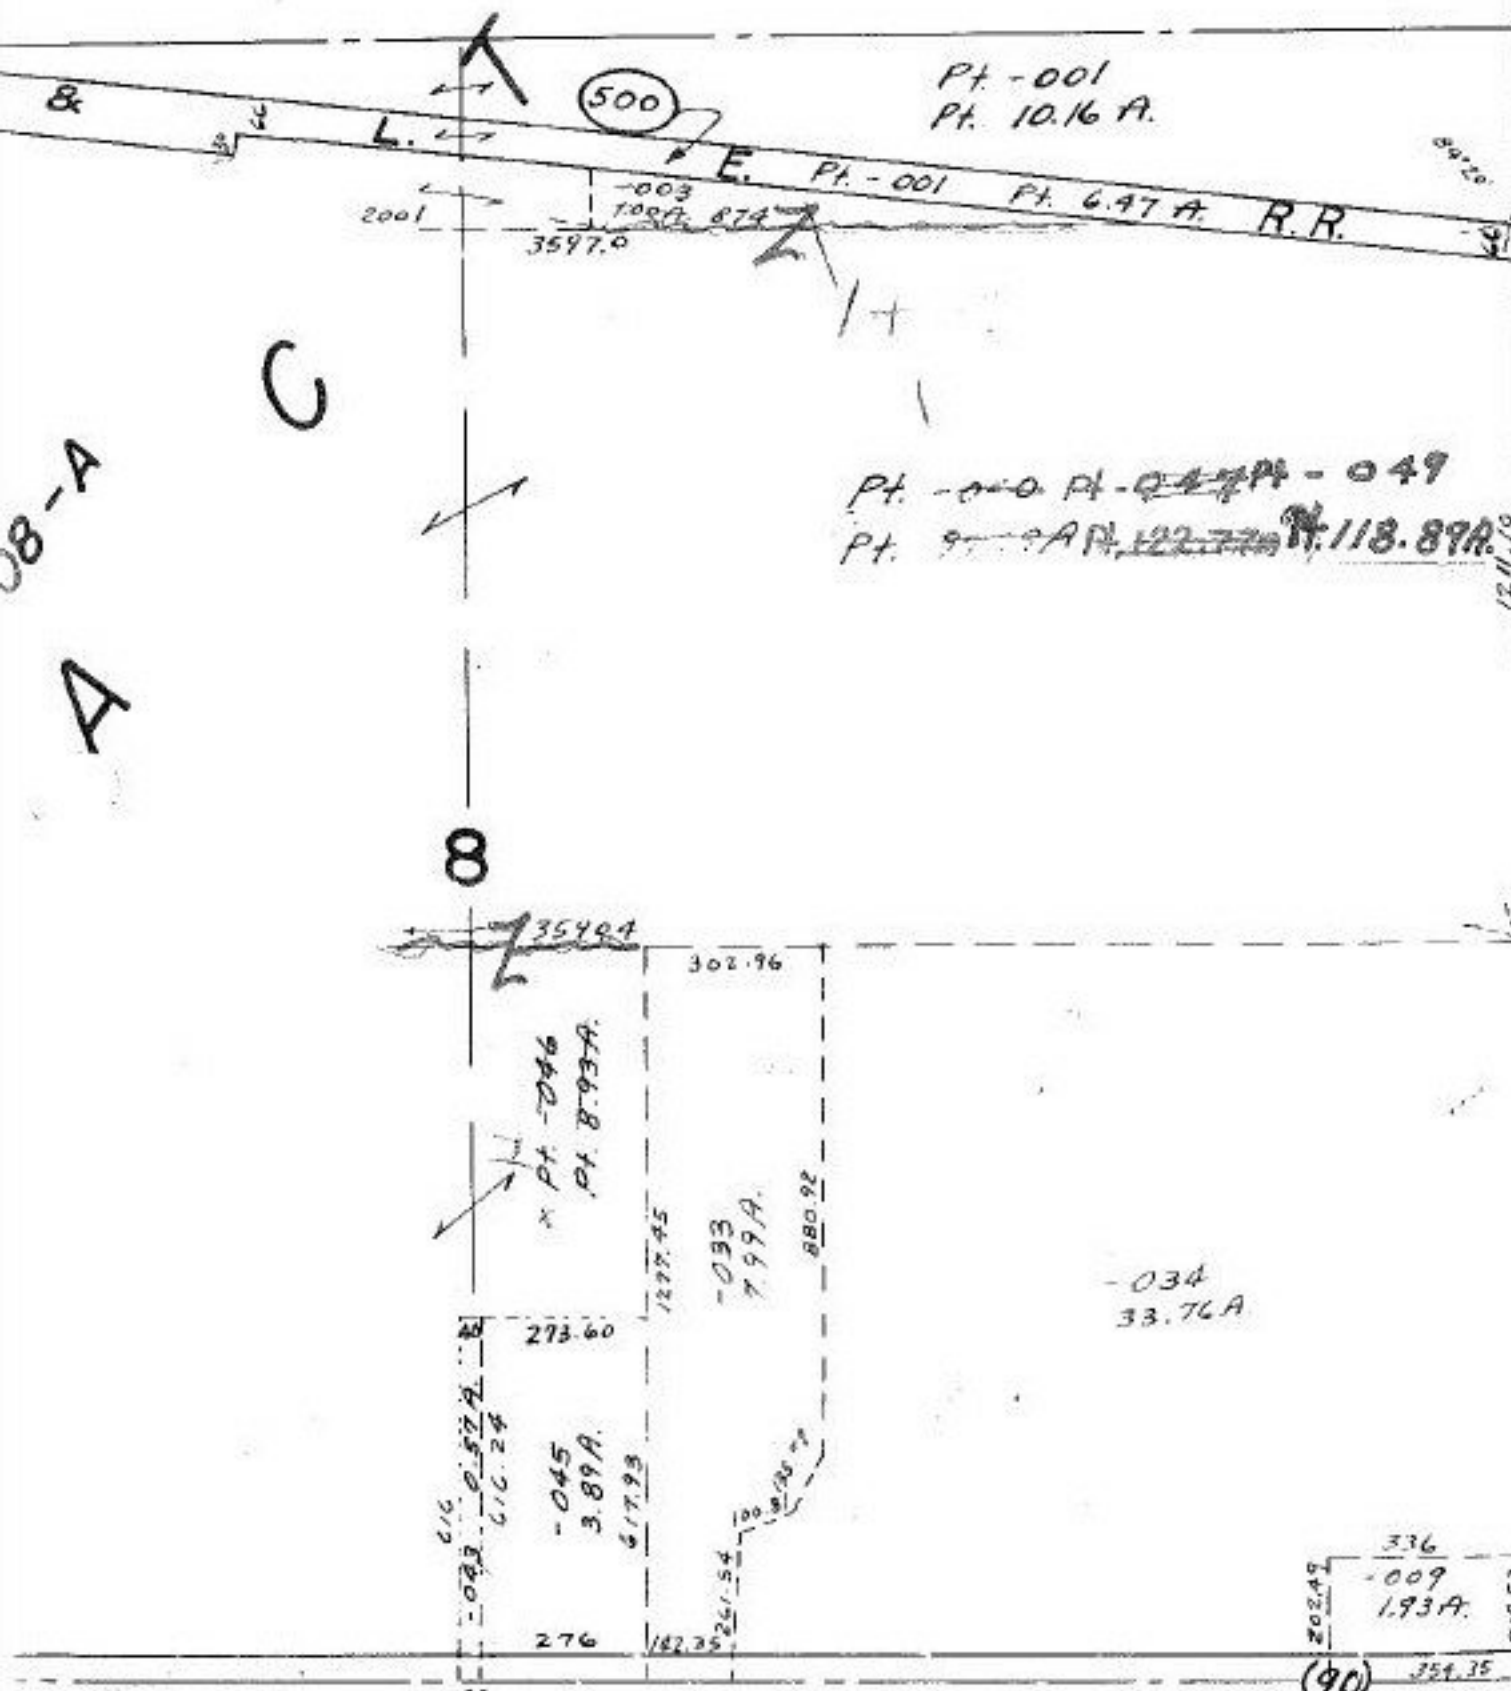

08-A  
A

C

8

MAR 23 1981

#14050

APPROVED LORAIN CO. MAP DEPT.	
DATE 02-18-81	
PAGE 17-C 17-01-008-0	
BY Carolyn	
VOID AFTER	14050

WALK

RD.

18

TRACT 7 LOTS 3, 8  
 " 8 " 23, 24, 31